



STERN POST & RUDDER FRAME

26.1.94

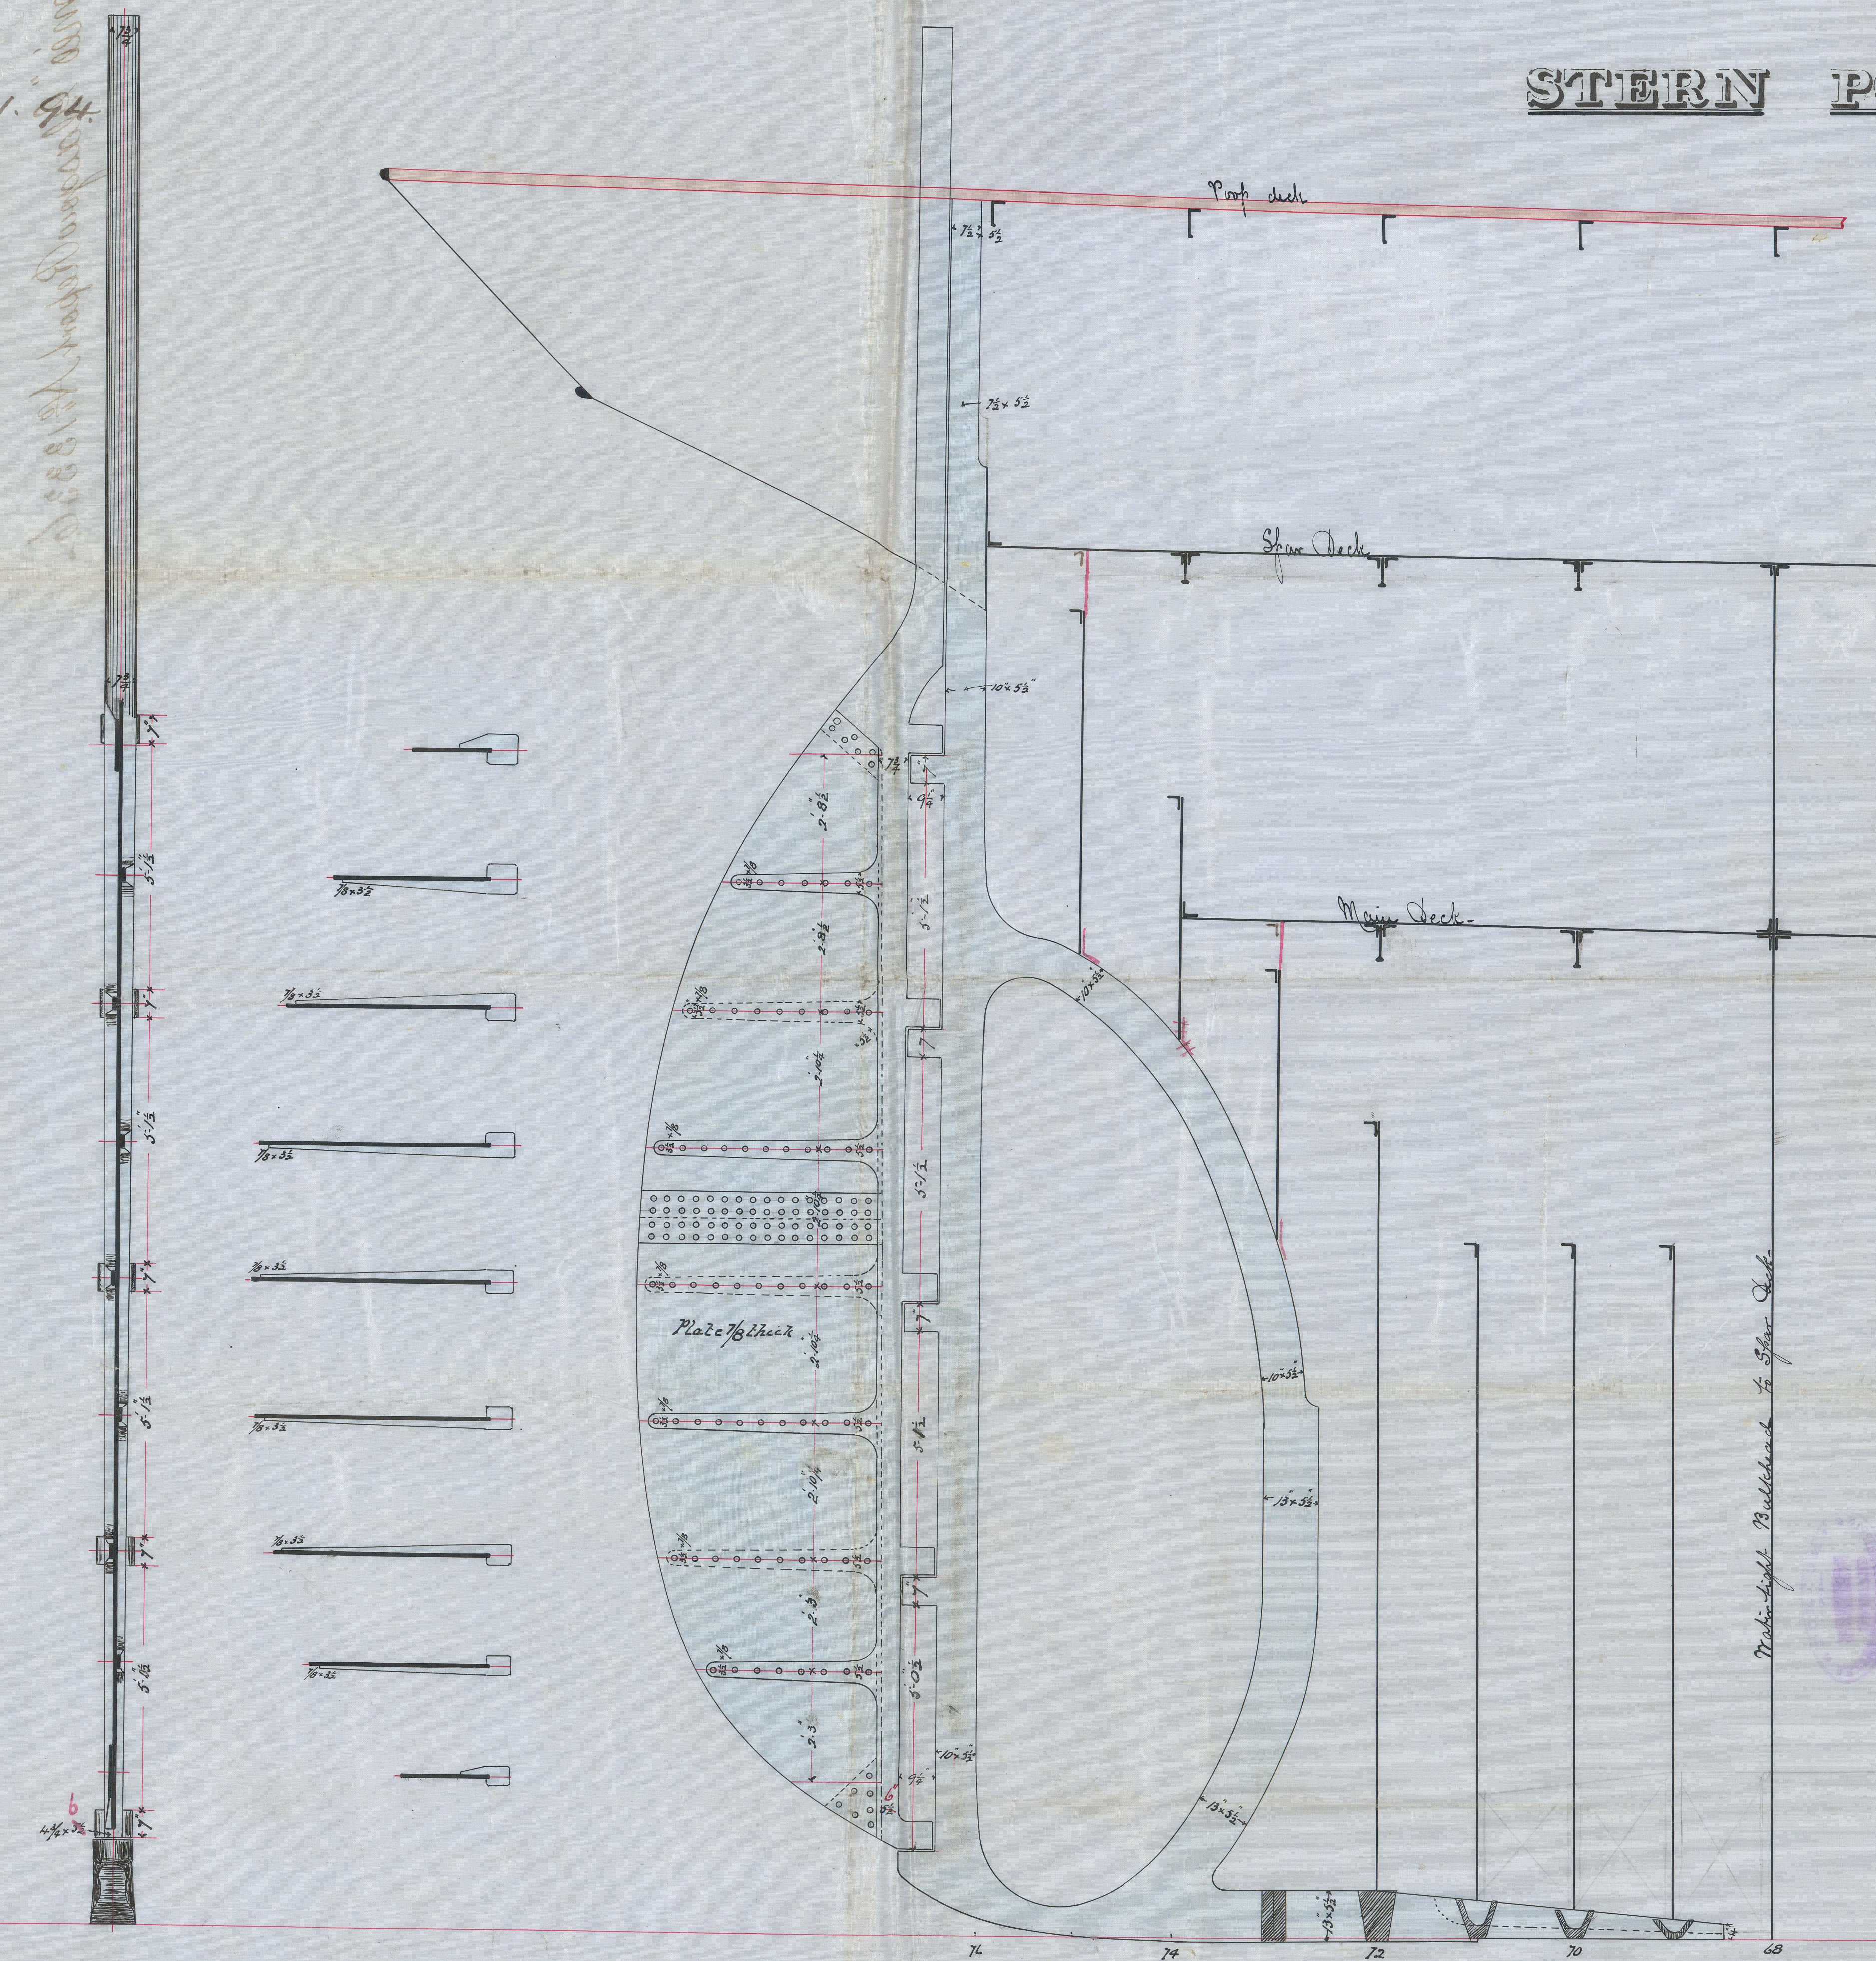

Scale 1/2 inch to 1 foot

Scale 1/2 inch to 1 foot

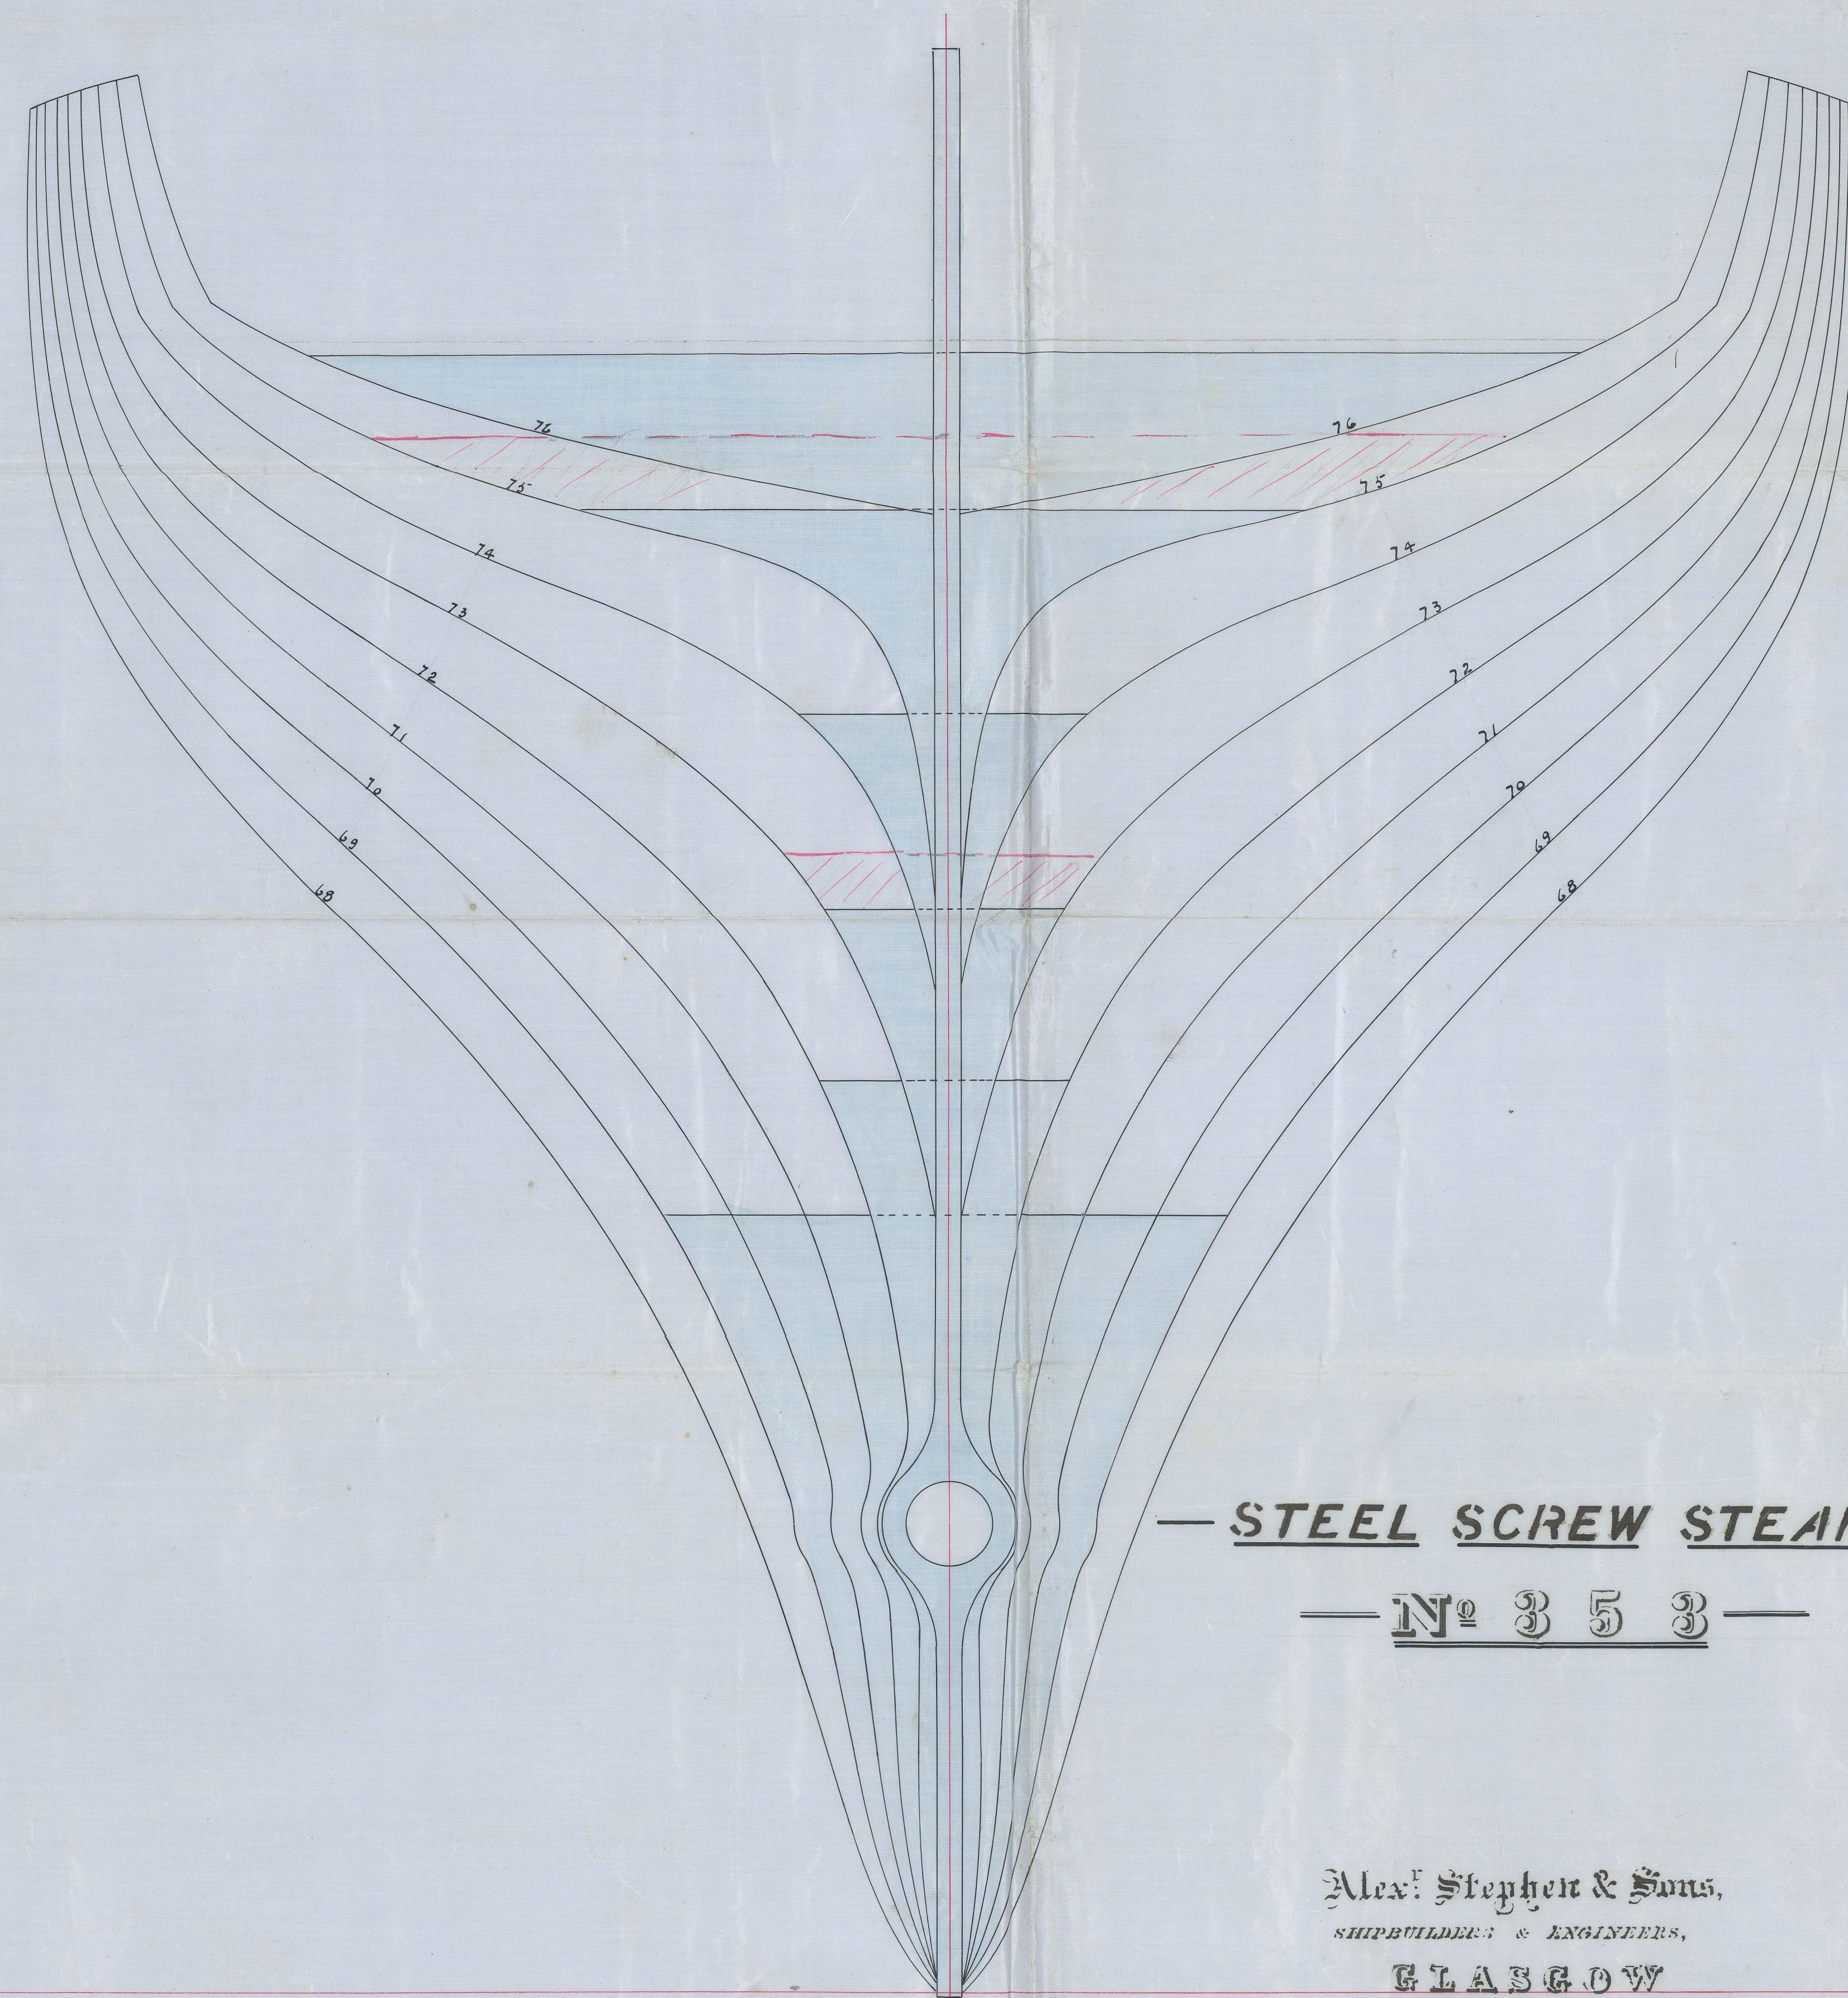

Scale 1/2 inch to 1 foot

— STEEL SCREW STEAMER —

— No 353 —

Alex. Stephen & Sons,
SHIPBUILDERS & ENGINEERS,
GLASGOW

DRAWING No 6503


19/1/94
J. J. 20.1.94

307


© 2021

Lloyd's Register
Foundation

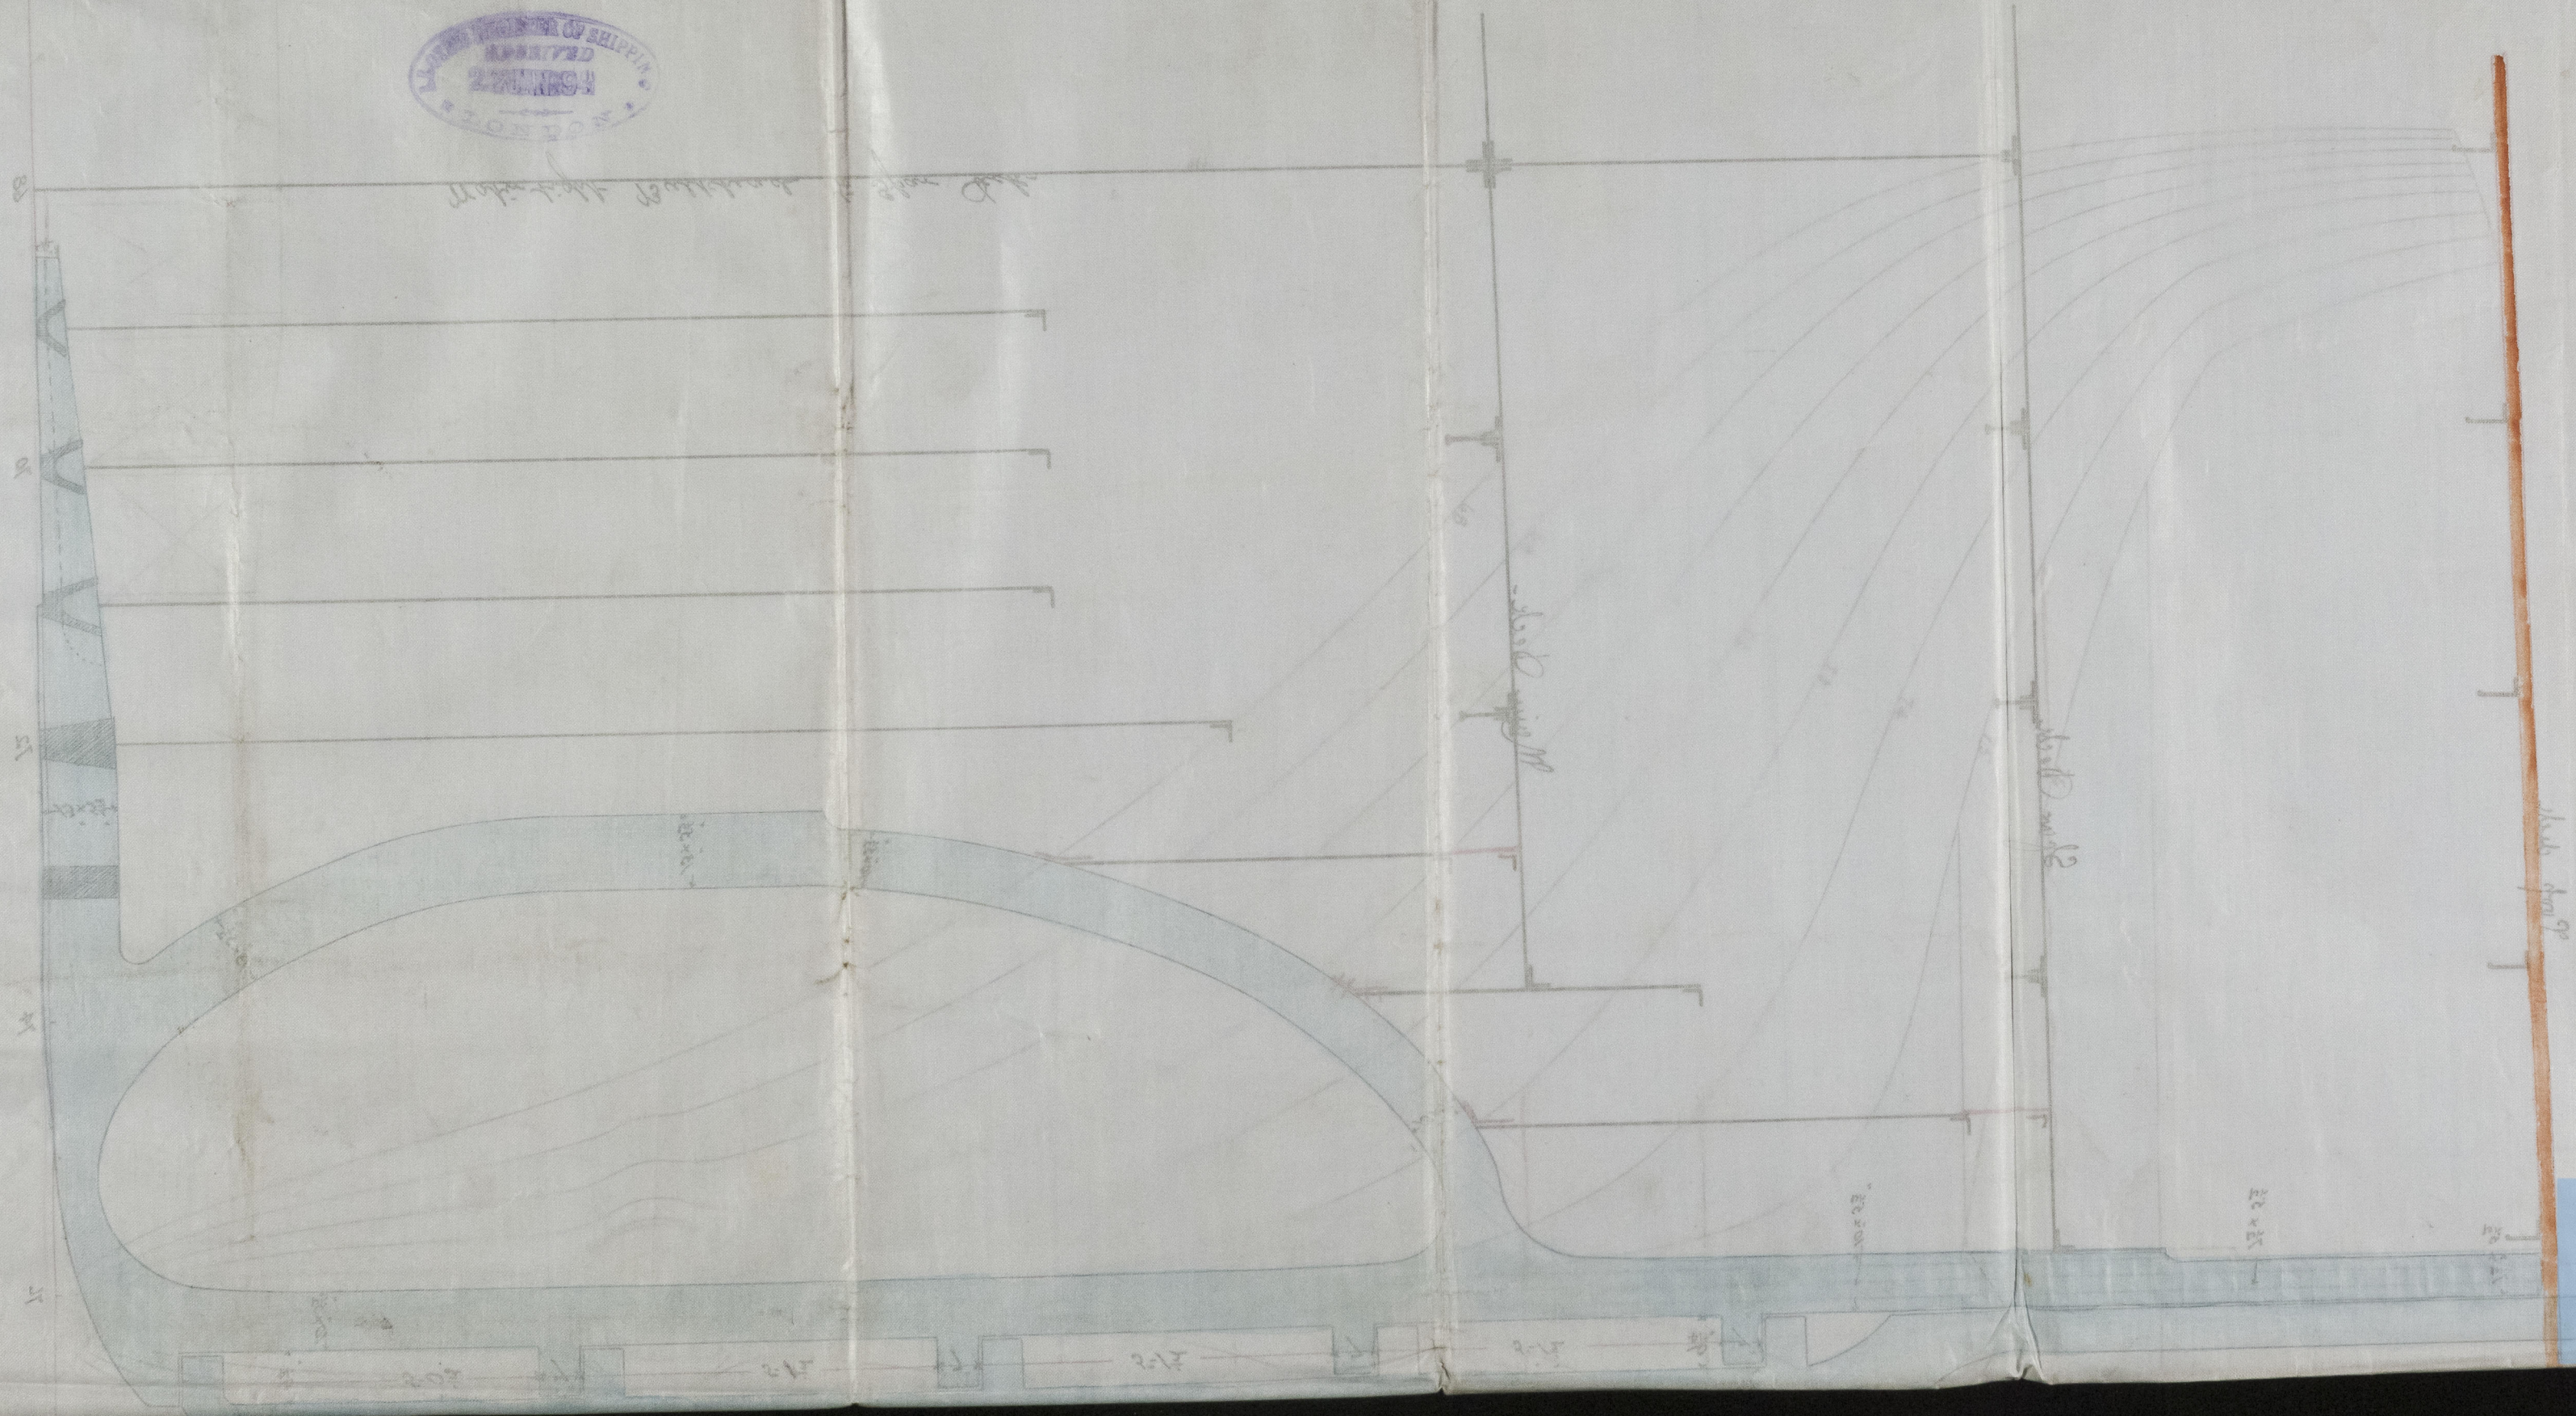

SS "Dionée" Glasgow Report N^o 13336.



© 2021

Lloyd's Register
Foundation