

22 James Watson Report 171030



Sluice valves dispensed with at owners request
Working barrels of hand pumps not to exceed 24 ft from rose box



DRAWING № 6637

W.A.
10.4.94

"
S & D'Onio "Glasgow Report No 13336-

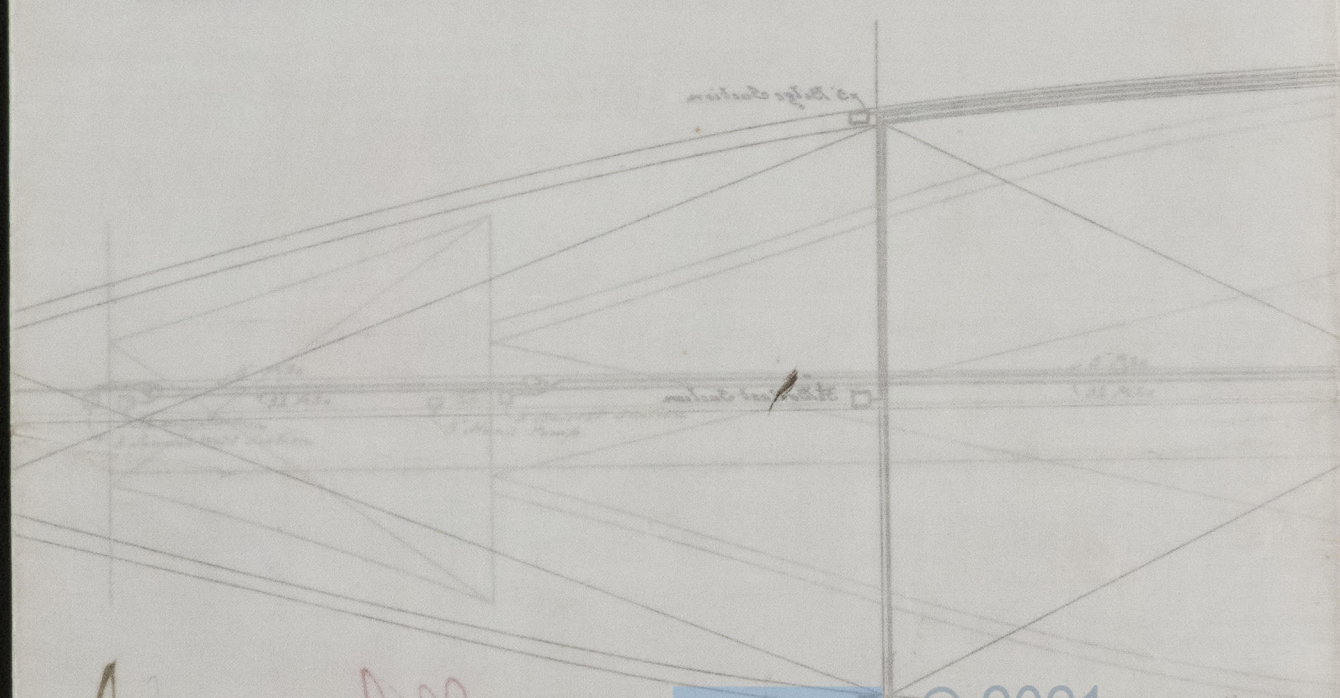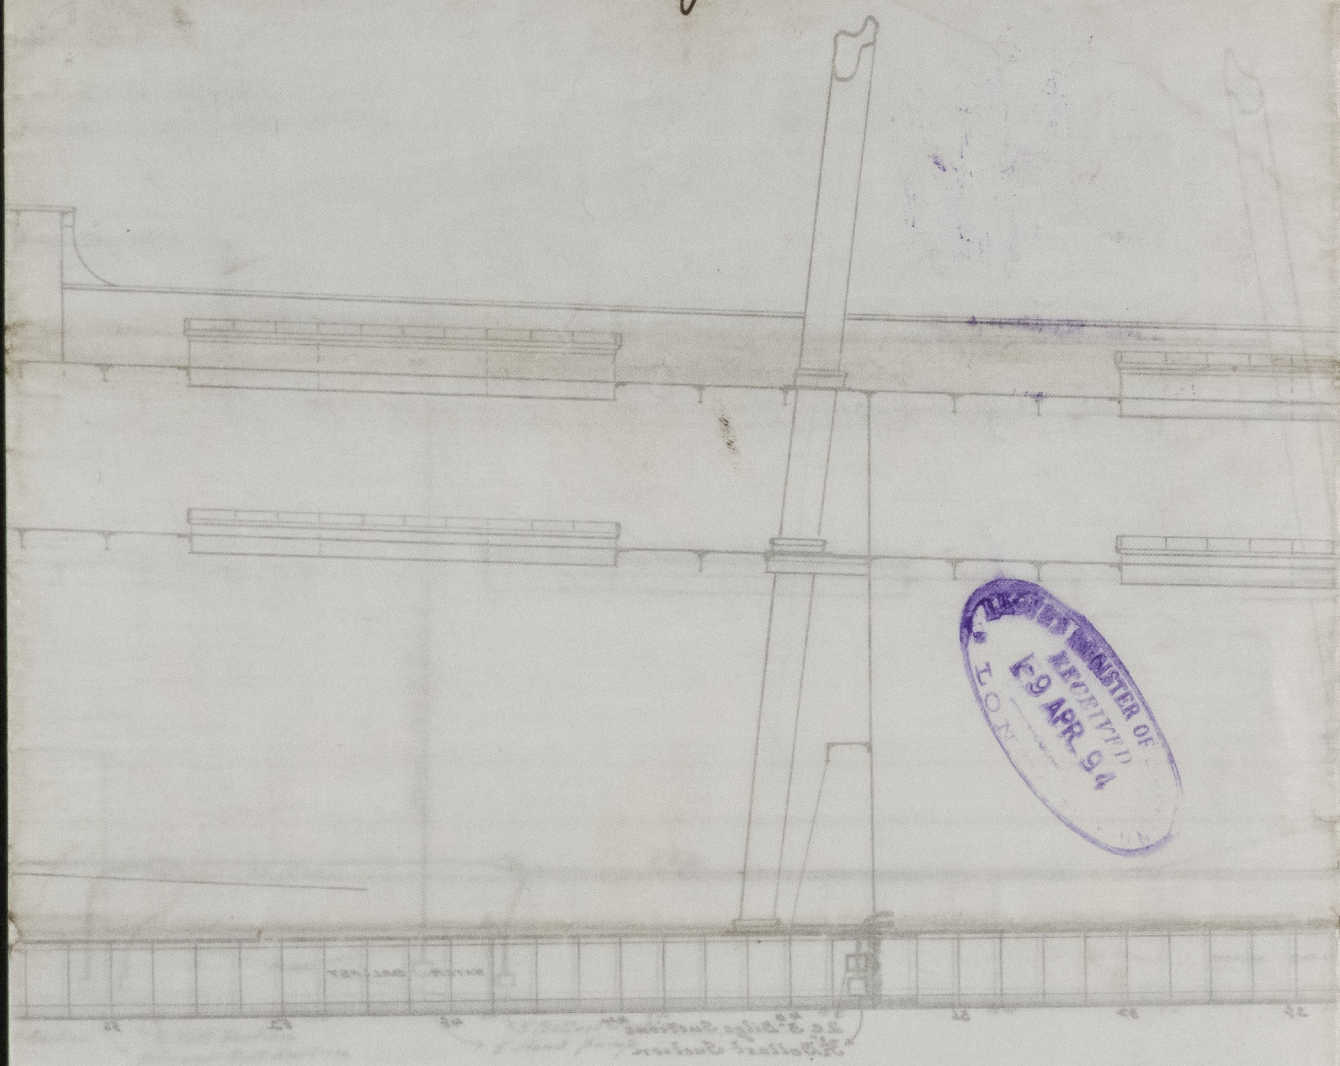

10.11.01
10.11.01
10.11.01



© 2021

Lloyd's Register
Foundation

GLS245-0060