


10.4.94

Alex. Stephen & Sons,  
SHIPBUILDERS & ENGINEERS,  
GLASGOW

DRAWING No 6636

6/4/94  
WAB

— STEEL MASTS —  
— STEEL SCREW STEAMER —  
— No 353 —  
77-0

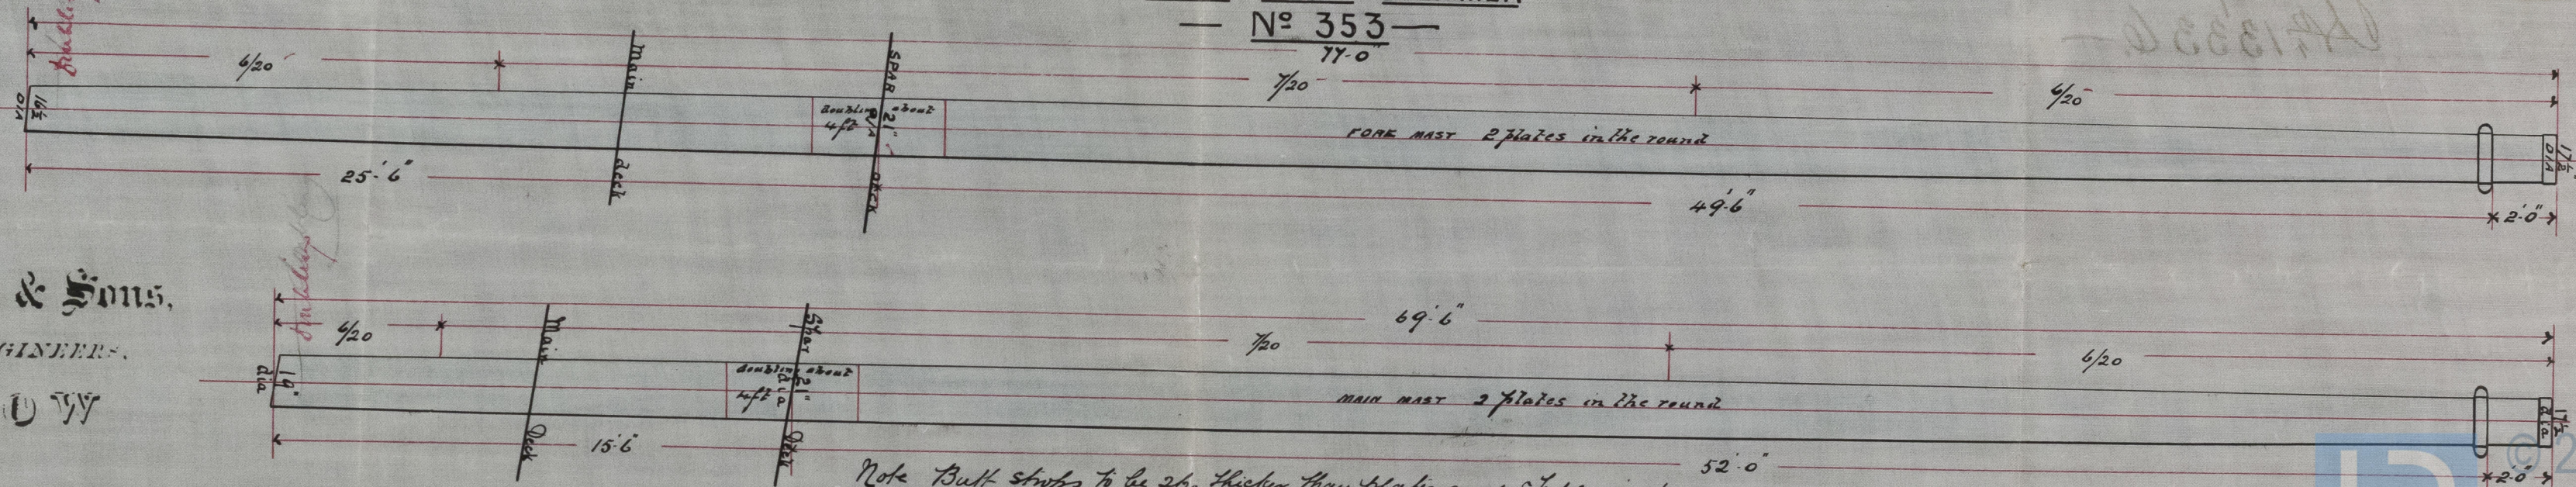


SCALE  $\frac{1}{4}$  INCH TO A FOOT

© 2021 Lloyd's Register Foundation  
7/4/94




S. S. "Dionée" Glasgow Report  
 No. 13336.

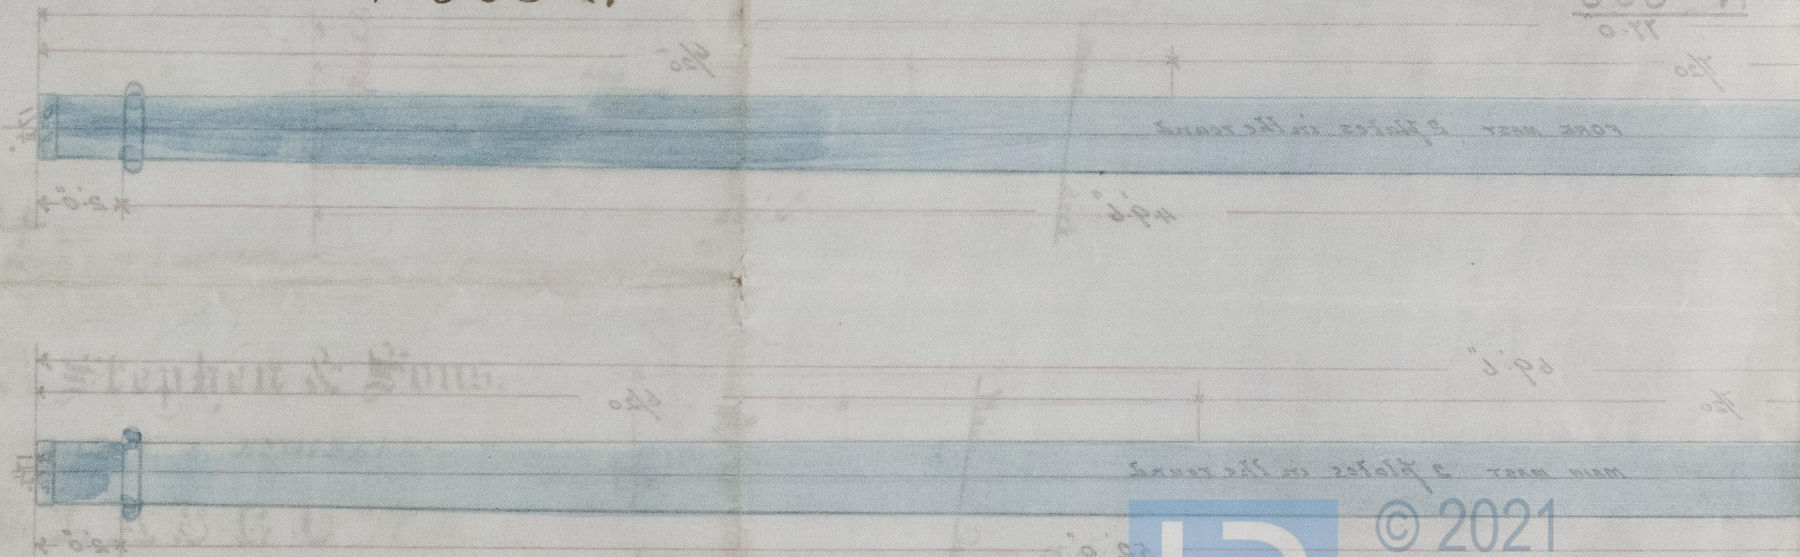

SCALE 1/4 INCH TO A FOOT

GLS245-0061

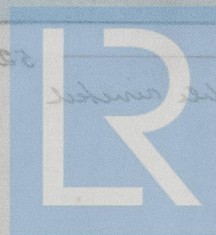

© 2021

Lloyd's Register  
 Foundation