

Lloyd's Register of British and Foreign Shipping.

(Report on Vessel No. 13336 Port Glasgow)No. 4436 SHIP FORGINGS ~~OR CASTINGS~~

I have to report that the undermentioned Iron ~~or Steel~~ Forgings ~~or Castings~~,
 manufactured by Messrs. Alexr. Stephen & Sons
 of Glasgow for the Vessel No. 353, being built
 by Them of

have been inspected by me as set forth below, and found to be, so far as can be seen,
Sound & efficient

Mark on Forgings.

Lloyd's

No. 4436

W. H.


William Hamilton

Glasgow

26/9/94

	STERN FRAME.	RUDDER FRAME.	STEM.
Material*	...	Scrap iron	Scrap iron
How made	...	Forged	Forged
Dimensions	...	7 3/4 to 4 in.	10 x 2 1/2
Progress on Inspection	...	Forging & smithing	Forging
Date when Inspected	...	22/2/94. 2-6. 10. 15. 26 22. 23. 28/3/94. 4. 9. 11. 16/4/94. 2. 8. 27/8/94. 5.	12. 11/4/2/94 6/3/94

SKETCHES OF FRAMES SHOWING POSITION AND DESCRIPTION OF WELDS OF FORGINGS, OR PARTICULARS OF
 TESTS APPLIED TO CASTINGS. 17. 19/22/9/94

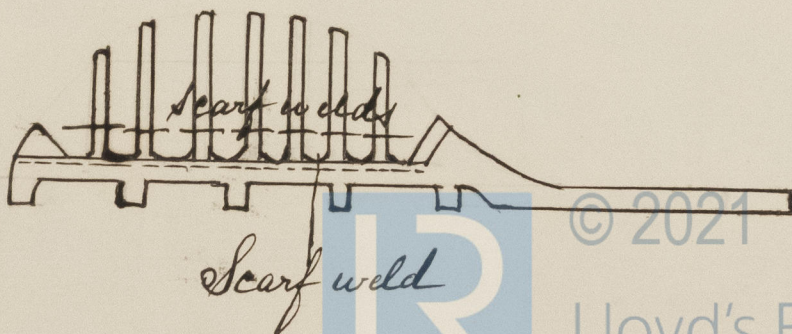

* If of Iron, state whether scrap or puddled Iron.