


9.4.94

ARRANGEMENT OF BULKHEAD STIFFENERS

S. S. No 377

SCALE 1/4" = ONE FOOT

WITH STIFFENERS ALL ON ONE SIDE

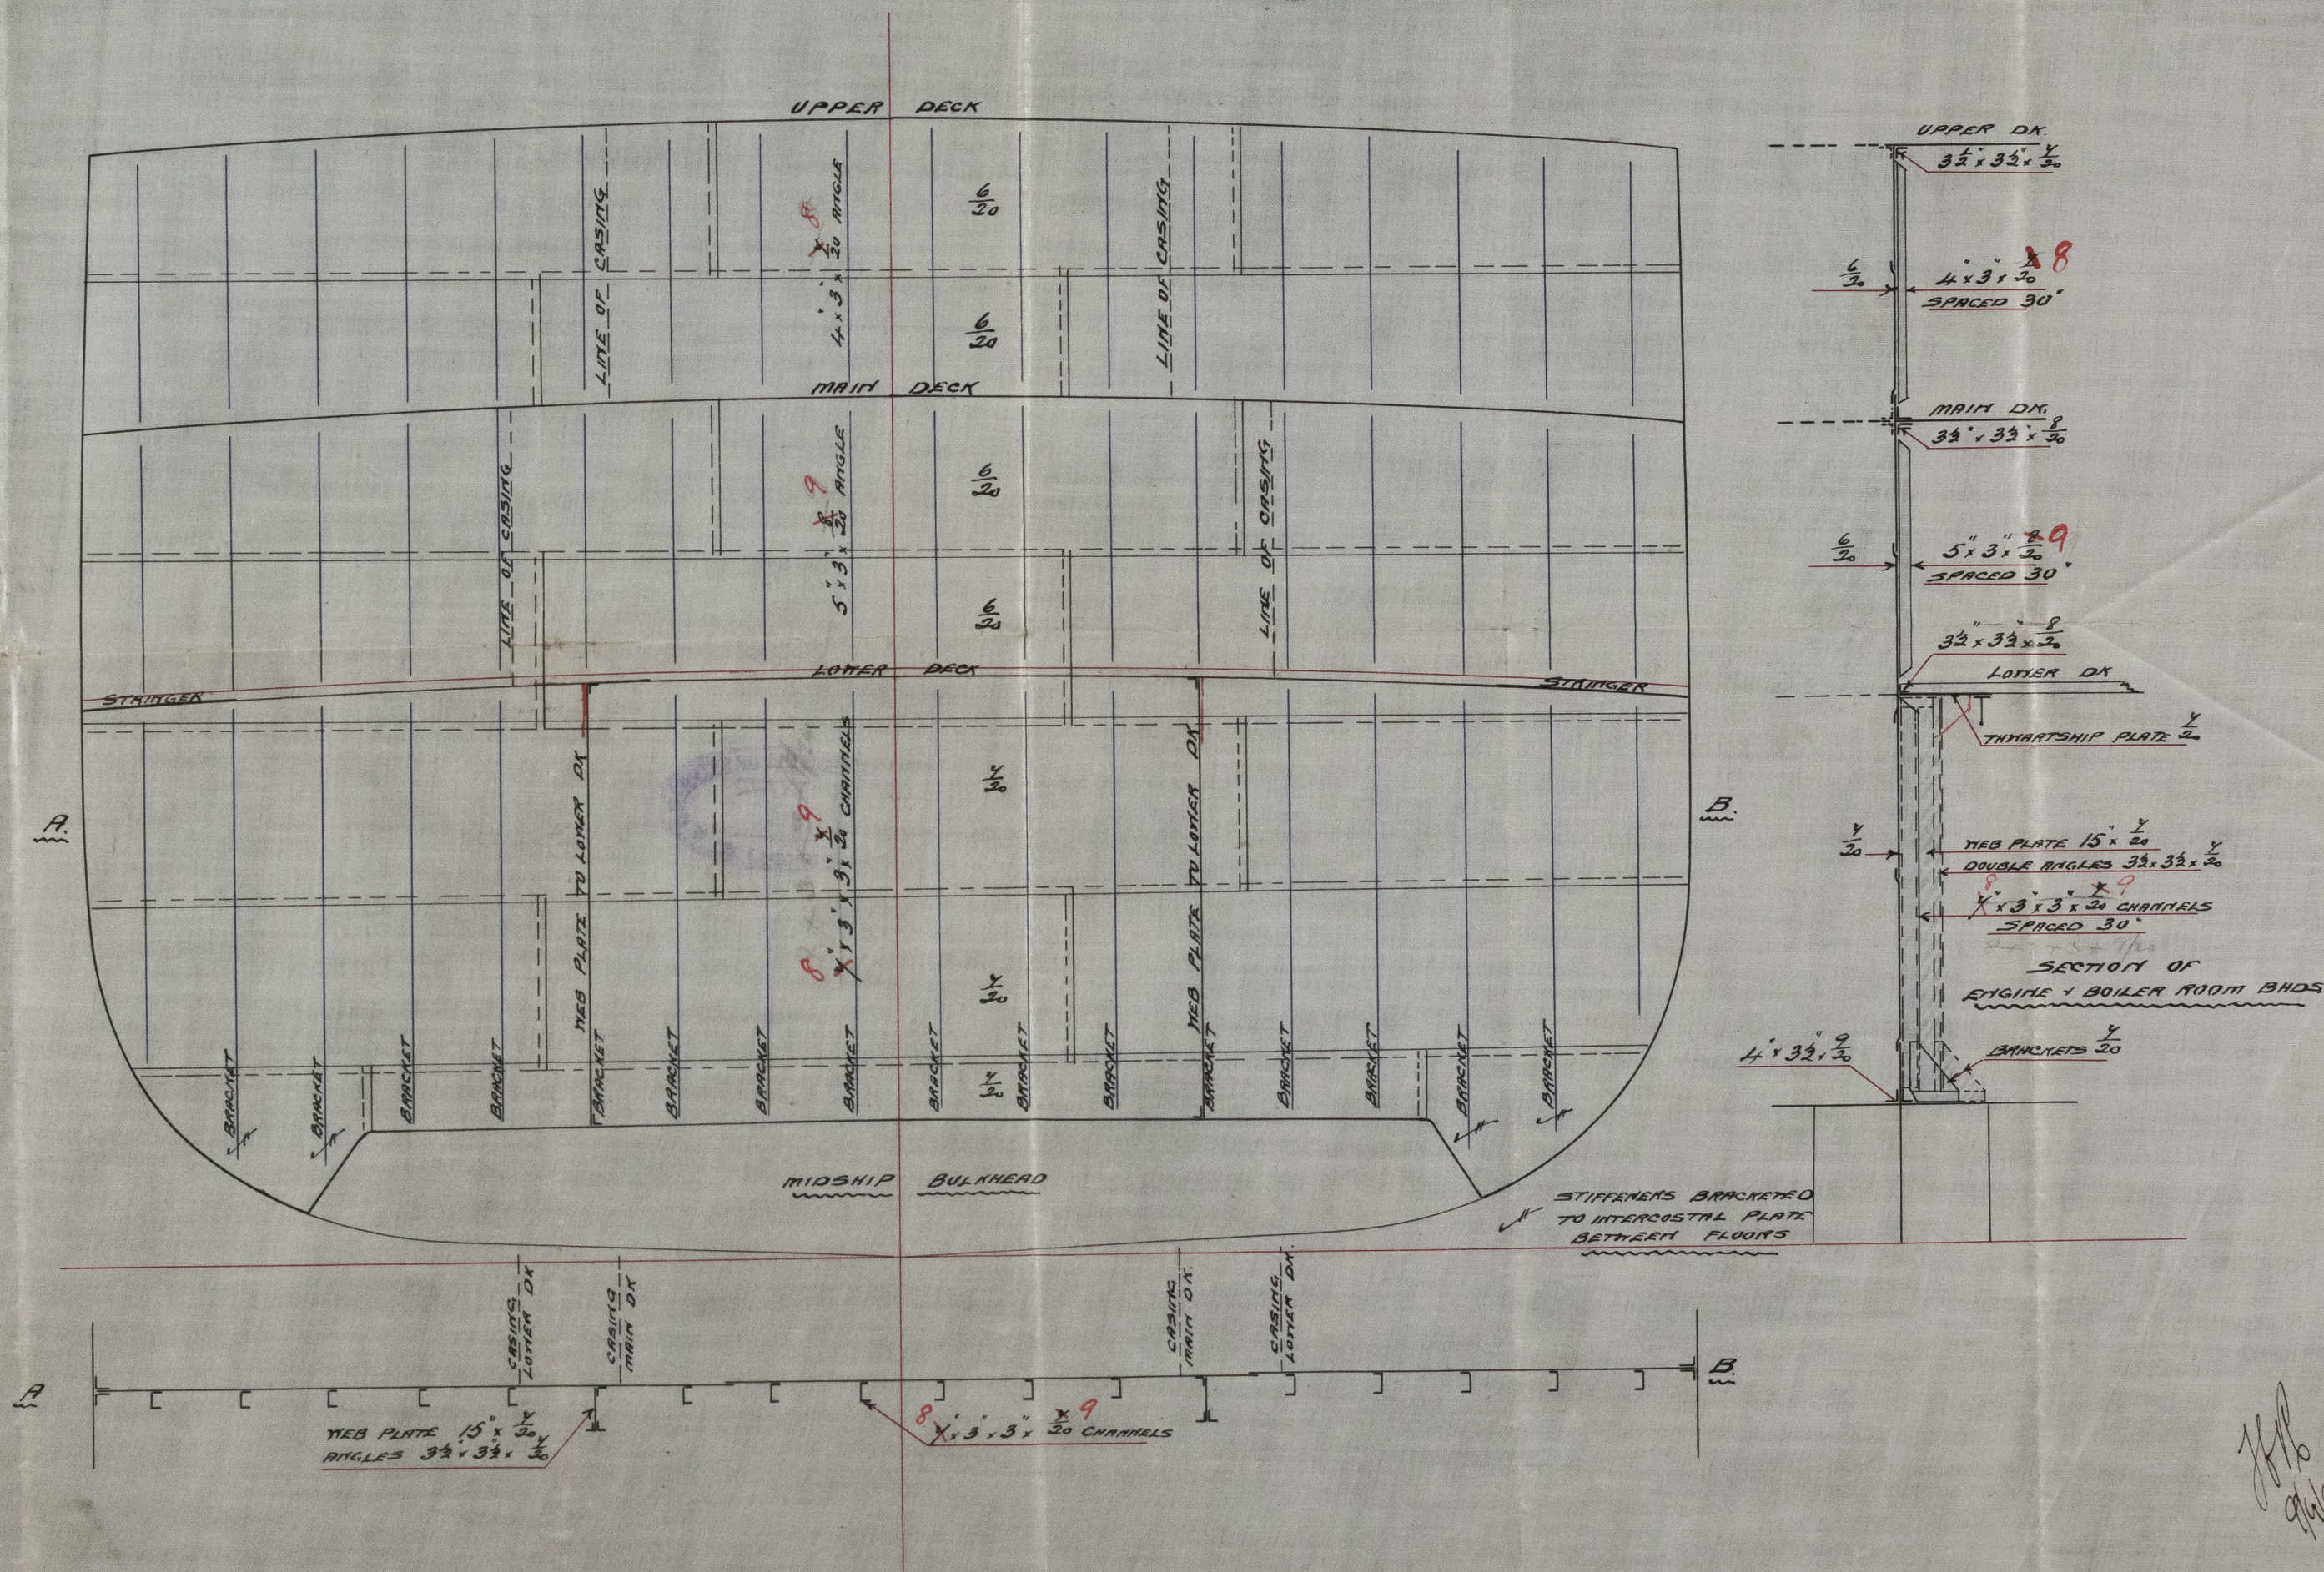

B.6848


A.S.P.



© 2021

Lloyd's Register Foundation

0410-542523

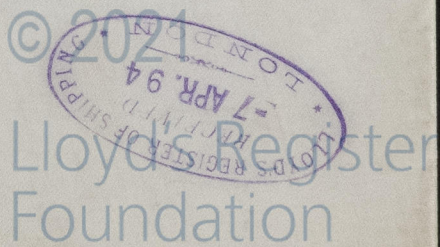

Lloyd's Register
Foundation

GL5245-0140