

(Report on Vessel No. 13398 Port Glasgow)  
Brundel Castle

SHIP FORGINGS ~~OR CASTINGS.~~

for the Vessel No. 377, being built

have been inspected by me as set forth below, and found to be, so far as can be seen,  
*Sound.*


Lloyd's  
No. 4572  
EC

Frank Cook.

Glasgow. 7/6/94

	STERN FRAME.	RUDDER FRAME.	STEM.
Material* ...	Scrap Iron		Scrap Iron
How made ...	Forged.		Forged.
Dimensions ...	11" X 8"		11" X 3 1/8"
Progress on Inspection	Forged & smithed		Forged & smithed
Date when Inspected	27. 30/3/94. 3. 6. 17. 20. 24		30/3/94. 10. 13. 24 30/4/94
	27. 30/4/94. 2. 8. 15. 23. 26		8. 9/5/94.

SKETCHES OF FRAMES SHOWING POSITION AND DESCRIPTION OF WELDS OF FORGINGS, OR PARTICULARS OF TESTS APPLIED TO CASTINGS.

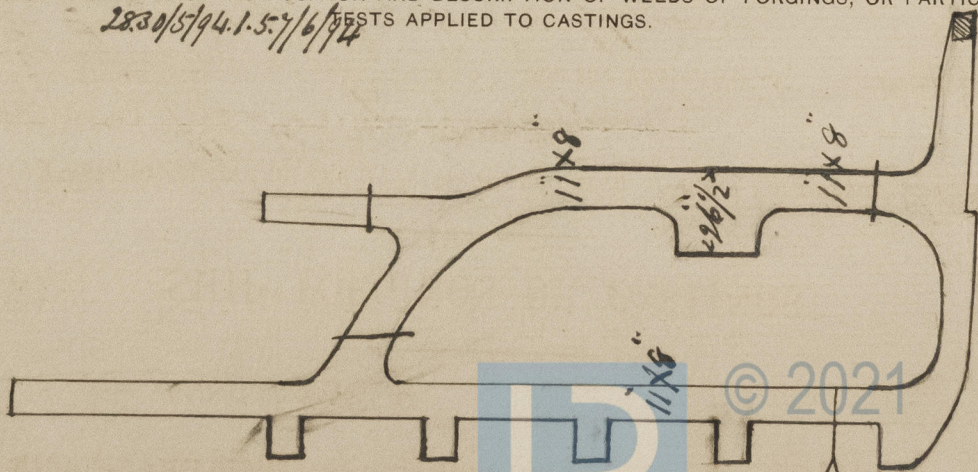

© 2021

*Chit-Welds.*