


S. S. No. 377

HORIZONTAL STIFFENERS TO BE BULB ANGLE & BRACKETED TO SHELL PLATING
WHERE BULKHEAD IS 40 FT. BROAD & ABOVE AT LOWER DECK.
FRAMING NUMERAL 96.66 PLATING NUMERAL 39.936. PEAK BHD. TO RULES.


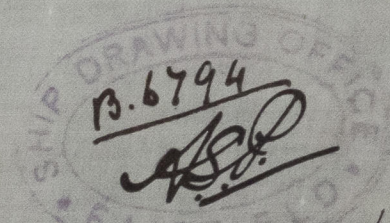


22/9/94

S S "Brundel Castle" Glasgow Report
No 13398. —

7.7.94

45245-0151

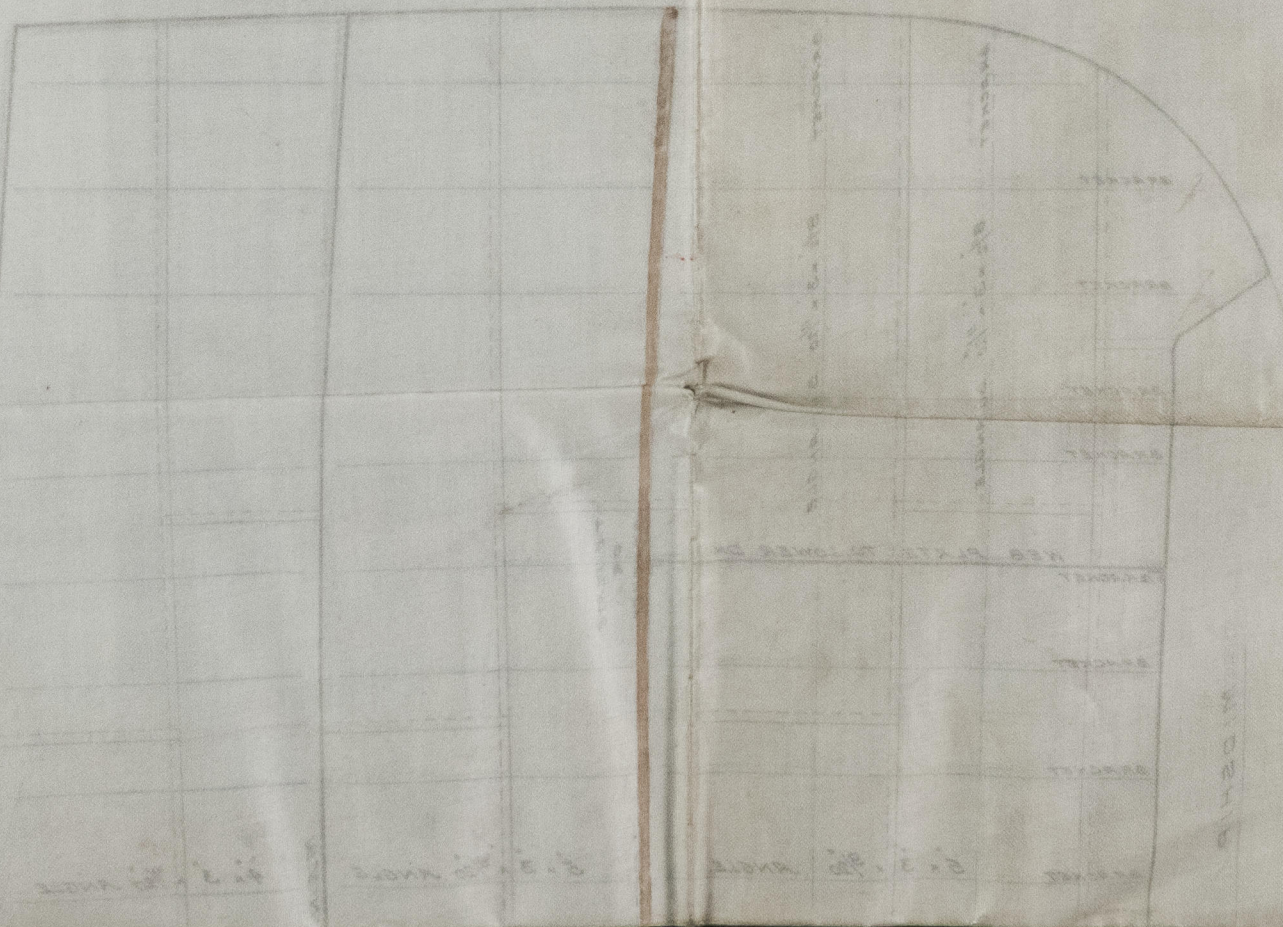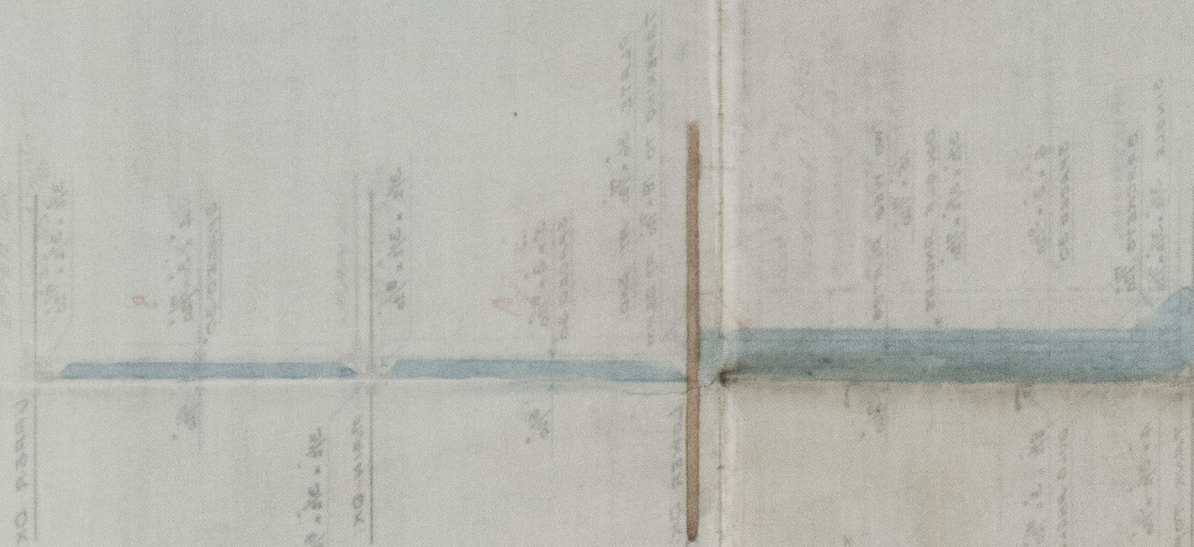

ARRANGEMENT OF

2/2

SCALE 1/4


RECEIVED
LLOYD'S REGISTER OF SHIPPING
LONDON
31 MAR 94

RECEIVED
LLOYD'S REGISTER OF SHIPPING
LONDON
31 MAR 94

RECEIVED
LLOYD'S REGISTER OF SHIPPING
LONDON
27 APR 94



© 2021
Lloyd's Register
Foundation