



11.5.94

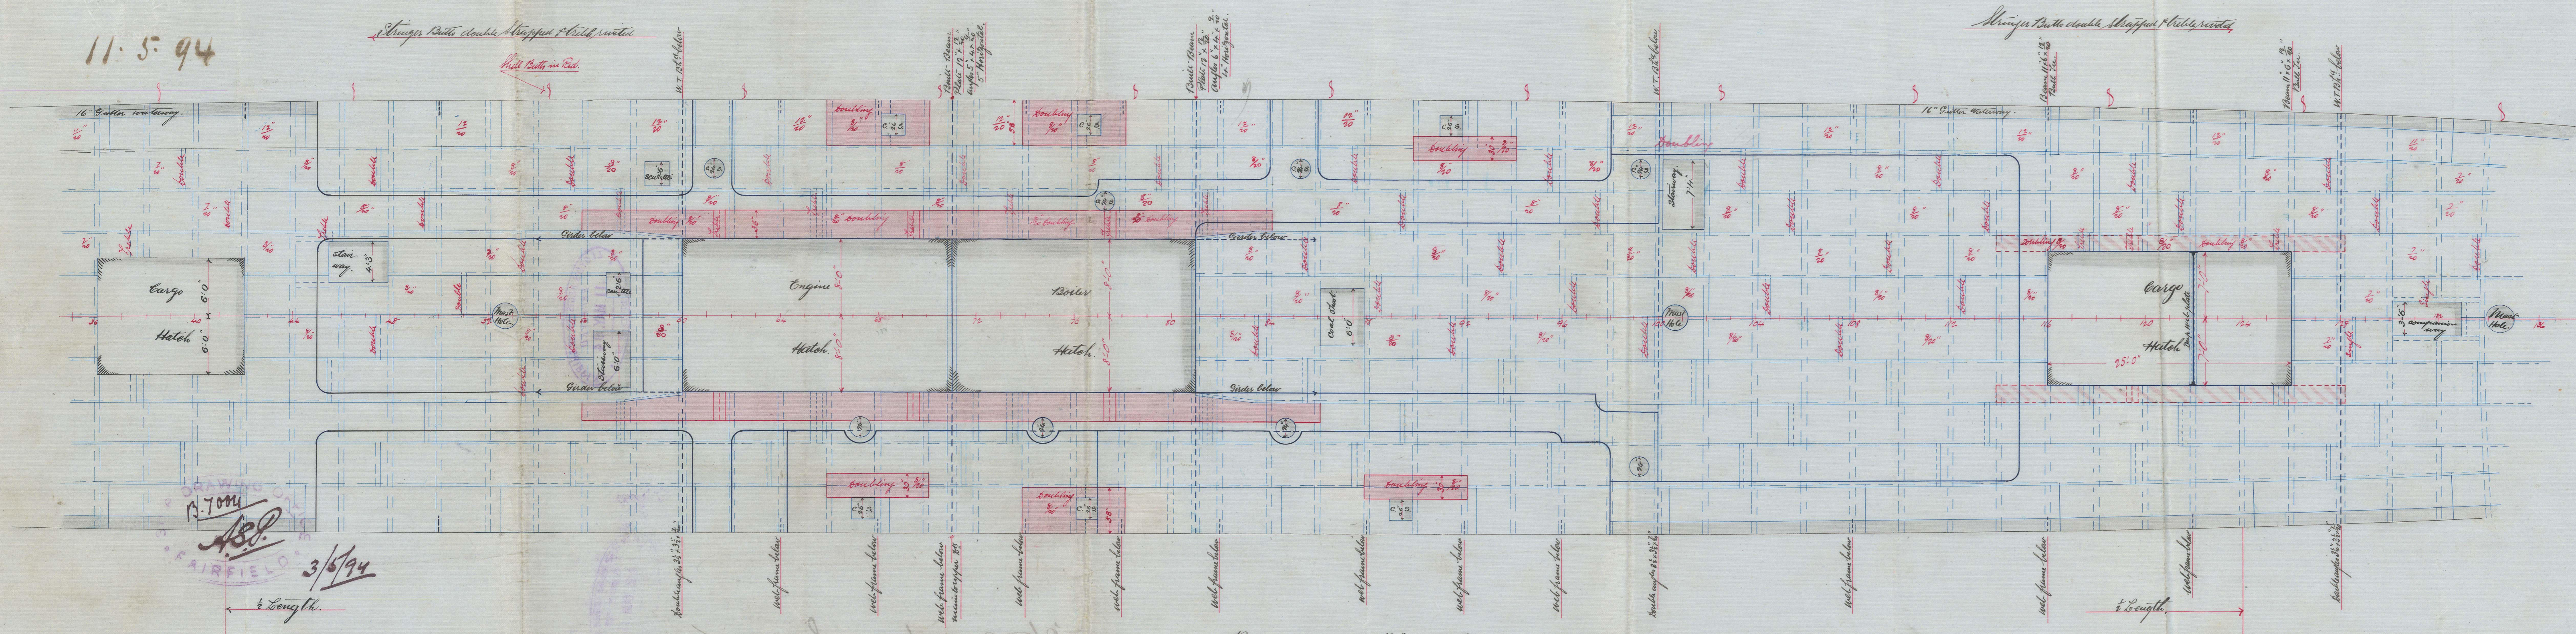

Upper Deck Plan
additional strengthening in way of Hatches
S. S. No. 377
Scale 1/8" = one foot.

S.S. "Arundel Castle"
Glasgow Report 13398.

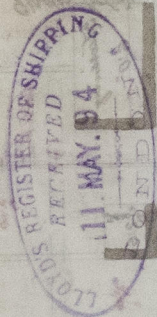

© 2021

Lloyd's Register
Foundation

GLS245-0155