

# Lloyd's Register of British and Foreign Shipping.

(Report on Vessel No. 13431 Port Glasgow  
"Gorsehead,")

No. 4583 SHIP FORGINGS OR ~~CASTINGS~~.

I have to report that the undermentioned Iron or ~~Steel~~ Forgings or ~~Castings~~,  
manufactured by The Dennytown Forge Coy  
of Dumbarton for the Vessel No. 331, being built  
by Messrs A McMillan & Son of Dumbarton  
have been inspected by me as set forth below, and found to be, so far as can be seen,  
Sound & efficient

The words FORGINGS or CASTINGS, IRON or STEEL, should be struck out as may be required.



Mark on Forgings.

Lloyd's  
No. 4583  
W.H.

William Hamilton  
Glasgow  
3/11/94

	STERN FRAME.	RUDDER FRAME.	STEM.
Material*		<u>Scrap iron</u>	
How made		<u>Forged</u>	
Dimensions		<u>8 1/2 to 4 1/4</u>	
Progress on Inspection		<u>Forging &amp; smithing</u>	
Date when Inspected		<u>23/28/7/94. 4. 11. 14.</u> <u>18. 20. 25. 28/9/94. 1. 9</u> <u>12. 16. 19. 24/10/94</u>	

SKETCHES OF FRAMES SHOWING POSITION AND DESCRIPTION OF WELDS OF FORGINGS, OR PARTICULARS OF TESTS APPLIED TO CASTINGS.

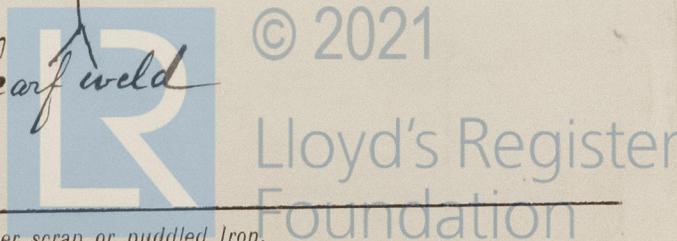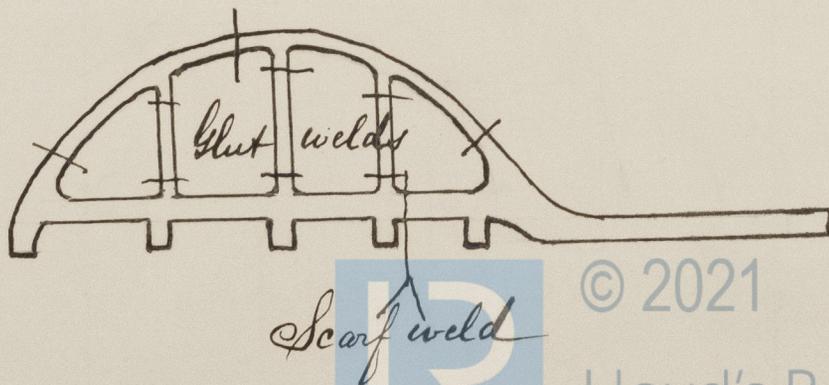

\* If of Iron, state whether scrap or puddled Iron.