




16.7.94

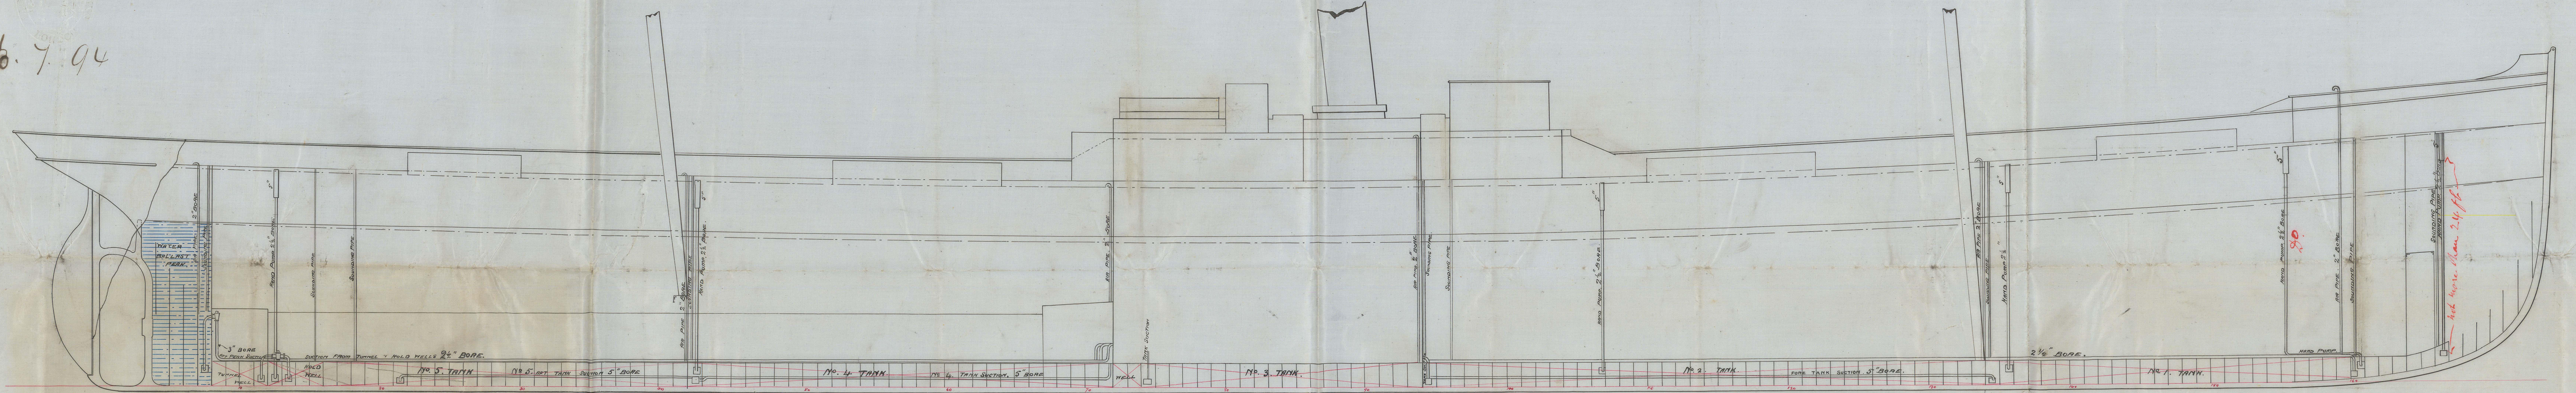

PROFILE

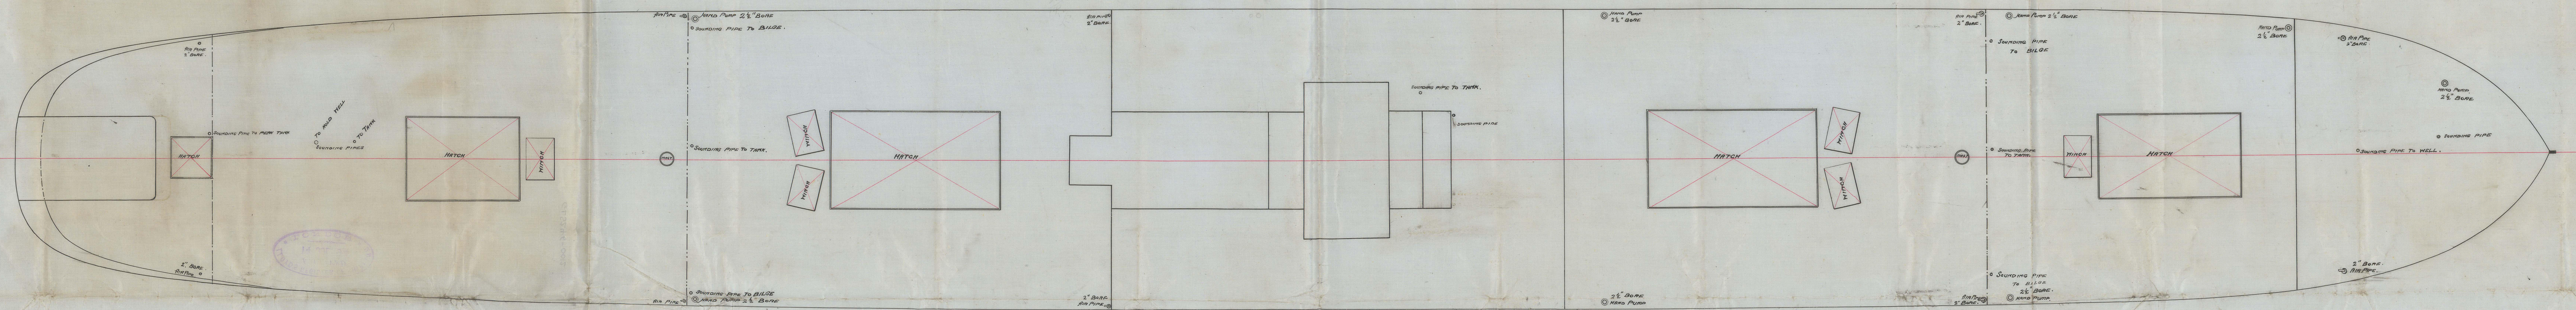

SPAR DECK

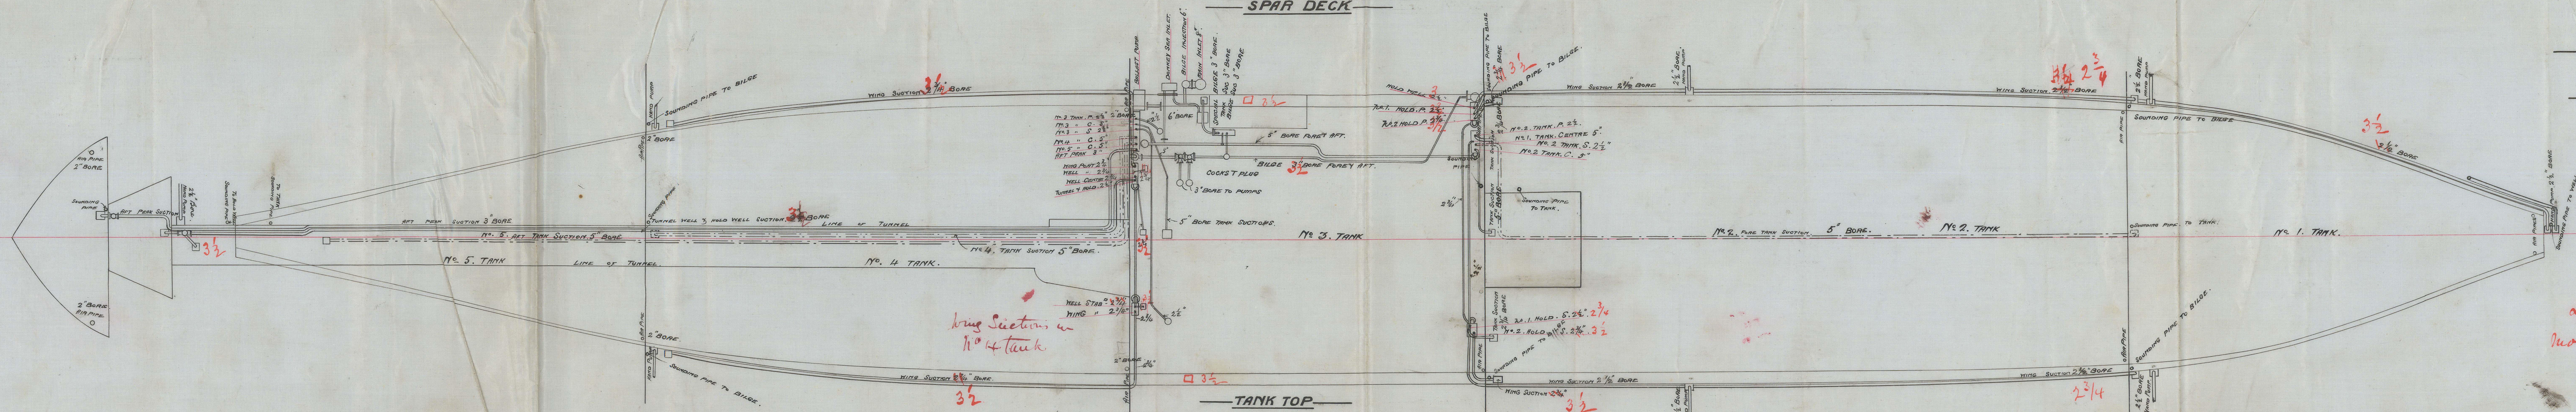

PIPING & PUMPING ARRANGEMENT
S. S. N° 331
SCALE 1/8 INCH = ONE FOOT.



Left of hand pumps not to be more than 24 ft.

S. S. Gorsedd "Glasgow Report No. 13431.-

