





11.7.94

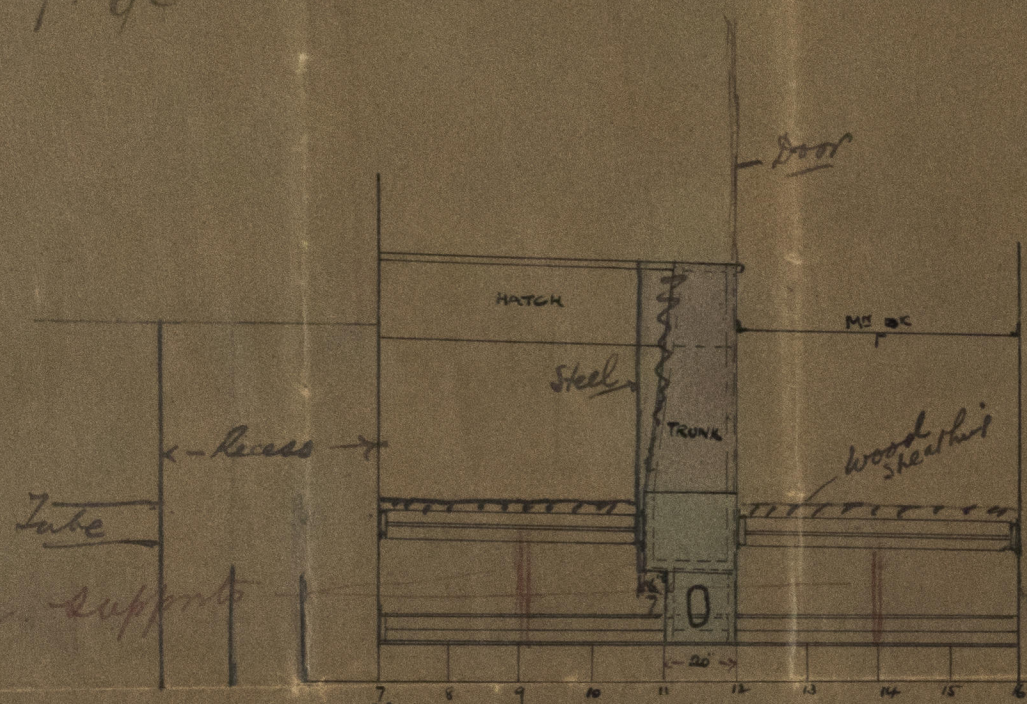


ELEVATION (SCALE 1"=1 FT)

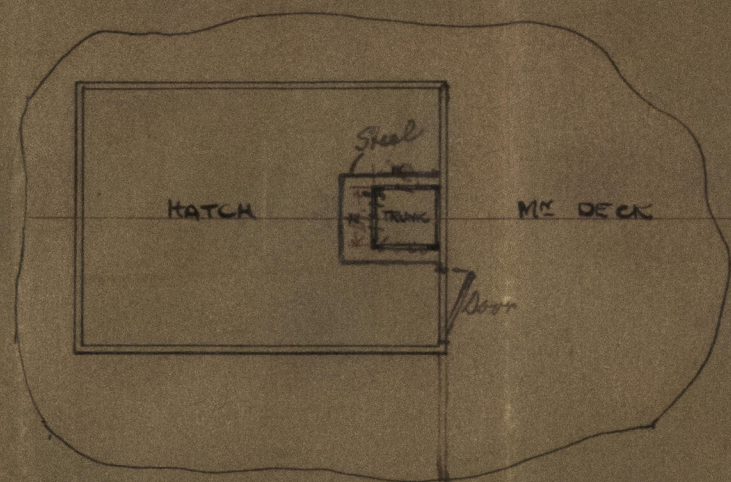

PLAN (SCALE 1"=1 FT)

No 92.


PROPOSED TRUNK TO SHAFT BEARING.

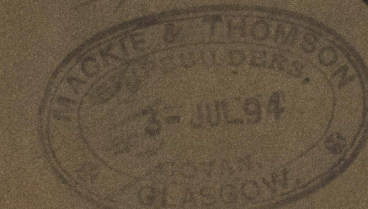

ELEVATION OF TRUNK
SCALE 1"=1 FOOT

gls - 4/14/94
W.H.L.


J.T.M. 5/7/94

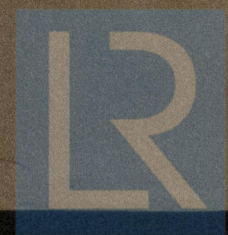

© 2021
Lloyd's Register
Foundation





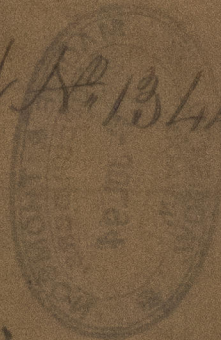

ELEVATION OF TRUNK



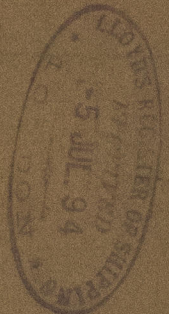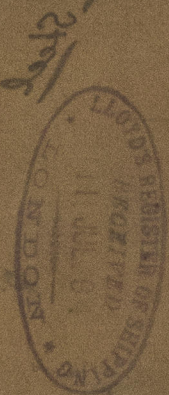




615246 5017



© 2021
Lloyd's Register
Foundation