

# Lloyd's Register of British and Foreign Shipping.

(Report on Vessel No. 13445, Port Glasgow)  
" Banshee "

## No. 4626 SHIP FORGINGS ~~OR CASTINGS~~.

The words FORGINGS or CASTINGS, IRON or STEEL, should be struck out as may be required.

I have to report that the undermentioned Iron ~~or Steel~~ Forgings ~~or Castings~~,  
manufactured by The Portland Forge Coy  
of Kilmarnock for the Vessel No. 92, being built  
by Messrs Mackie & Thomson of Glasgow  
have been inspected by me as set forth below, and found to be, so far as can be seen,  
Sound & efficient


Mark on Forgings.

Lloyd's  
No. 4626  
W.H.

William Hamilton  
Glasgow 46/6/94

	STERN FRAME.	RUDDER FRAME.	STEM.
Material* ...	<u>Scrap iron</u>		
How made ...	<u>Forged</u>		
Dimensions ...	<u>5 3/4 x 2 1/4</u>		
Progress on Inspection	<u>Forging &amp; smithing</u>		
Date when Inspected	<u>31/5/94. 5. 7. 11. 12/6/94</u>		

SKETCHES OF FRAMES SHOWING POSITION AND DESCRIPTION OF WELDS OF FORGINGS, OR PARTICULARS OF TESTS APPLIED TO CASTINGS.

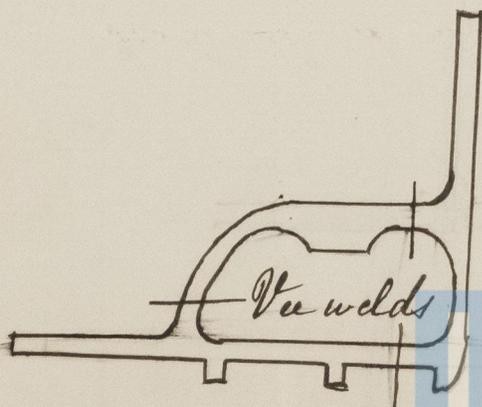

\* If of Iron, state whether scrap or puddled Iron.

Machic Thomson

92

Stem frame

10  
10  
10

*[Faint, mostly illegible handwritten notes, possibly describing measurements or parts of a stem frame.]*

*[Faint, mostly illegible handwritten notes, possibly describing measurements or parts of a stem frame.]*



© 2021

Lloyd's Register  
Foundation