

Lloyd's Register of British and Foreign Shipping.

(Report on Vessel No. 13442 Port Glasgow)Gilanrafach.No. 4689 SHIP FORGINGS OR ~~CASTINGS~~.I have to report that the undermentioned Iron ~~or Steel~~ Forgings ~~or Castings~~,
manufactured by Messrs Robt Kerr & Sonof Irvine for the Vessel No. 45, being builtby Messrs S McKnight & Co of Ayr

have been inspected by me as set forth below, and found to be, so far as can be seen,

Sound & efficient

Mark on Forgings.

Lloyd's

No. 4689

W.H.


William Hamilton

Glasgow

29/11/94

	STERN FRAME.	RUDDER FRAME.	STEM.
Material*	Scrap iron		
How made	Forged		
Dimensions	4 1/2 to 2 3/8 full		
Progress on Inspection	Forging & smithing		
Date when Inspected	29/11/94. 10. 13/10/94 14. 21. 22/11/94		

SKETCHES OF FRAMES SHOWING POSITION AND DESCRIPTION OF WELDS OF FORGINGS, OR PARTICULARS OF TESTS APPLIED TO CASTINGS.

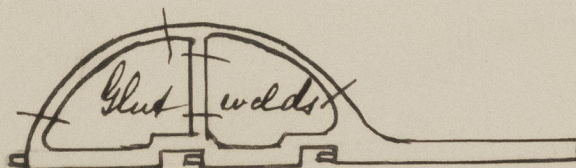

Fee (if any chargeable) £ : :

To be paid at



© 2021

Lloyd's Register
Foundation

45-







© 2021

Lloyd's Register
Foundation