
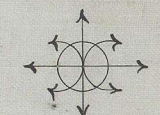


Mr. Brown
 21: 11: 94
 Lloyd's Register of Shipping
 1874/5

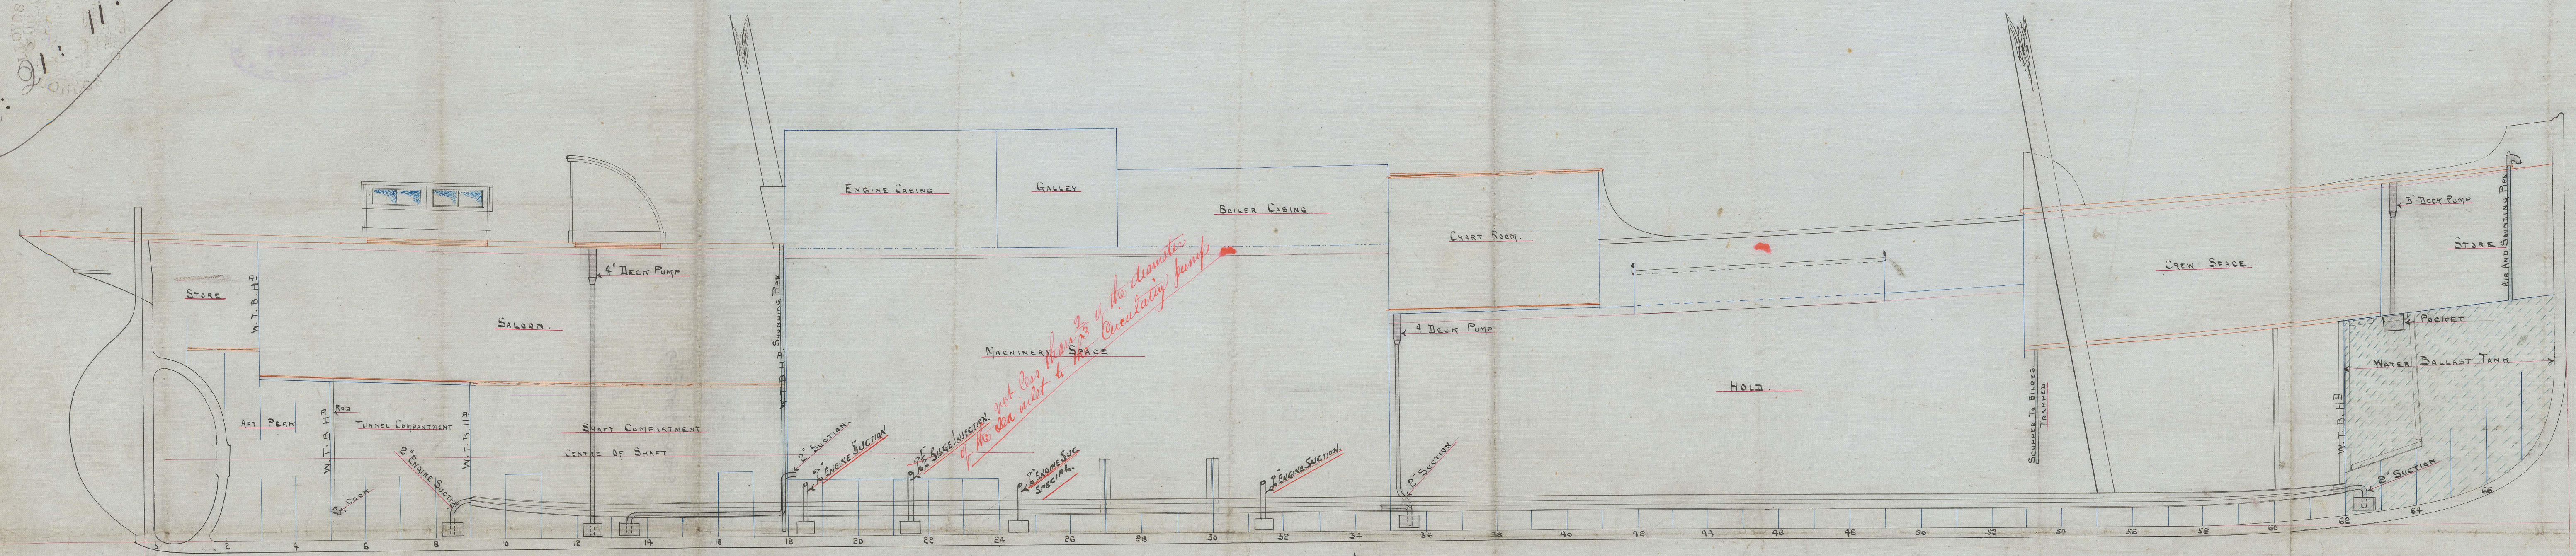


No SLUCE VALVES ON BULKHEADS ARE
 REQUIRED BY OWNERS

PUMPING ARRANGEMENT

S S N° 45

SCALE 1/4" = 1 FOOT

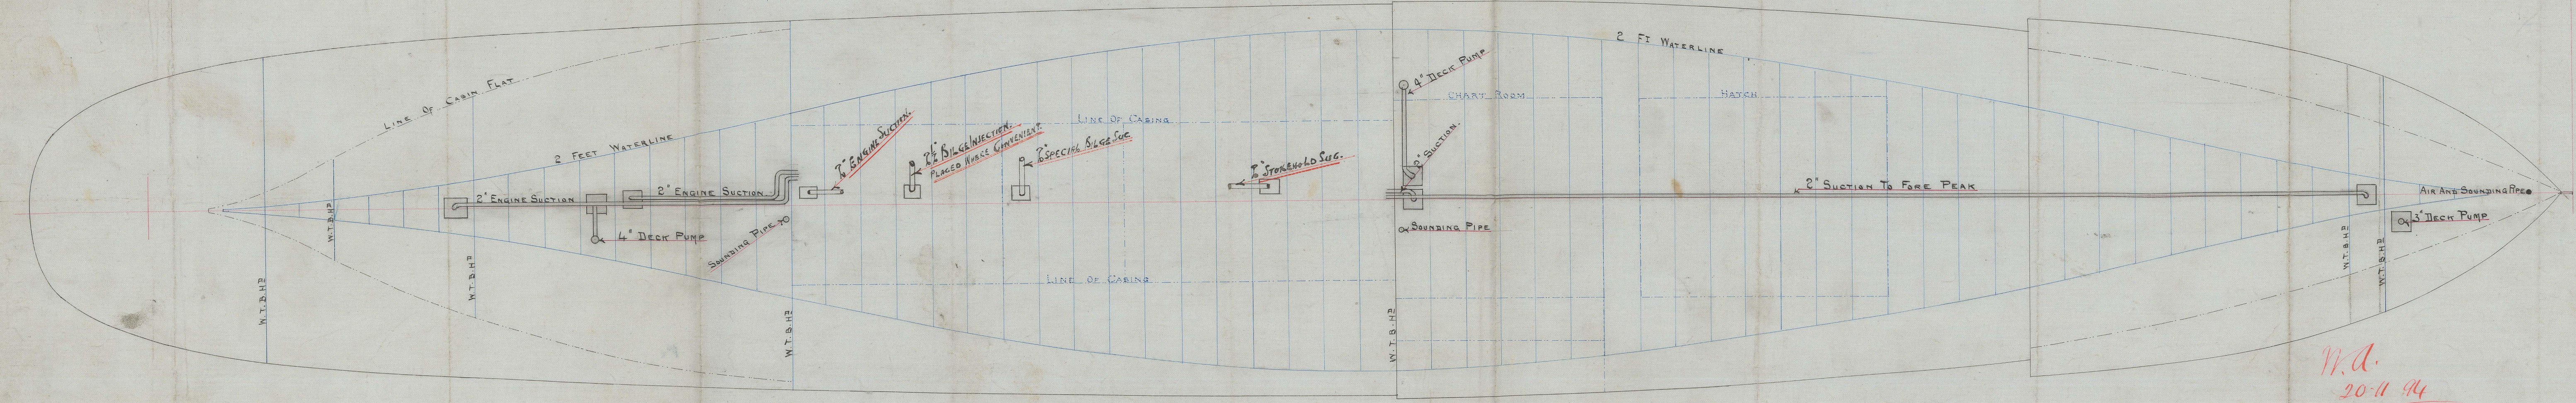

N.A.
 20-11-94

S. S. Gilanreach Glasgow Report No 13442.

© 2021

Lloyd's Register
Foundation

GLS 245-0043