

SCALE  $\frac{1}{2}'' = 1 \text{ FOOT}$  —

TO CLASS 100-A-1- AT LLOYDS: STEEL

LENGTH B.P. .... 120'-0"  
BREADTH M<sup>2</sup> ..... 20'-0"  
DEPTH M<sup>2</sup> ..... 10'-6"  
ROUND OF BEAM ..... 5"  
RISE OF FLOOR ..... 12"

NUMERALS TO MAIN DECK

|                         |         |
|-------------------------|---------|
| $\frac{1}{2}$ GIRTH     | 18-00   |
| $\frac{1}{2}$ BREADTH   | 10-00   |

| ER ECTIONS   |       |
|--------------|-------|
| QUARTER DECK | 61-25 |
| FORECASTLE   | 26-00 |
| BRIDGE       | 10-50 |
|              | 97-45 |

$$94.75 \div 119.0 = .82$$

EQUIPMENT NUMERAL

$$4630.29 \times \frac{1}{8} \times .82 = 474.59 + 4630.29 = 5104.88$$


PROPORTIONS

BREADTHS TO LENGTH = 5.95

DEPTHS TO LENGTH = 10.90

EQUIPMENT NO 5104-88

|   |                      |
|---|----------------------|
| 2 BOWERS EACH                               | 5 CWT EX STOCK       |
| OR COLLECTIVE                               | 10 CWT - - - -       |
| 1 STREAM ANCHOR                             | 1 1/2 - - - - -      |
| 1 KEDGE                                     | 3/4 - - - - -        |
| 135 FATHOMS <sup>134</sup> STUD CHAIN CABLE |                      |
| 45 - - -                                    | 9/16" STREAM CHAIN - |
| 75 - - -                                    | 6" HEMP TOWLINE -    |
| 90 - - -                                    | 4" HAWSER -          |



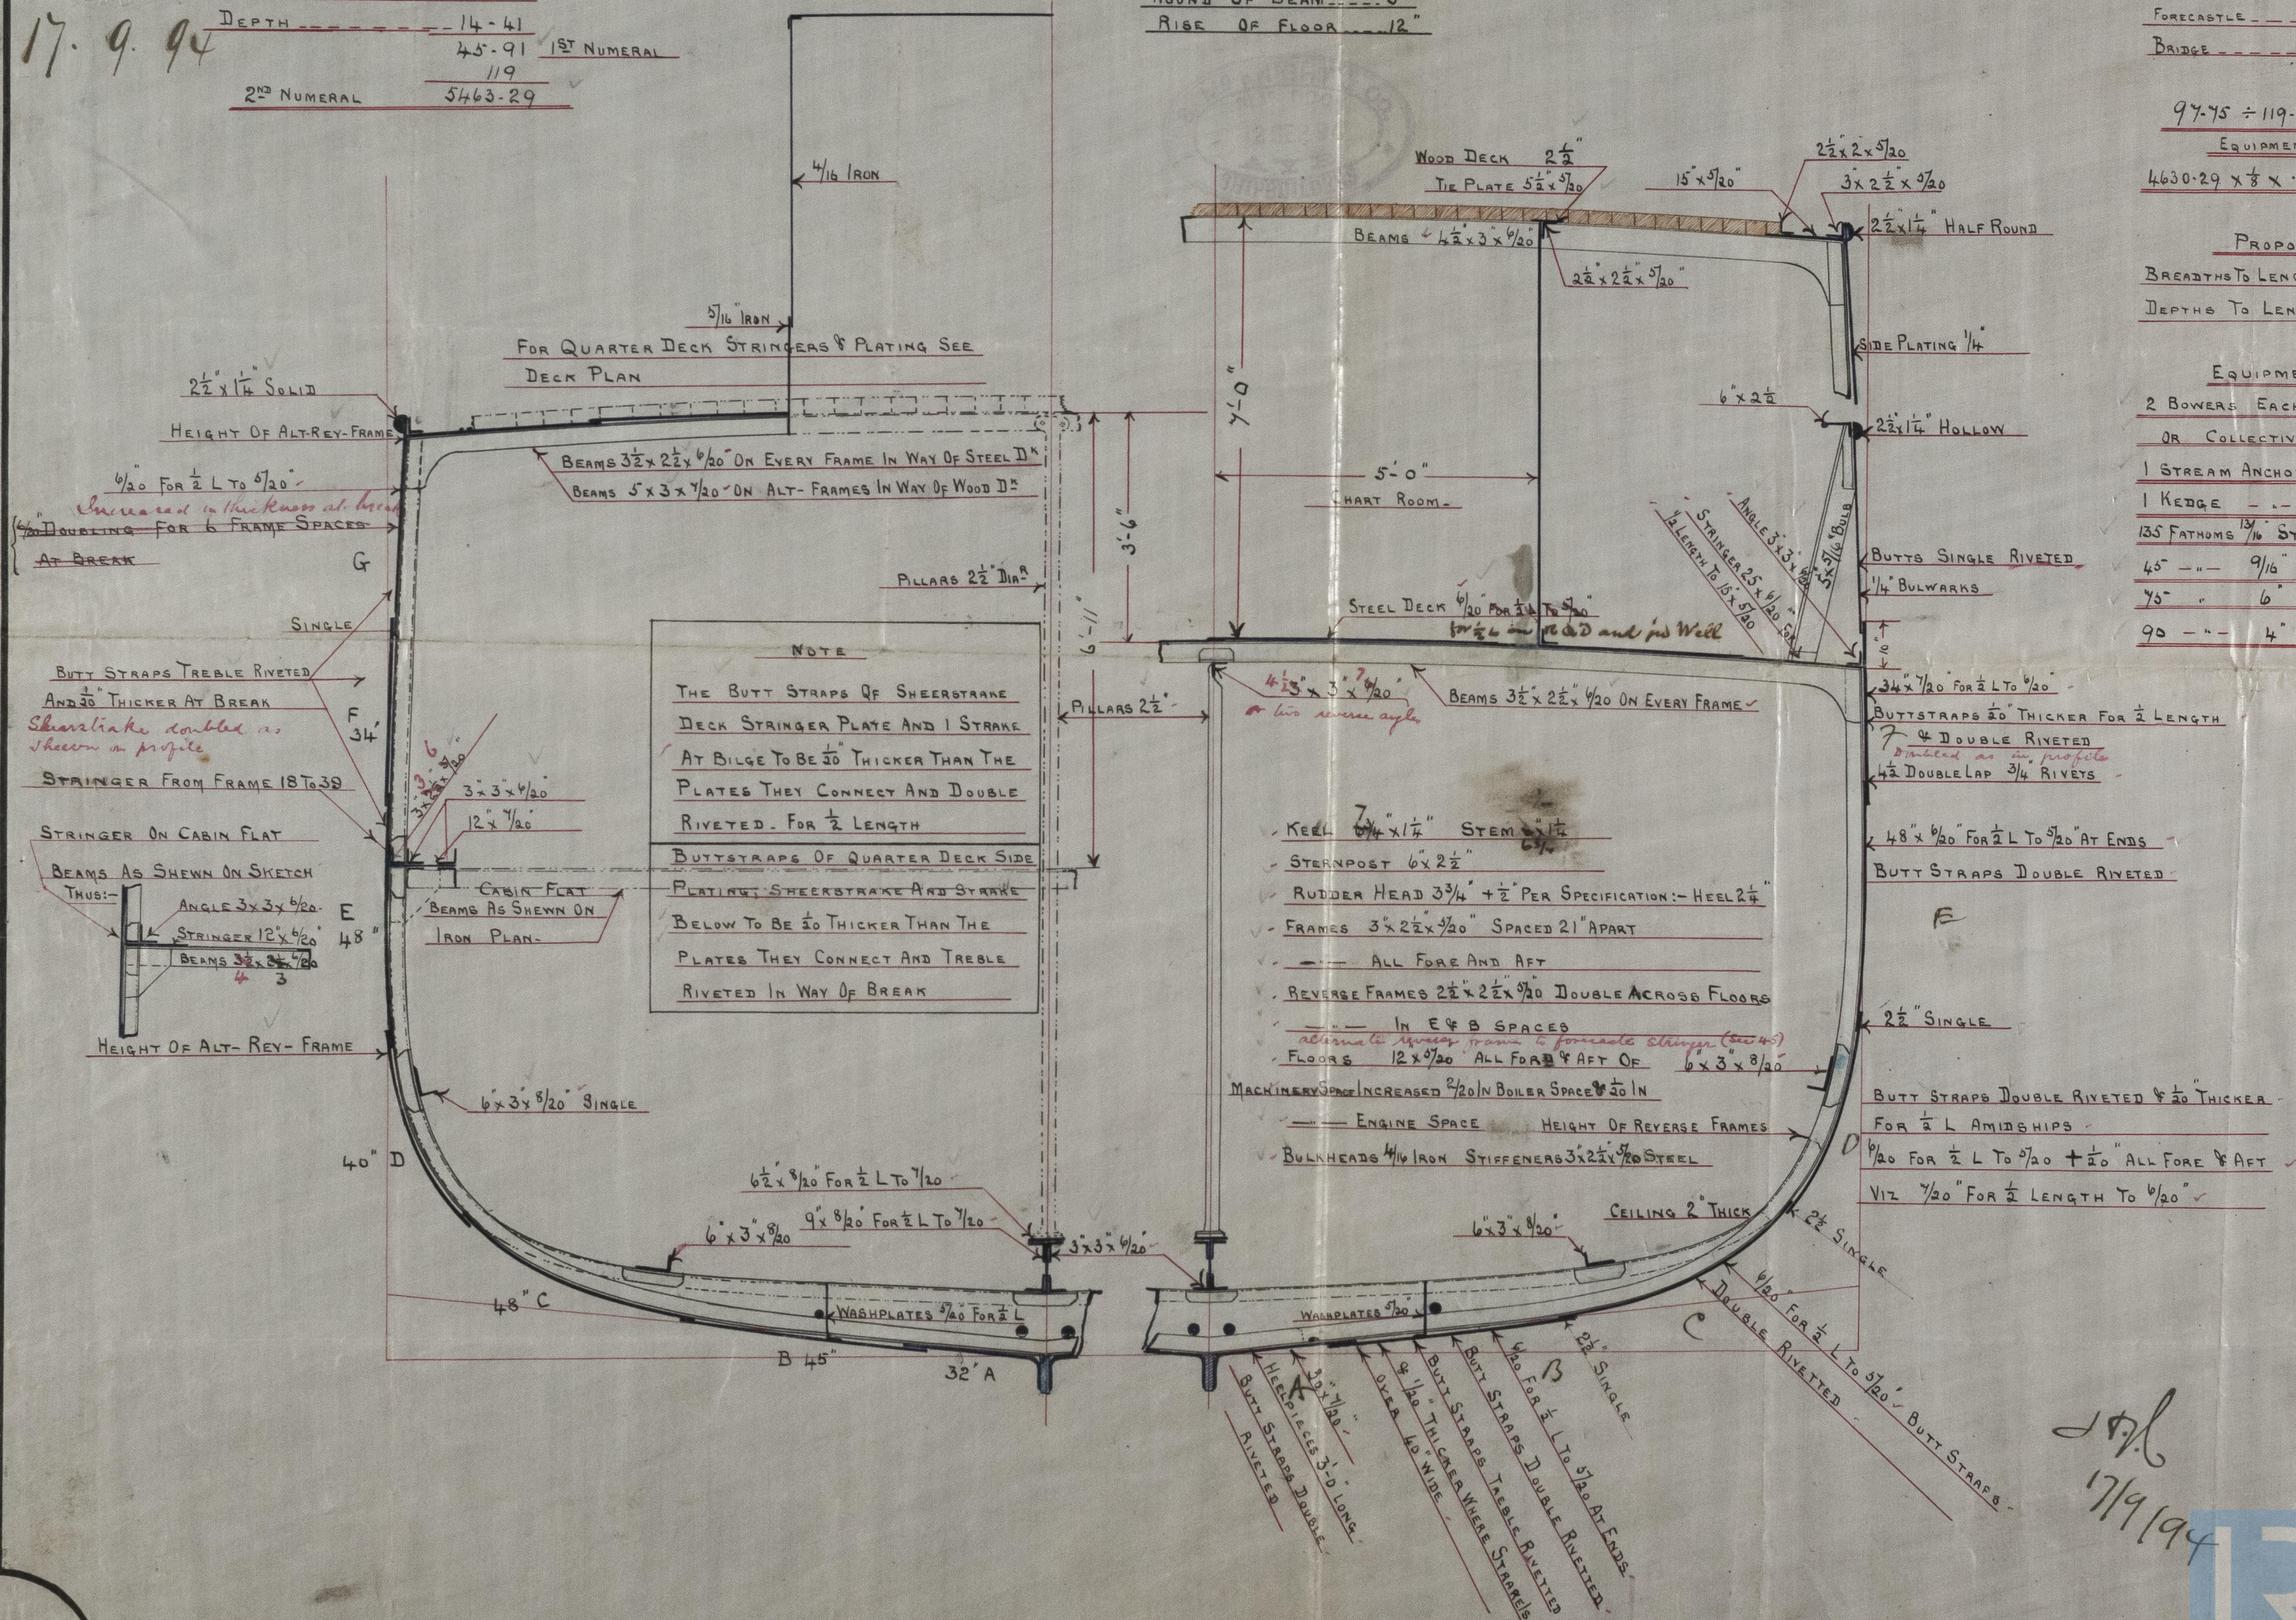





ayr  
no 45 X

S. S. Gilanreach "Glasgow Report No 134 y2.

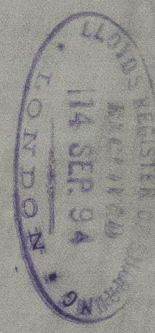 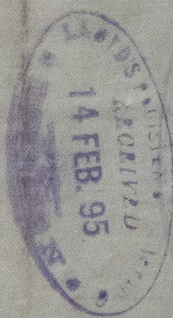

Transcript

GLS246-0044

SHIPING



With line from G to H



© 2021  
Lloyd's Register  
Foundation