

Midship Section Steel Screw Steamer No 216

To class 100A. at Lloyds.

Scale $\frac{1}{2}$ inch = 1 foot

11. 8. 94

11. 9. 94

$\frac{1}{2}$ Breadth 17.79

Depth 19.54

$\frac{1}{2}$ Girth 34.29



41.62 x 253.58 = 18161 + 1609 = 19770
FN. PN. EN.

Proportions

Depths to Main Deck 12.97

" " Quarter 10.80

Breadths 7.12

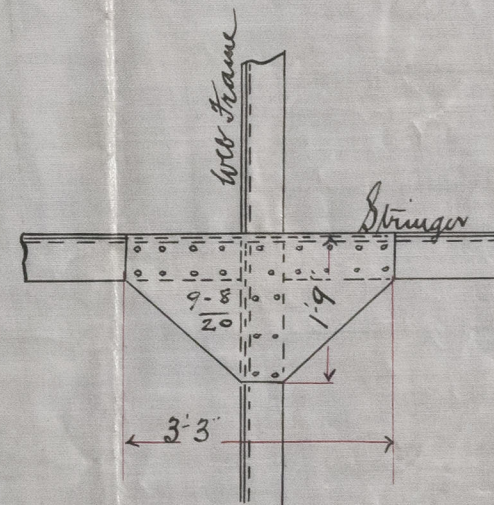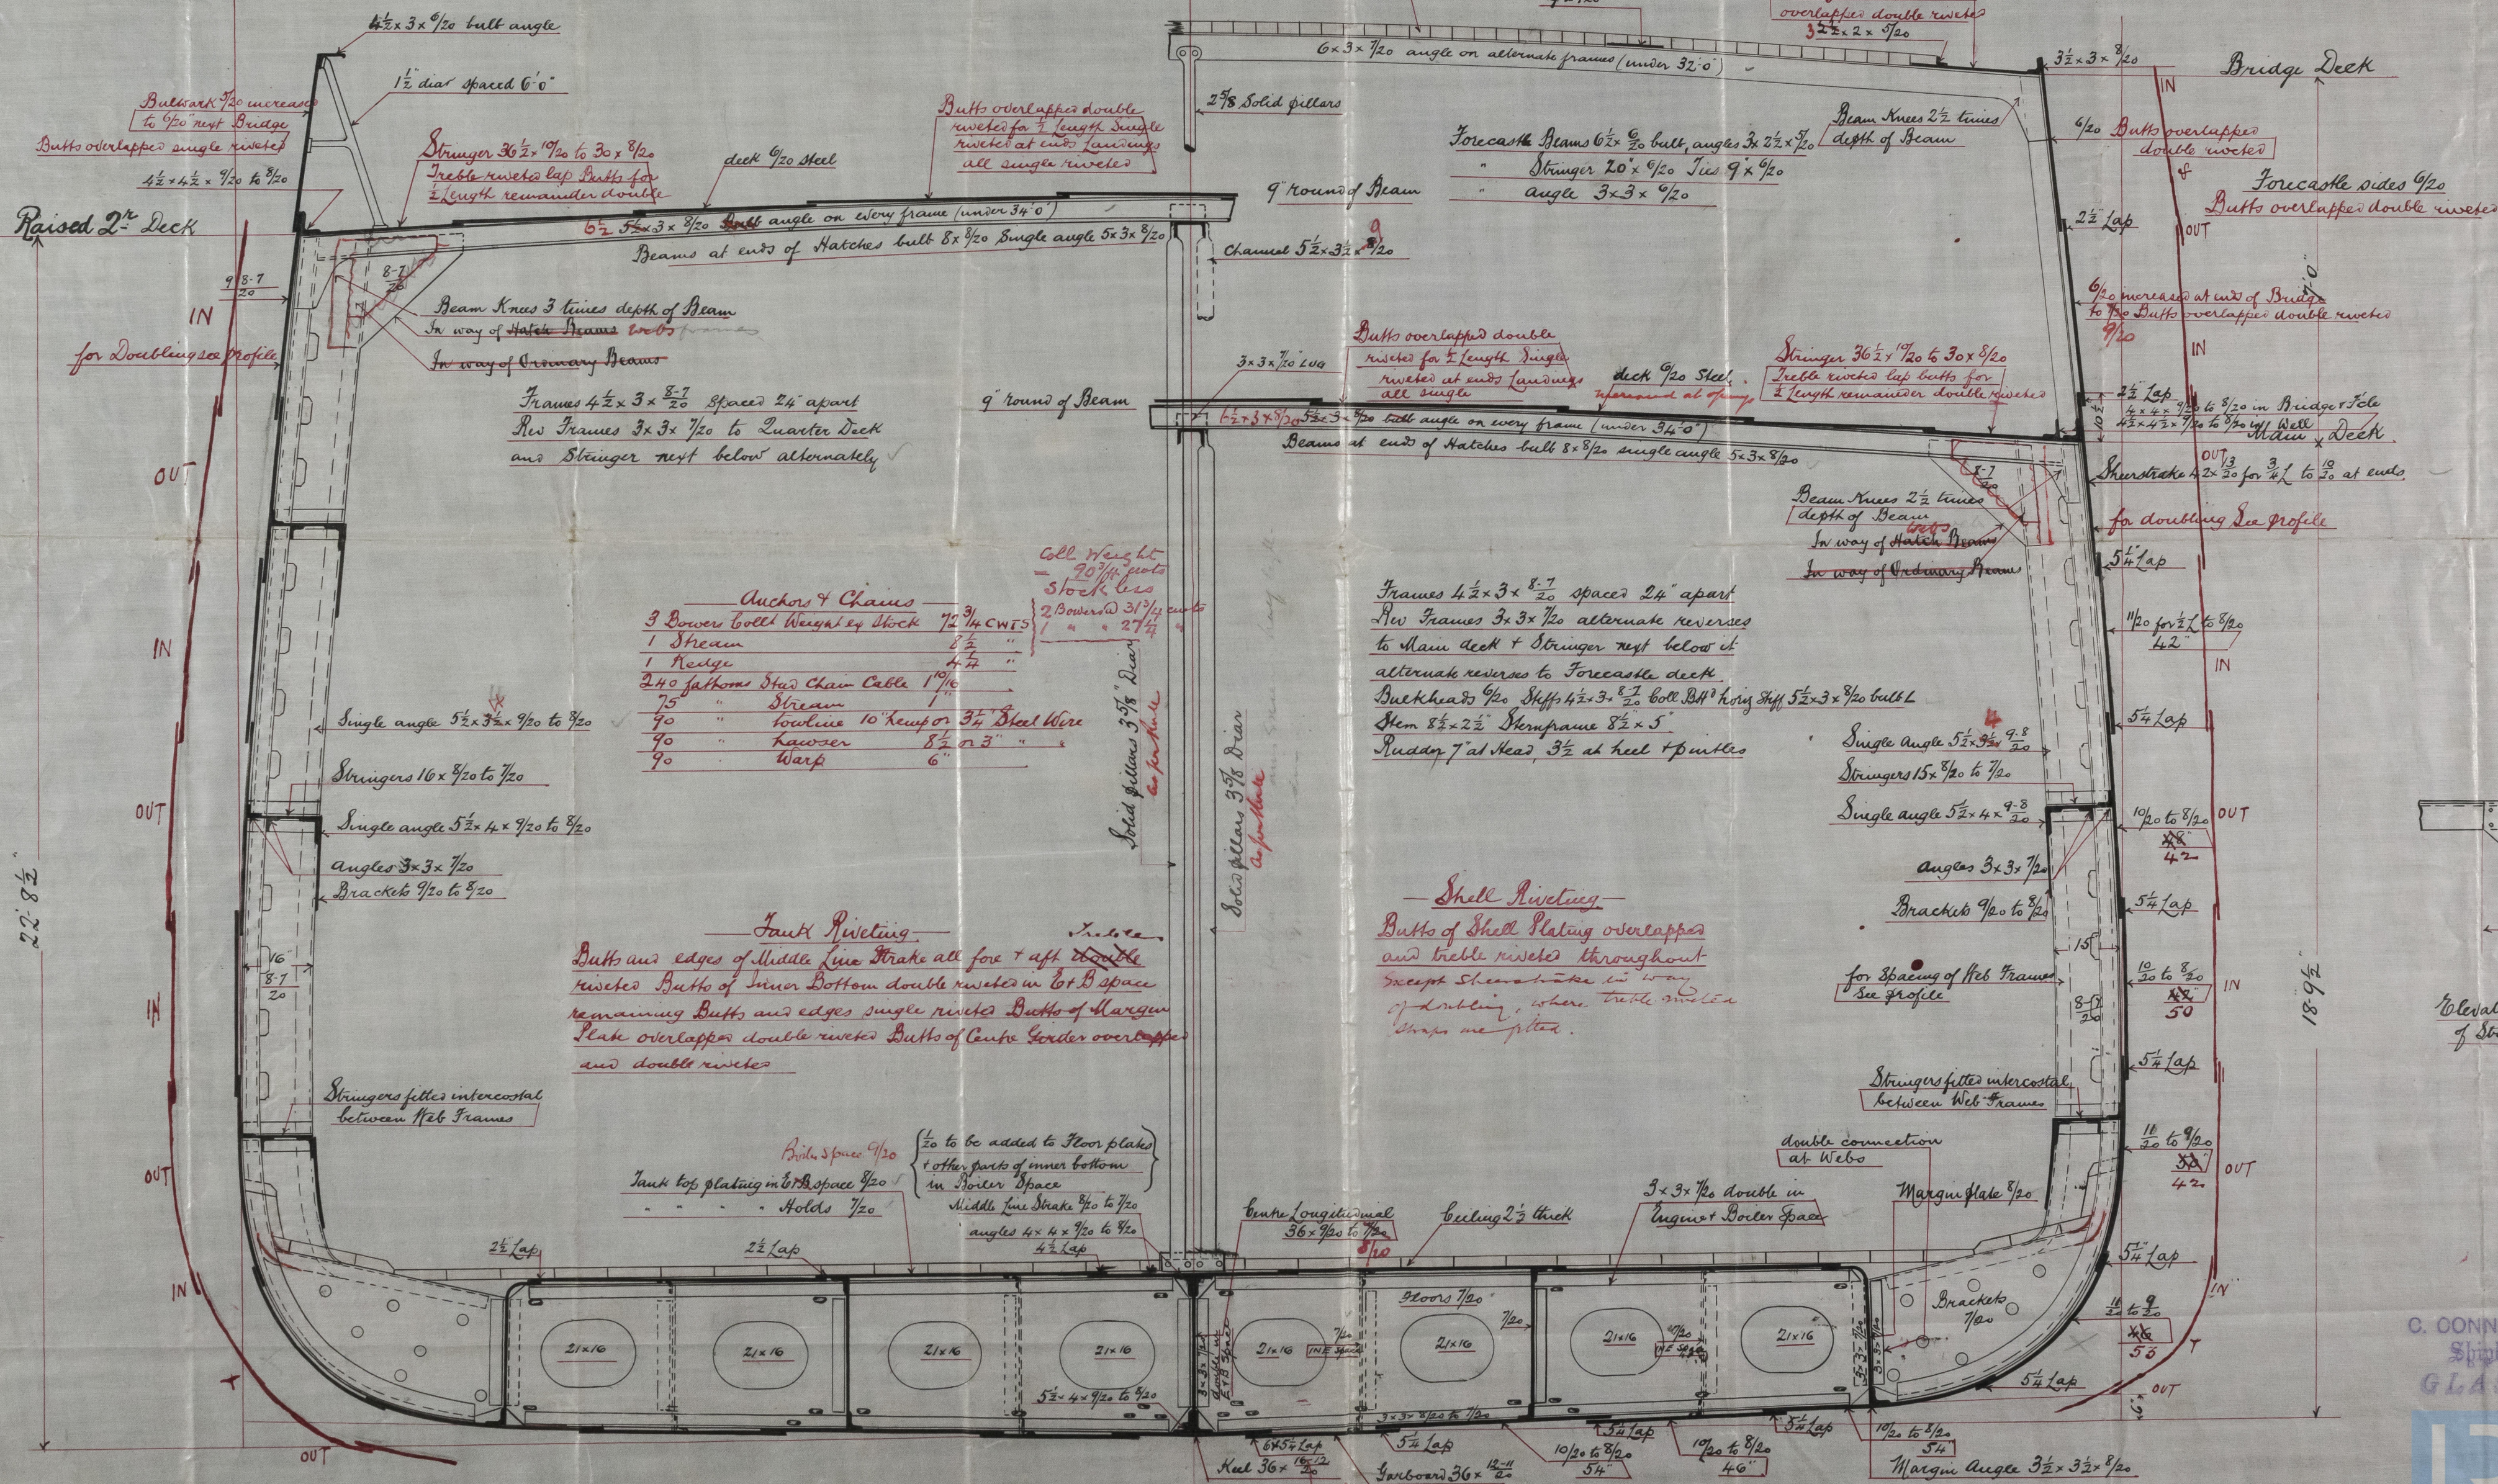


Elevation showing bracket connection of stringer to web frame

G. O'CONNELL & CO.
Shipbuilders,
GLASGOW.

10/8/94




Ship "Lyon" Glasgow Report No. 4

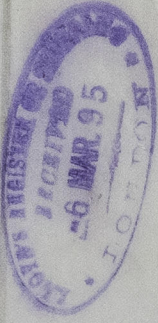

BRITISH IN

11
20
20

with forward & aft masts

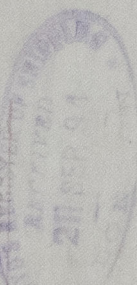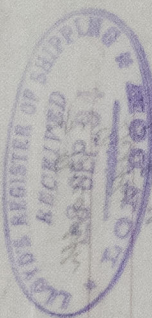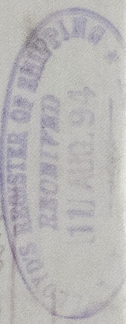

97.11
42.21
95.12
11.05
14.53
EN


BN

EN










© 2021
Lloyd's Register
665246-0115
Foundation