
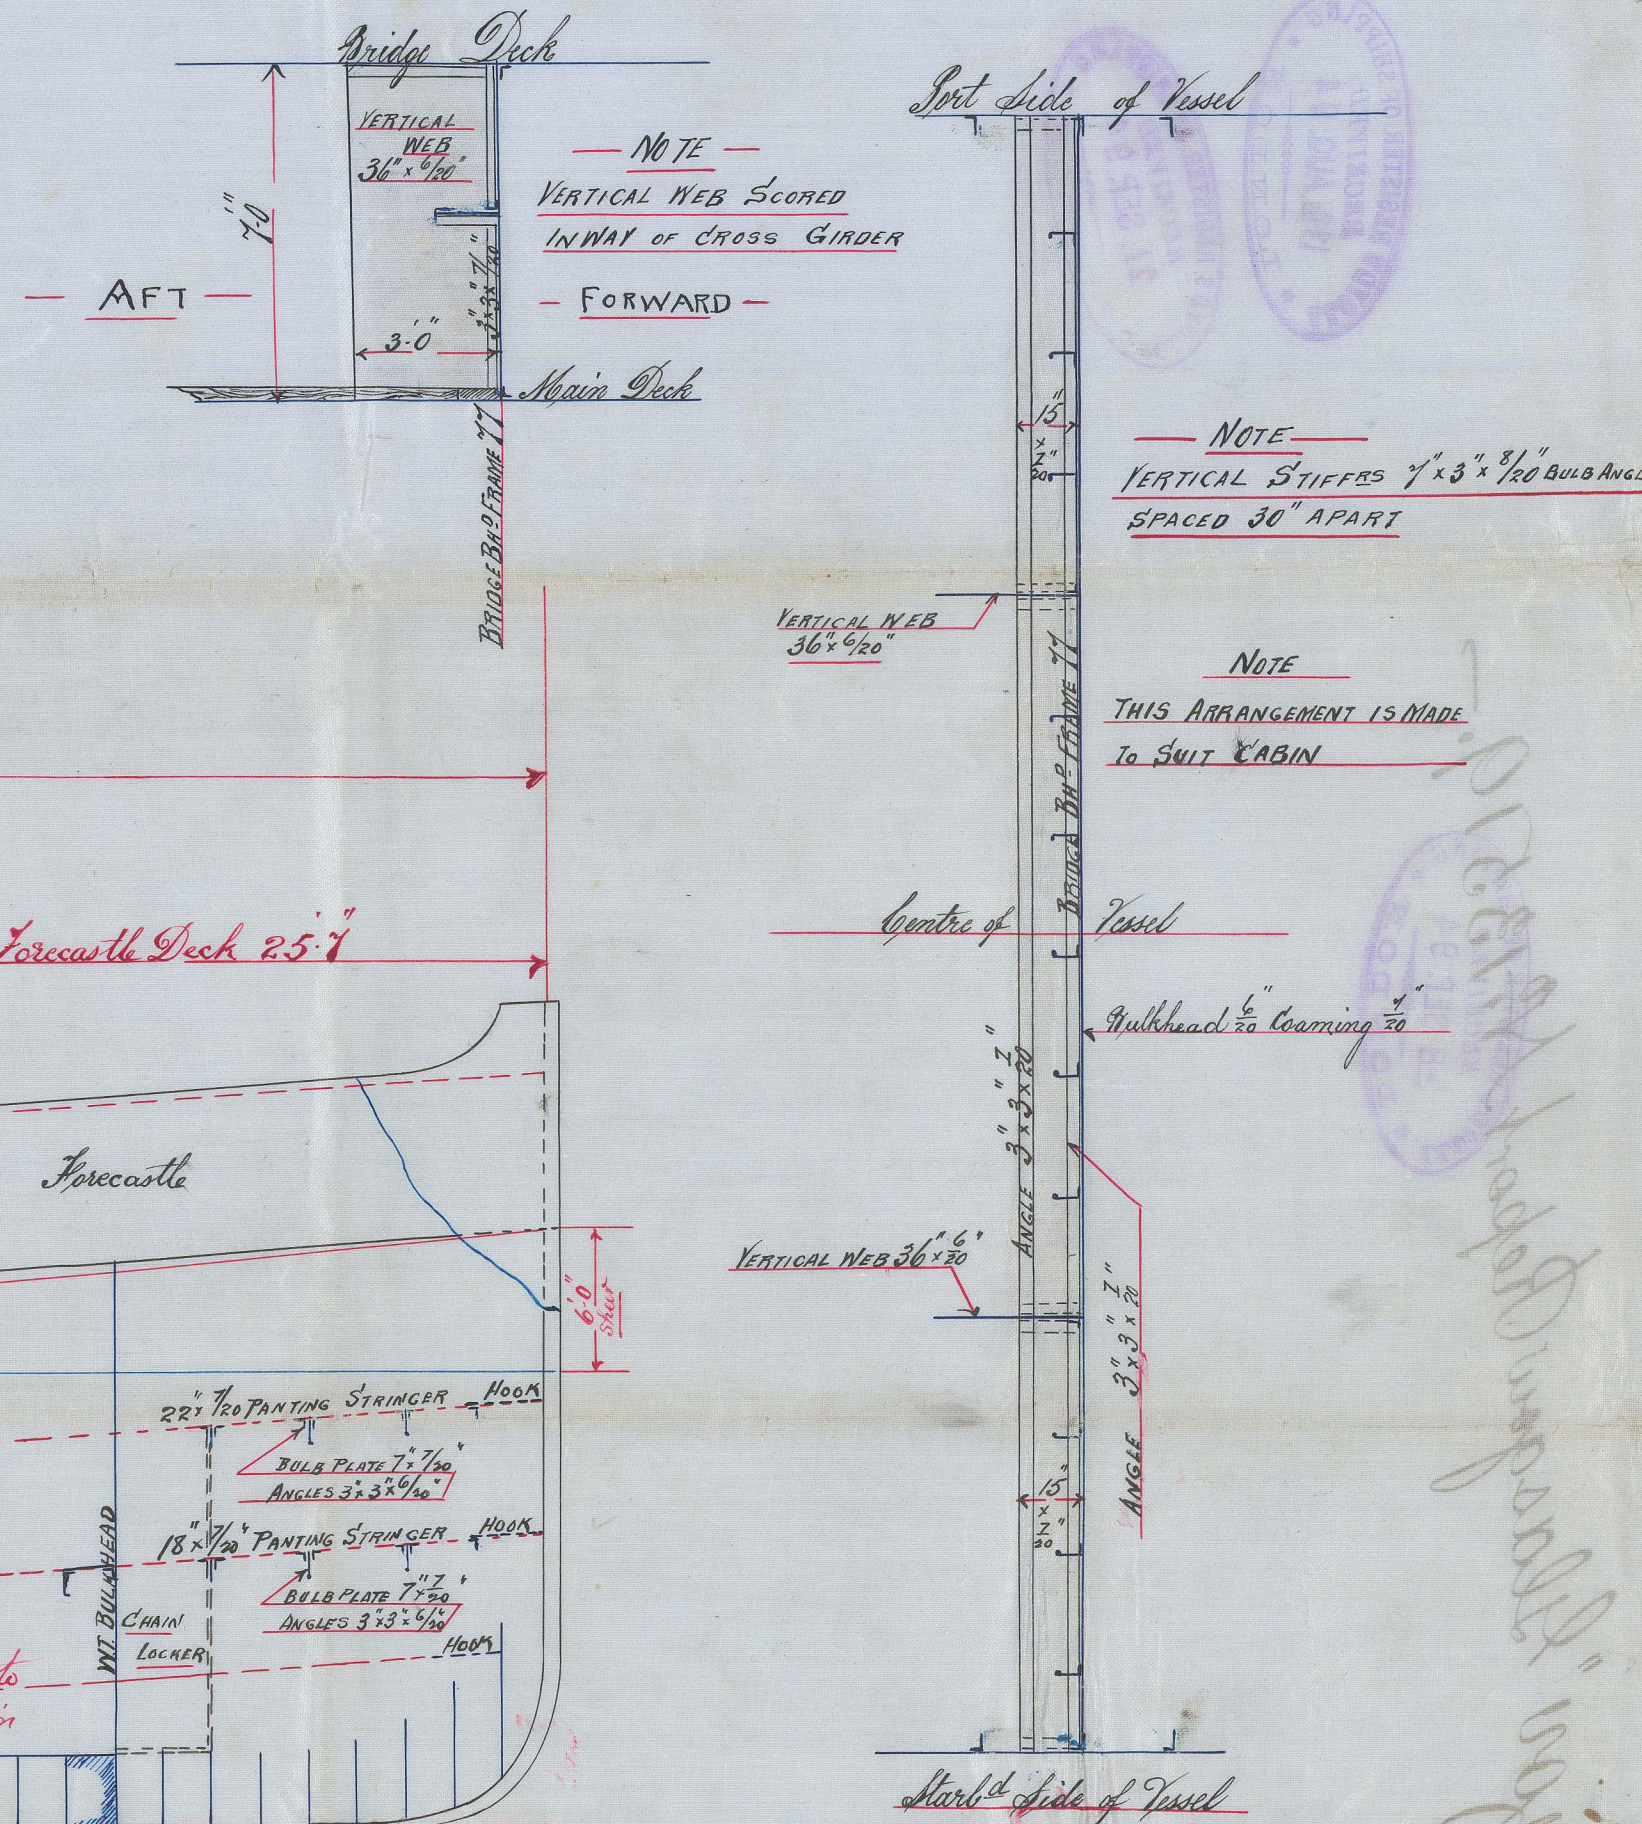


11.8.94

Freeboard Particulars
 Length on Load Line 255'0"
 Calculated Depth to Main Deck 18'9 1/2"
 Estimated Tonnage Co. off. 82
 Length of Sections 174'4"
 Mean Stages over total length 4' 1/2"
 Sheer Forward 6'0"
 Sheer aft 5'3"
 Increased height of } at Bridge Bk. 6"
 Sheer on well } " 7'0" 6"
 Additional strengthening Bridge Bulkhead
 for the increased freeboard (para 11)

PROFILE
STEEL SCREW STEAMER N° 216
TO CLASS 100 A AT LLOYDS
SCALE 1/8" = 1 FOOT

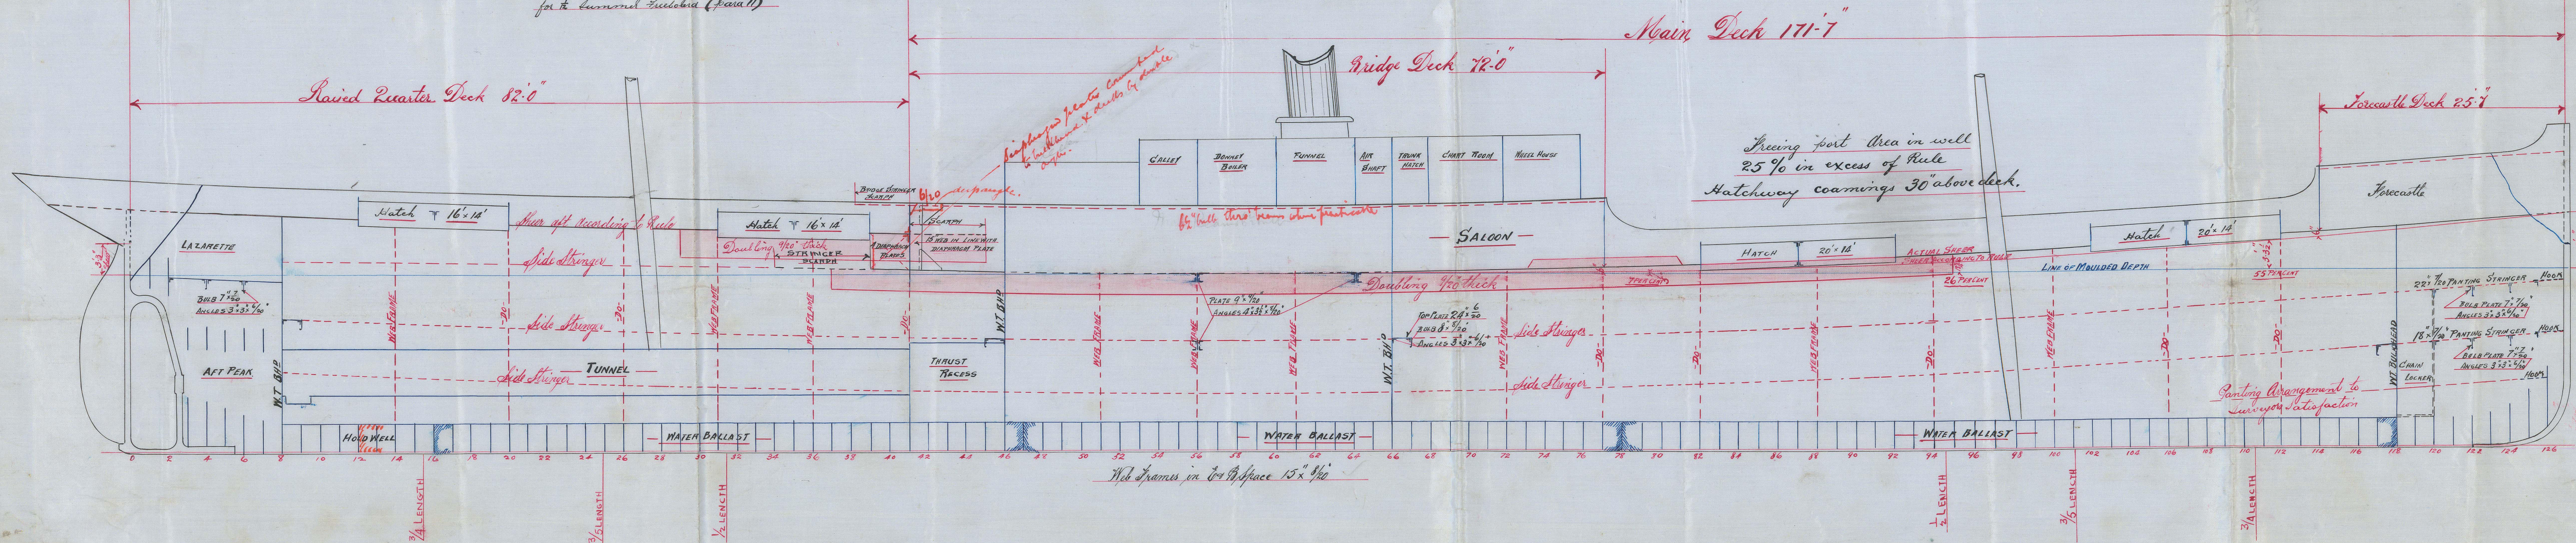

2014/135
RECEIVED
28 SEP 94
LONDON

© 2021

Lloyd's Register
Foundation

GLS246 - 0120