


19. 9. 94

Screw Steamer No 216
Single Plate Rudder
Scale $\frac{1}{2}$ inch = 1 ft.

Rudder 7' to 3 $\frac{1}{2}$ '

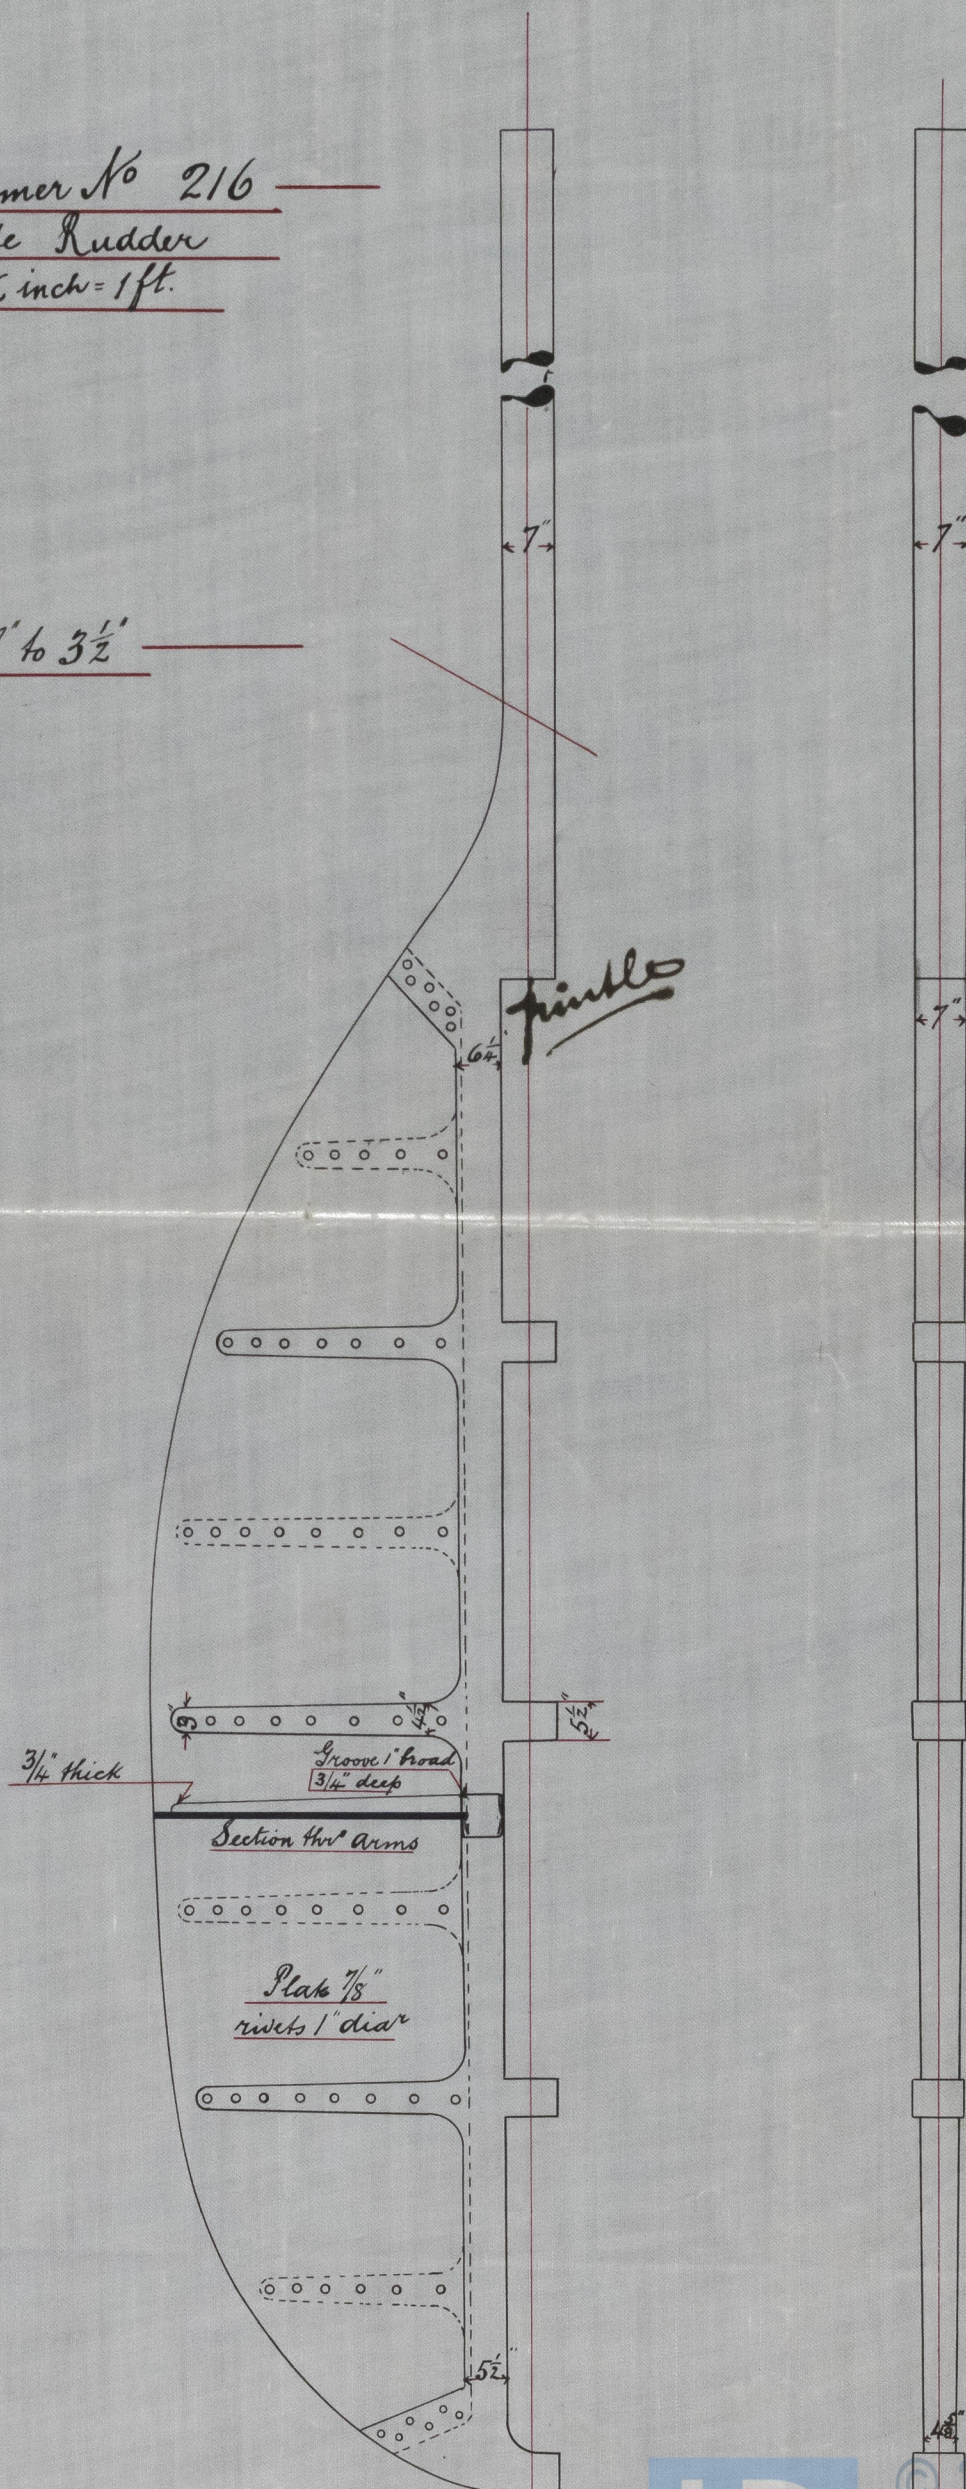

Front Elevation

J.P.L.
19/9/94




© 2021

G. CONNELL & CO.
Lloyd's Register
Foundation

GLS246-0121

17/9/94
J.P.L.

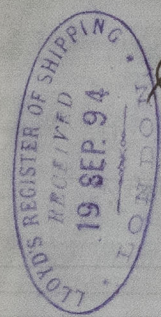

S.S. "Nyron" Glasgow Report No. 13519. —

Chief

19/9/94 JAP



© 2021

Lloyd's Register Foundation