


Screw Steamer No 216  
Plan of Masts.

Rig:- Fore and aft.

Masts built in two plates to the round  
Landings single riveted  
6 $\frac{1}{4}$ " Butt laps triple riveted, 4 $\frac{1}{2}$ " Butt laps double riveted  
Masts doubled at Head & Wedging

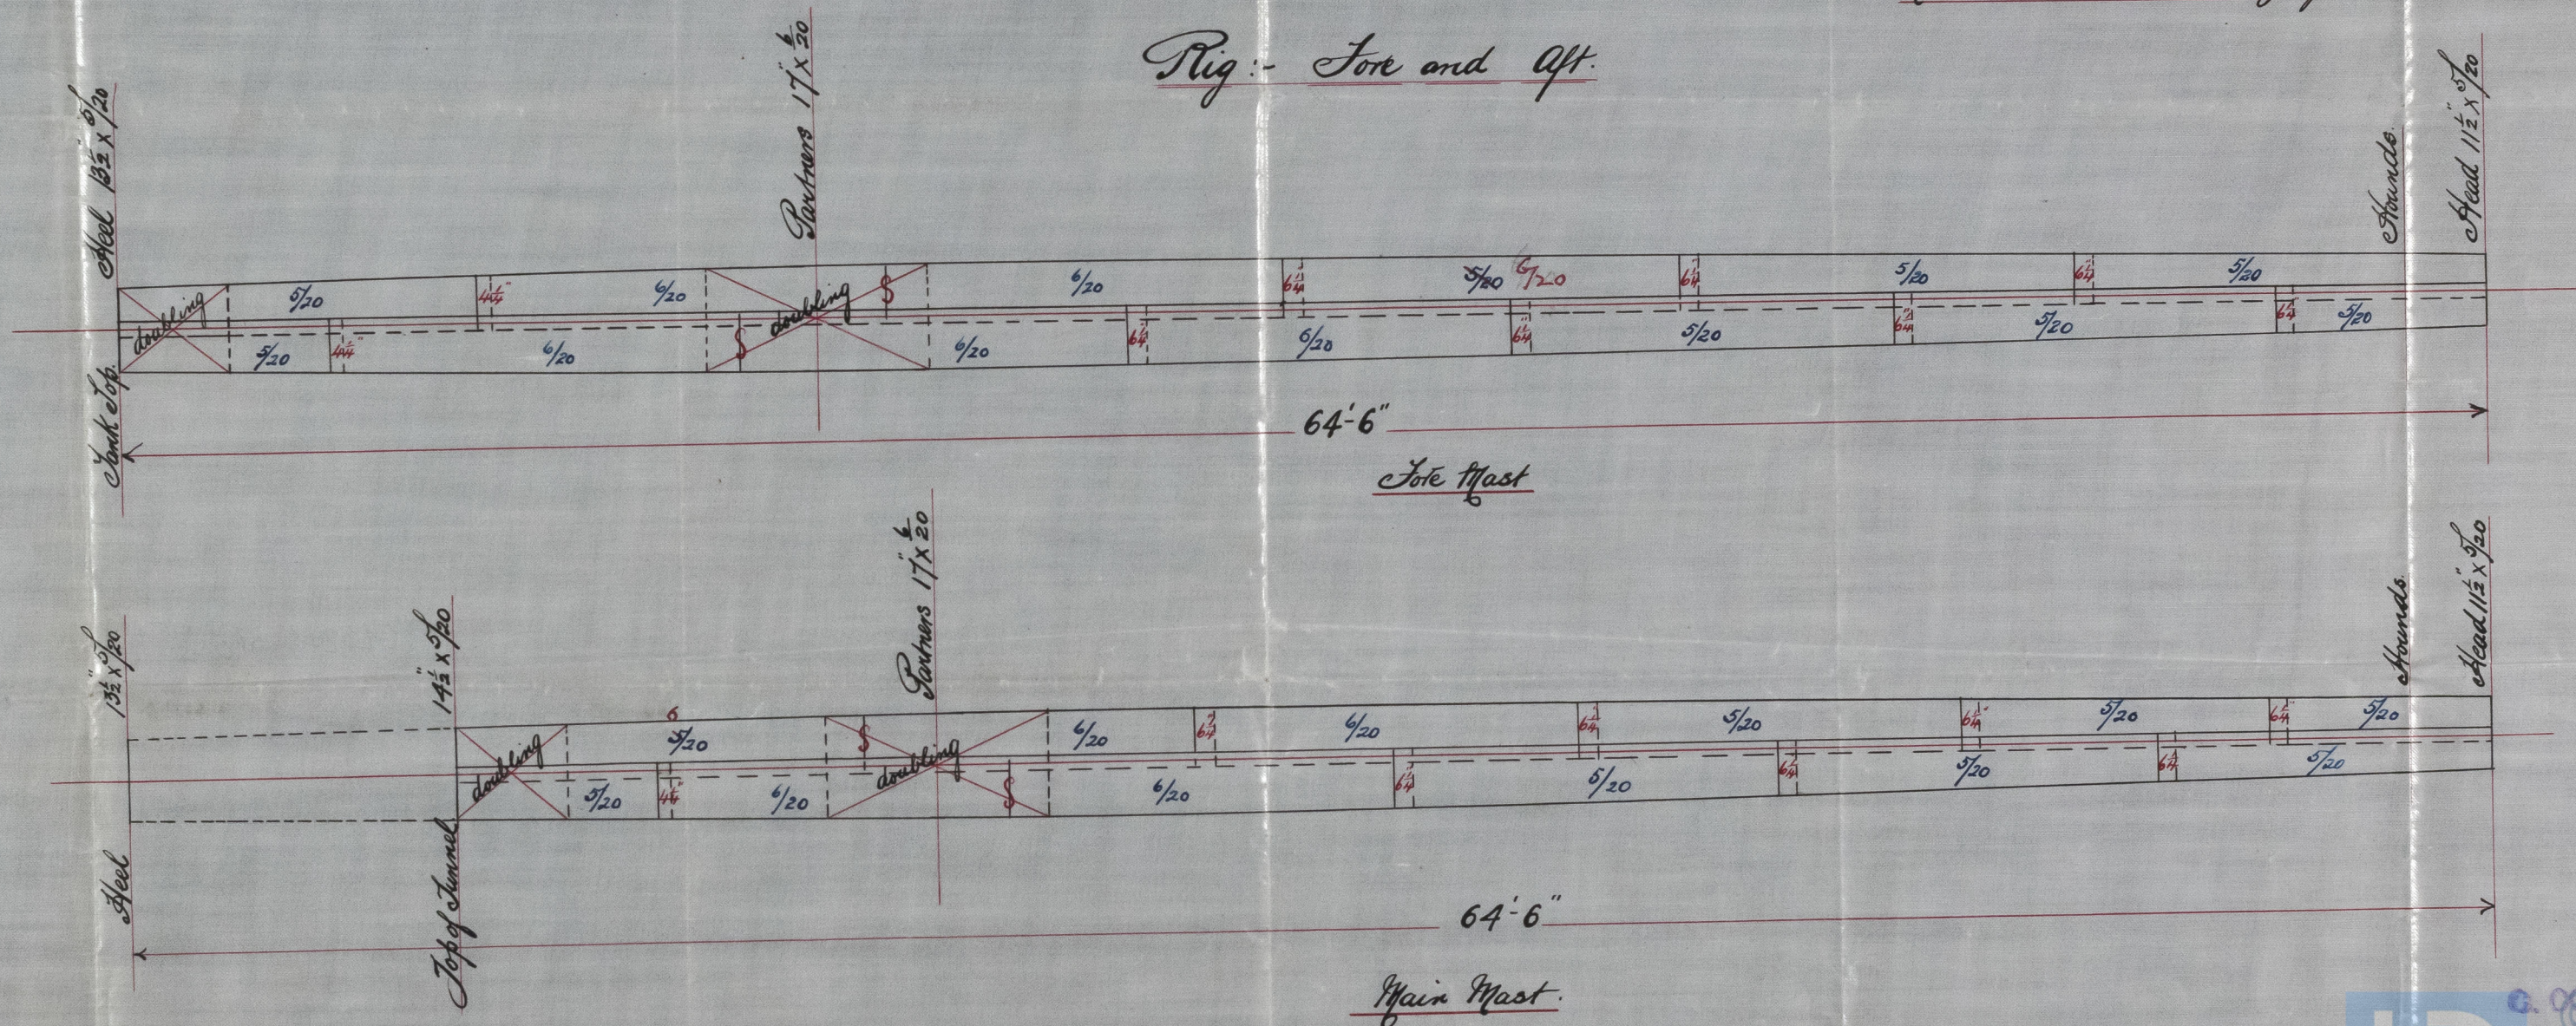

J.V.L.  
19/9/94

G. CONNELL & CO.  
Shipbuilders,  
GLASGOW.

17/9/94  
EML



Report No.

GLS246-0122

J. V. V.  
18/10/18

© 2021

Lloyd's Register  
Foundation