

Lloyd's Register of British and Foreign Shipping.

(Report on Vessel No. 13519 Port Glasgow)No. 4673

SHIP FORGINGS OR CASTINGS.

I have to report that the undermentioned Iron or Steel Forgings or Castings,
manufactured by Messrs. Charles Connell & Co.

of Glasgowfor the Vessel No. 216, being builtby Messrs. Charles Connell & Co. of Glasgow

have been inspected by me as set forth below, and found to be, so far as can be seen,

Sound

Mark on Forgings.

Lloyd's


No. 4673

EC

Frank Cook
Glasgow.

	STERN FRAME.	RUDDER FRAME.	STEM.
Material*	/	<u>Scrap Iron</u>	/
How made		<u>Forged</u>	
Dimensions		<u>7 1/2 x 3 1/2 in</u>	
Progress on Inspection		<u>Forged & omitted</u>	
Date when Inspected		<u>29/10/94. 1.7.30/11/94. 3.24/12/94.</u> <u>9.14.18. 24.28/1/95. 1.8.11/2/95.</u>	

SKETCHES OF FRAMES SHOWING POSITION AND DESCRIPTION OF WELDS OF FORGINGS, OR PARTICULARS OF
TESTS APPLIED TO CASTINGS.

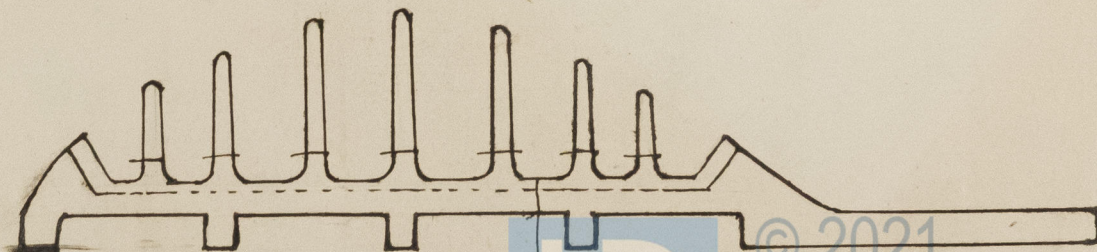

Fee (if any chargeable) £

: : Scarf Welds.

To be paid at

* If of Iron, state whether scrap or puddled Iron.