


2-7-94
2-8-94


PROFILE
S.S. N° 502
SCALE 1/8 INCH = 1 FOOT.


1501

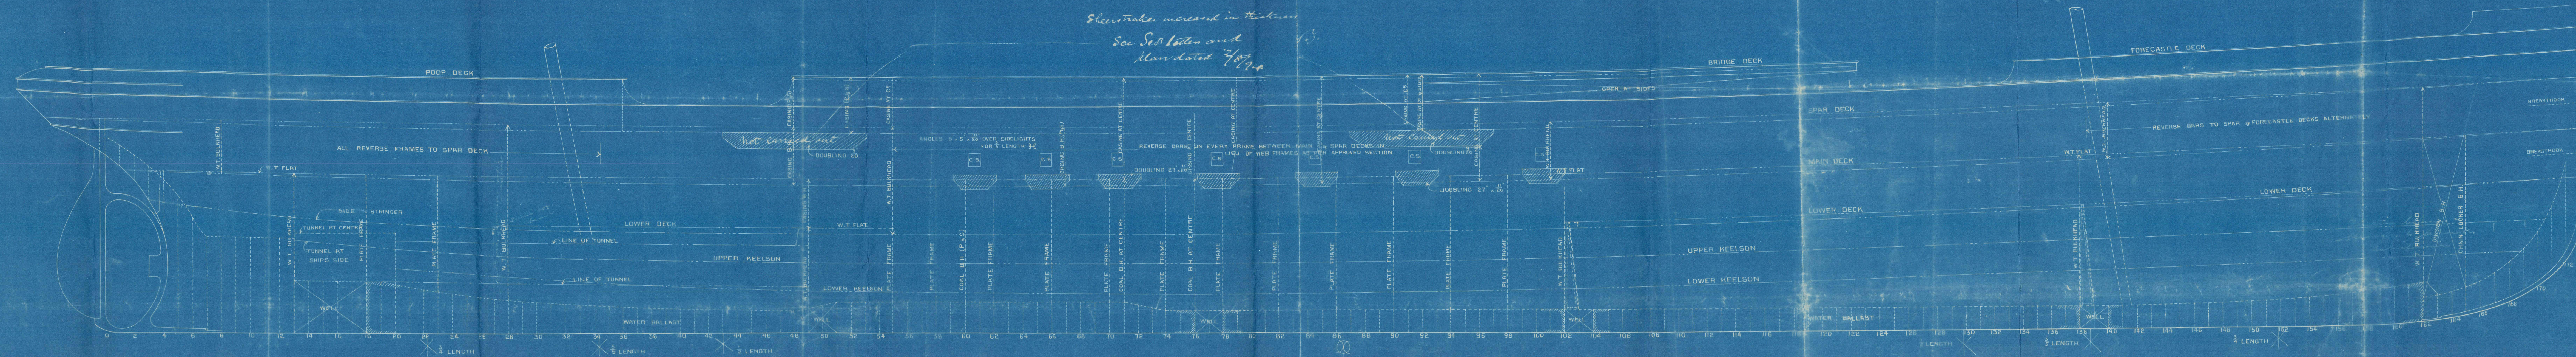

2-8-94

PROPOSED SHEER STRAKE STIFFENING.
S.S. N° 502.
SCALE 1/8 INCH = 1 FOOT.
PLATES INCREASED, CROSSED IN RED

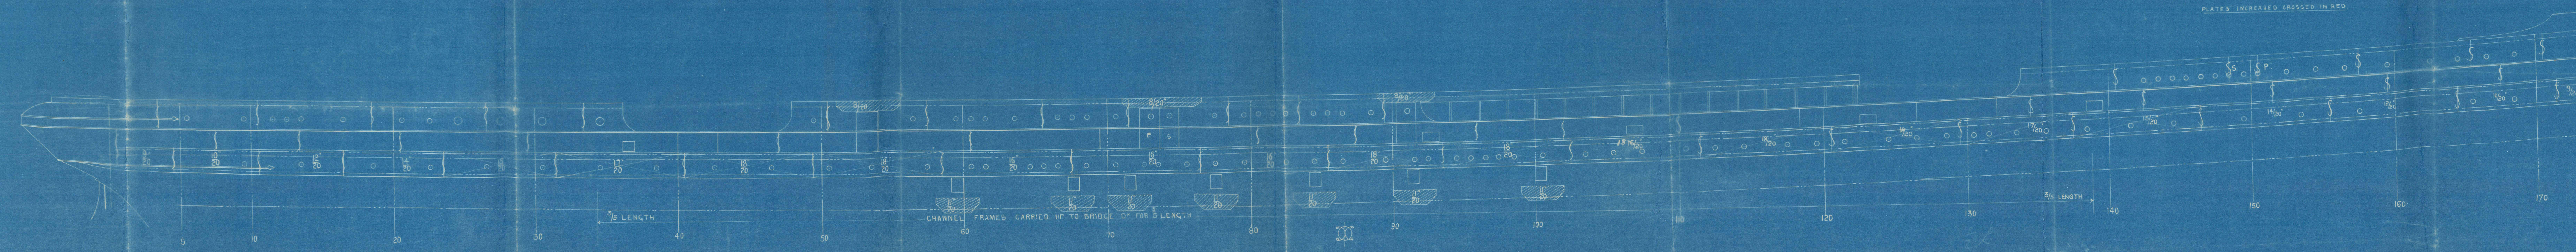

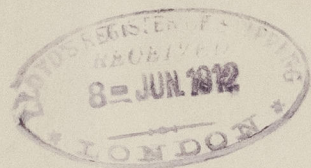

© 2021

Lloyd's Register
Foundation

GLS246-0136