


2-8-94

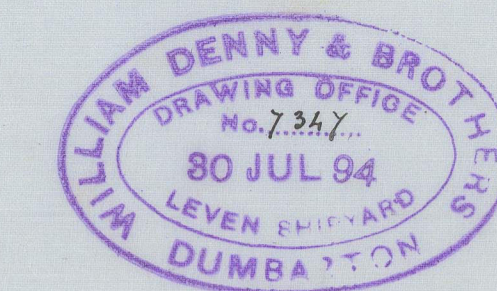


PROPOSED SHEER STRAKE STIFFENING.

S.S. N° 502.

SCALE 1/8 INCH = 1 FOOT.


PLATES INCREASED CROSSED IN RED.

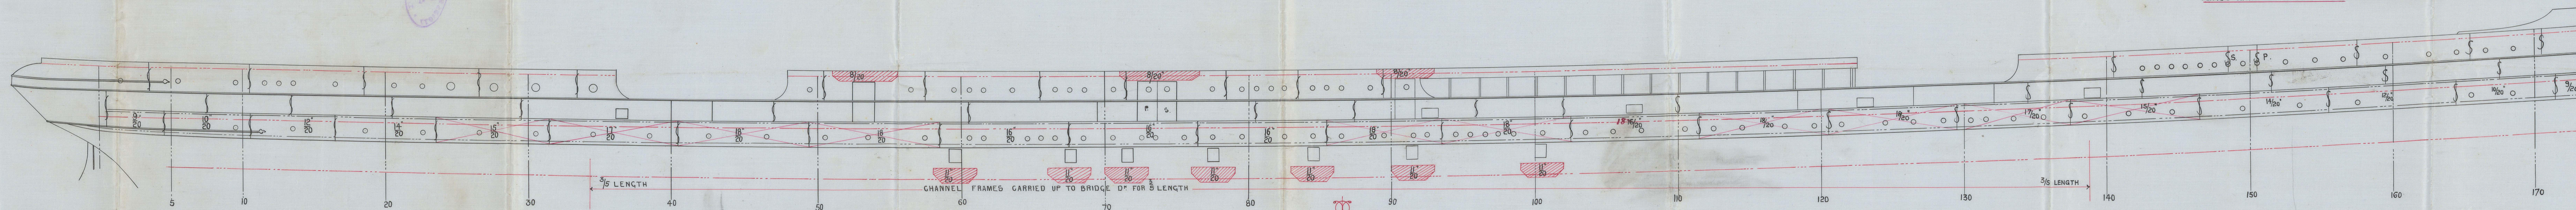



Model "Lloyd's" 1894

14/8
2/8/94

S. S. "Semiramis" Glasgow Report No. 13536.-

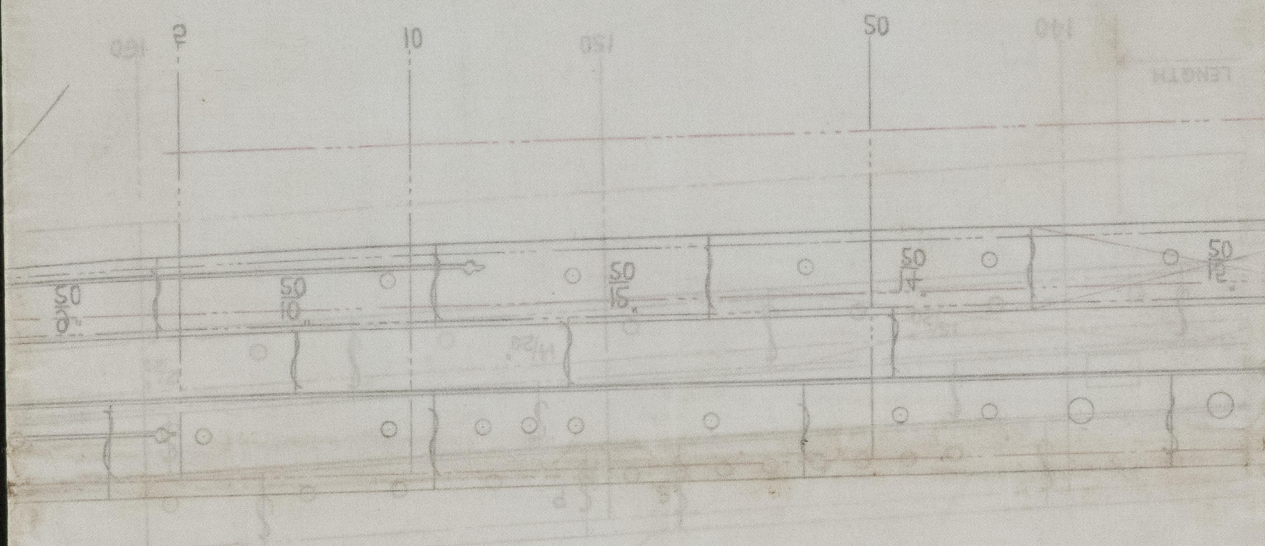

PLATES INCREASED CROSSED IN RED.
SCALE $\frac{1}{8}$ INCH = 1 FOOT.
S.S. No. 502.

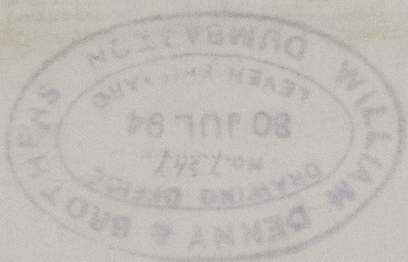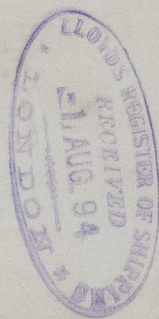

© 2021

Lloyd's Register
Foundation

6-LS246-0146