


7.6.94

SKETCH SHEWING CONNECTION OF STRINGERS TO SHELL PLATING

S S No 502

SCALE 1" = ONE FOOT.

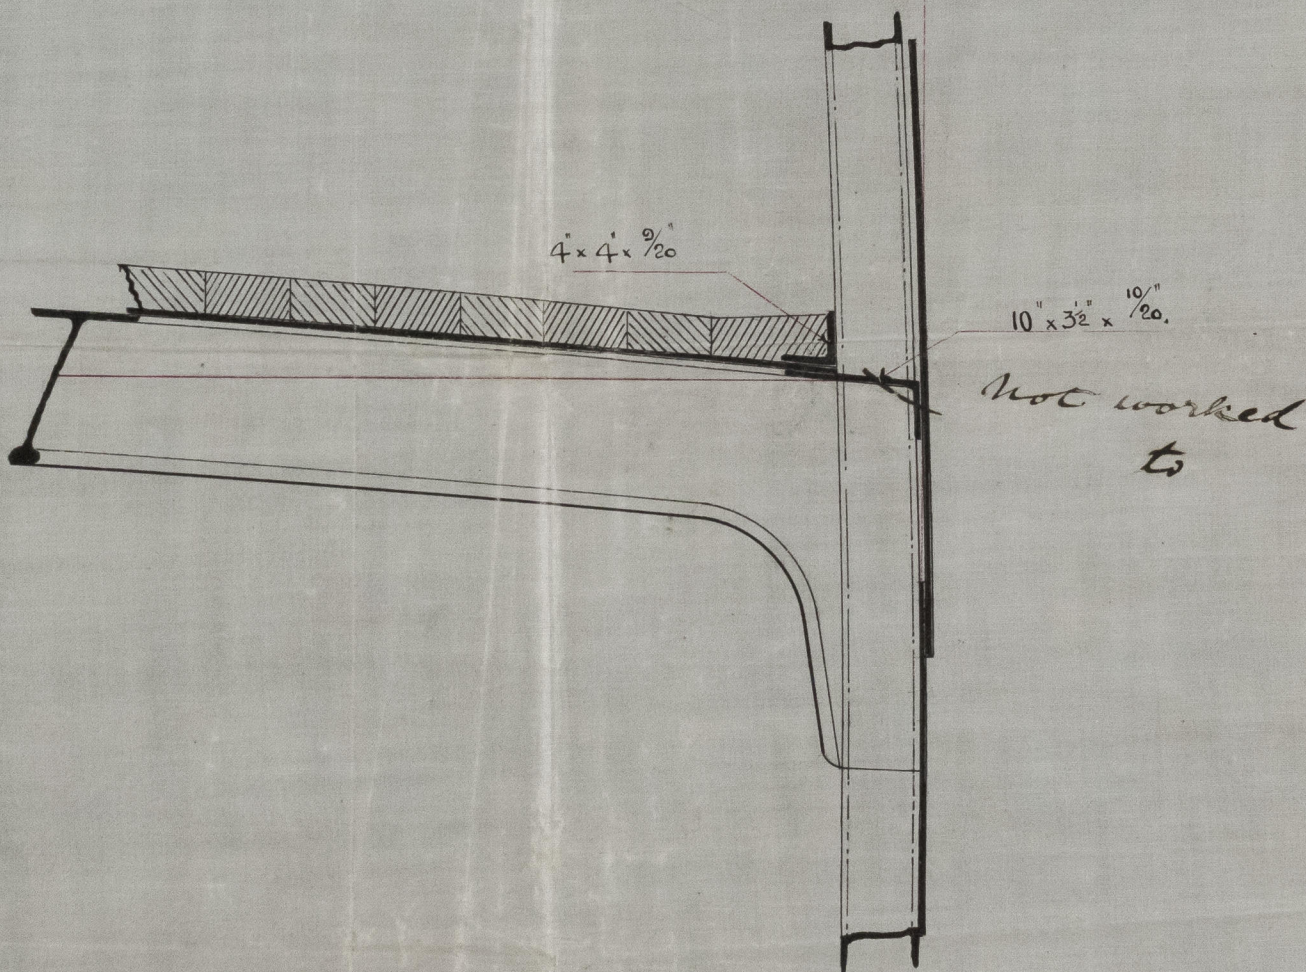

V.B.M.
5/6/94




© 2021

Lloyd's Register
Foundation


625246-0148

Handwritten signature

Handwritten text, possibly "Lloyd's Register"

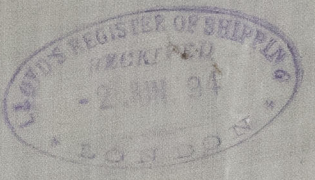

*SHIPS
NOTES*

 


GLS246-0148



Handwritten initials "P. dt"



© 2021
Lloyd's Register
Foundation