

# Lloyd's Register of British and Foreign Shipping.

(Report on Vessel No. 13536 Port Glasgow)  
"Semiramis"

No. 4623 SHIP FORGINGS OR CASTINGS.

The words FORGINGS or CASTINGS, IRON or STEEL, should be struck out as may be required.

I have to report that the undermentioned Iron or Steel Forgings or Castings, manufactured by The Lennystown Forge Co. of Lumbarton, for the Vessel No. 502, being built by Messrs. Wm. Lenny & Bros. of Lumbarton, have been inspected by me as set forth below, and found to be, so far as can be seen, Sound.


Mark on Forgings.

Lloyd's  
No. 4623  
FB

Frank Cook.  
Glasgow  
21/8/94

	STERN FRAME.	RUDDER FRAME.	STEM.
Material*	<u>Scrap Iron</u>		
How made	<u>Forged.</u>		
Dimensions	<u>11" x 6 3/4"</u>		
Progress on Inspection	<u>Forged &amp; omitted</u>		
Date when Inspected	<u>30/5/94. 1. 5. 7. 12. 15. 19. 21. 26.</u> <u>28/6/94. 3. 6. 10. 12. 26. 31/7/94.</u>		

SKETCHES OF FRAMES SHOWING POSITION AND DESCRIPTION OF WELDS OF FORGINGS, OR PARTICULARS OF TESTS APPLIED TO CASTINGS.

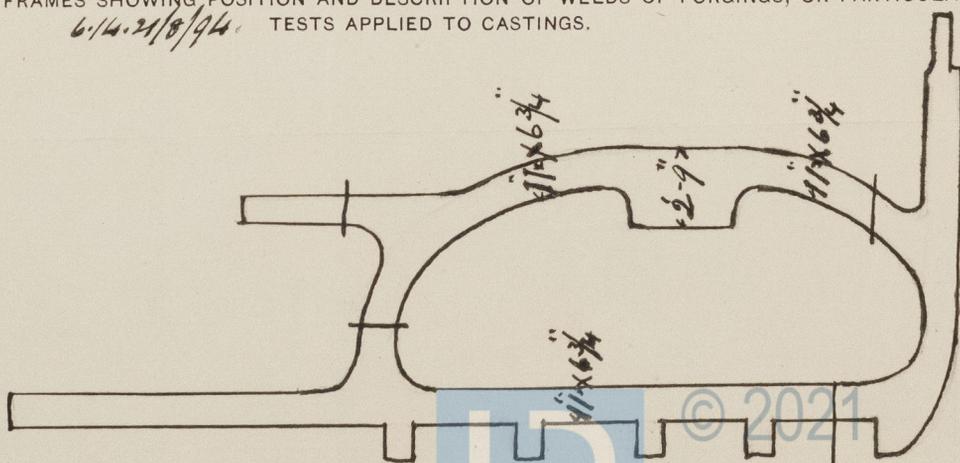

Glut Welds

\* If of Iron, state whether scrap or puddled Iron.