

Lloyd's Register of British and Foreign Shipping.

(Report on Vessel No. 13688 Port Glasgow)

"Bengalee"

No. 4725 SHIP FORGINGS ~~OR CASTINGS~~.

The words FORGINGS or CASTINGS, IRON or STEEL, should be struck out as may be required.

I have to report that the undermentioned Iron ~~or Steel~~ Forgings ~~or Castings~~,
manufactured by Messrs Robt Kerr & Sons
of Irvine for the Vessel No. 395, being built
by Messrs Barclay Curle & Co of Glasgow
have been inspected by me as set forth below, and found to be, so far as can be seen,
Sound & efficient


Mark on Forgings.

Lloyd's
No. 4725
W. H

William Hamilton
Glasgow
29/11/94

	STERN FRAME.	RUDDER FRAME.	STEM.
Material*	<u>Scrap iron</u>		
How made	<u>Forged</u>		
Dimensions	<u>11 x 6 1/2 x 12 x 6</u>		
Progress on Inspection	<u>Forging & smithing</u>		
Date when Inspected	<u>10. 15. 20. 25. 27/10/94</u> <u>2. 5. 6. 9. 14. 16 28/11/94</u>		

SKETCHES OF FRAMES SHOWING POSITION AND DESCRIPTION OF WELDS OF FORGINGS, OR PARTICULARS OF TESTS APPLIED TO CASTINGS.

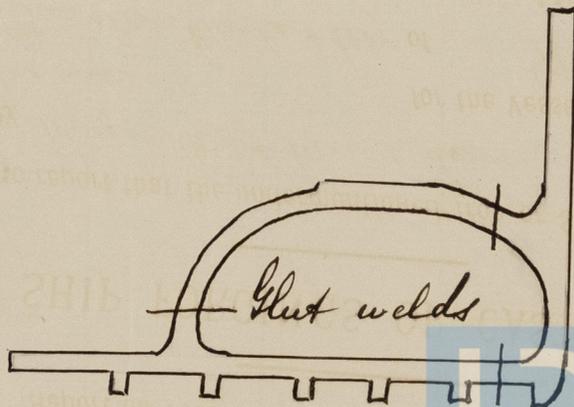

Fee (if any chargeable) £ : :

To be paid at _____

* If of Iron, state whether scrap or puddled Iron.