

Lloyd's Register of British and Foreign Shipping.

(Report on Vessel No. 13688 Port Glasgow)

No. 4725 SHIP FORGINGS OR CASTINGS.

I have to report that the undermentioned Iron or ~~Steel~~ Forgings or Castings, manufactured by Mess Robt Kerr & Sons of Irvine for the Vessel No. 395, being built by Mess Barclay Curle & Coy of Glasgow have been inspected by me as set forth below, and found to be, so far as can be seen, Sound & Efficient


Mark on Forgings.

Lloyd's
No. 4725
W.H.

William Hamilton
Glasgow 25/1/95

	STERN FRAME.	RUDDER FRAME.	STEM.
Material*		<u>Scrap iron</u>	
How made		<u>Forged</u>	
Dimensions		<u>8 1/2</u>	
Progress on Inspection		<u>Forging & smithing</u>	
Date when Inspected		<u>6. 9. 16. 26. 30/11/94</u> <u>4. 10. 17. 28/12/94. 9. 15</u> <u>16. 21. 23/1/95</u>	

SKETCHES OF FRAMES SHOWING POSITION AND DESCRIPTION OF WELDS OF FORGINGS, OR PARTICULARS OF TESTS APPLIED TO CASTINGS.

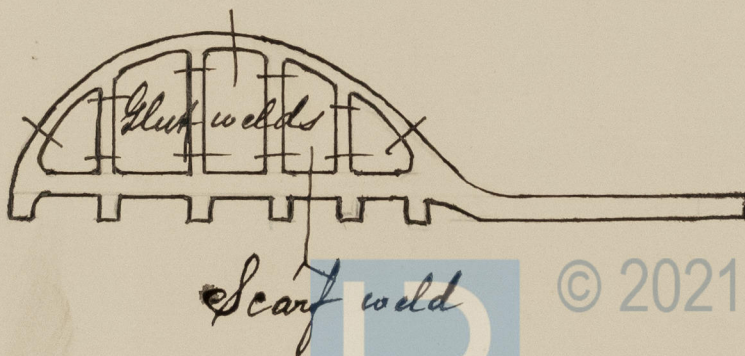

Fee (if any chargeable) £ : :

To be paid at _____

* If of Iron, state whether scrap or puddled Iron.