



6.9.94
11.10.94
20.10.94
30.10.94

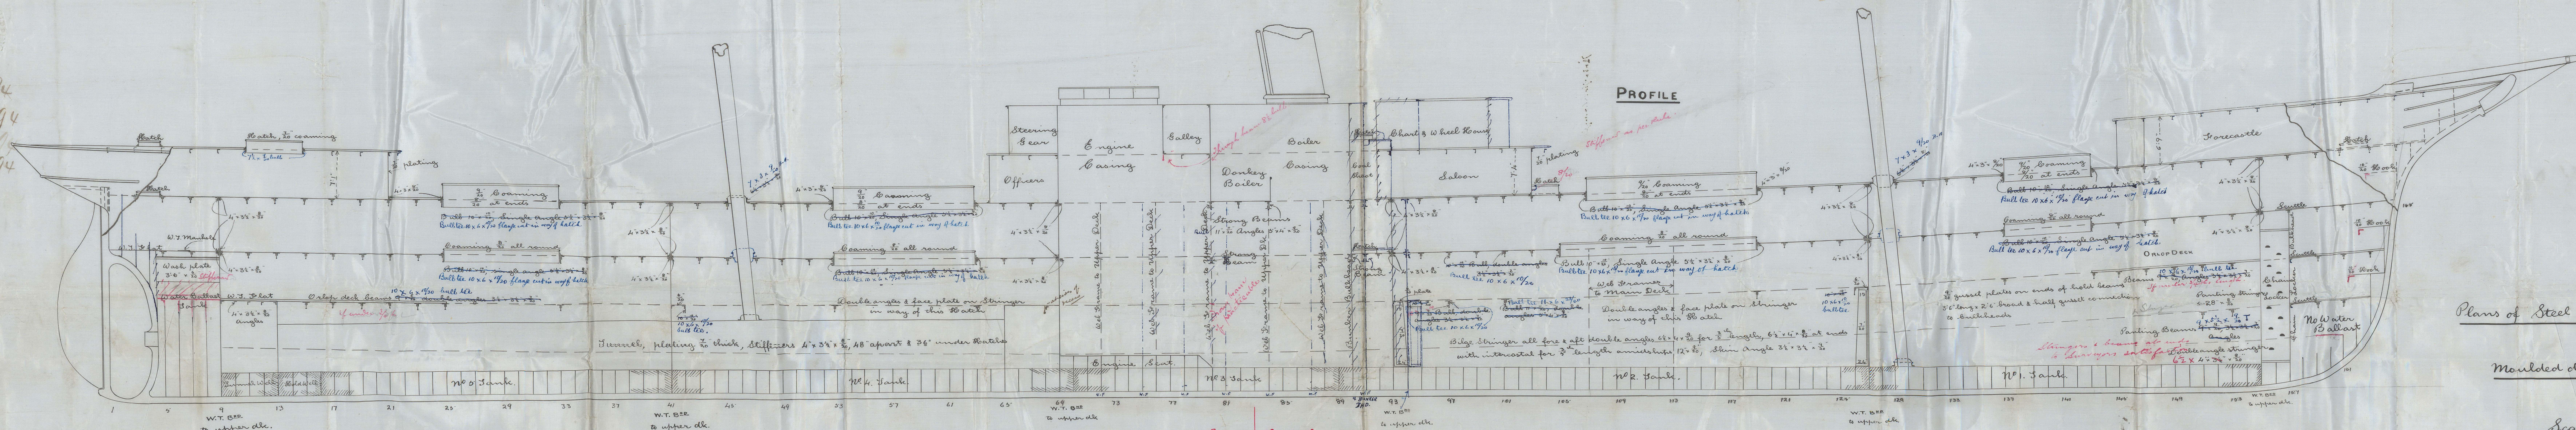


Plans of Steel Screw Steamer No 395
Moulded dimensions 330 x 41'6" x 27'0"


Scale 1/8" = one foot.

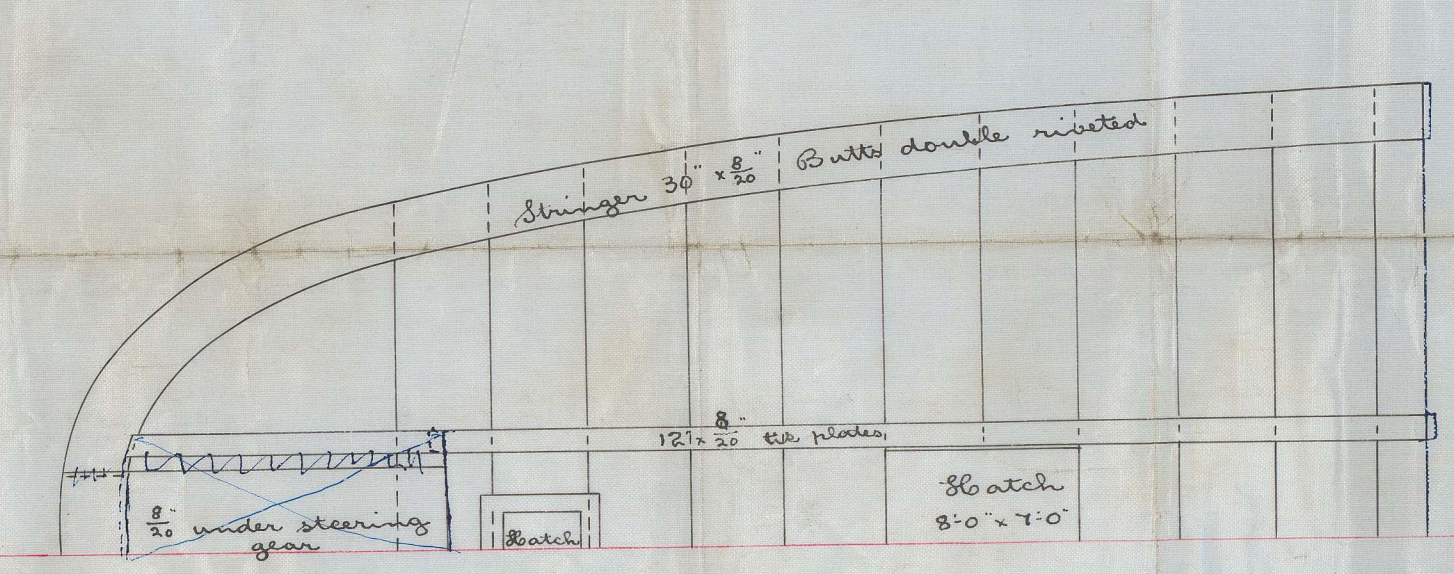


Poop Deck

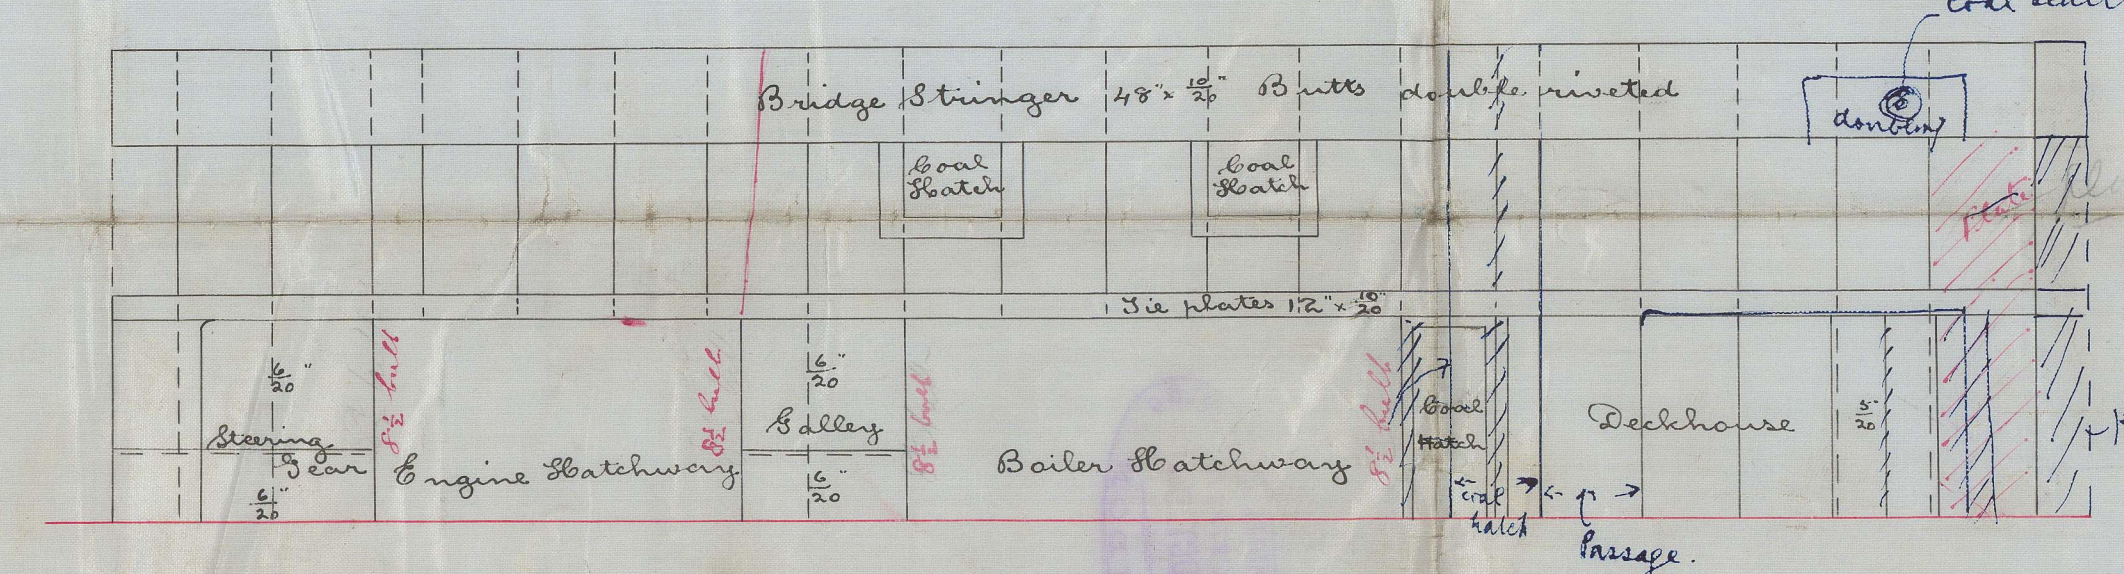

Bridge Deck

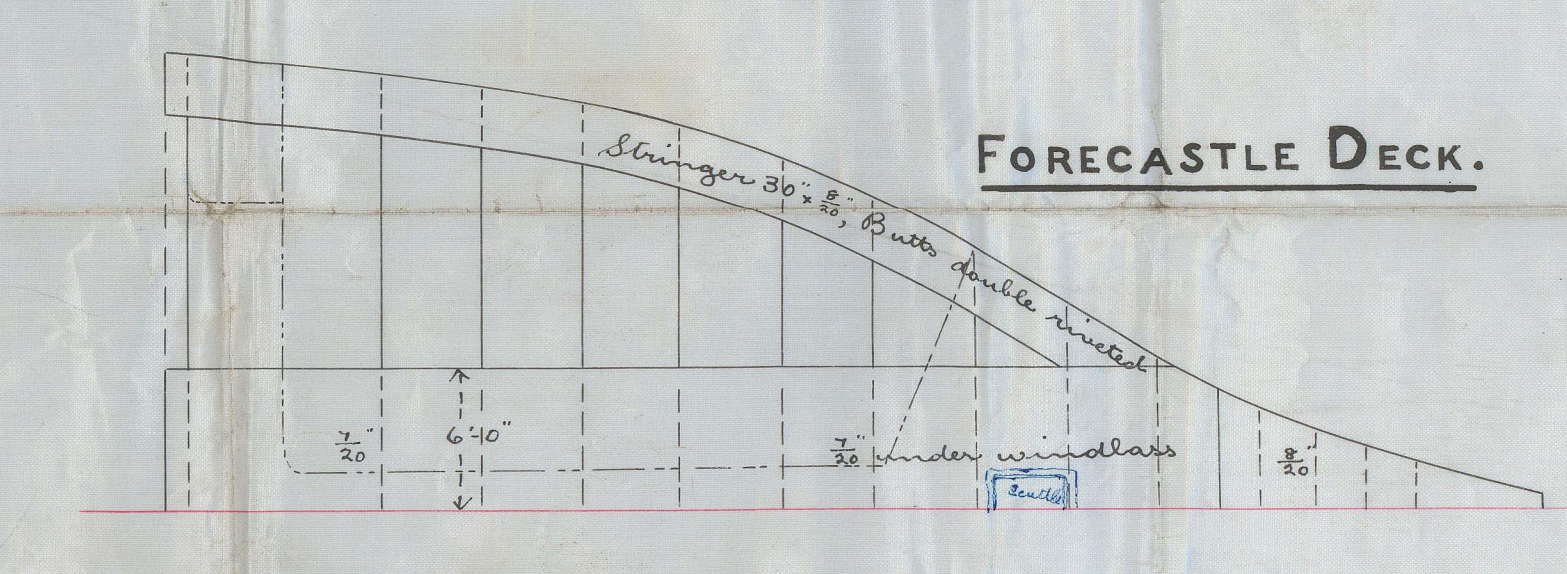

Forecastle Deck

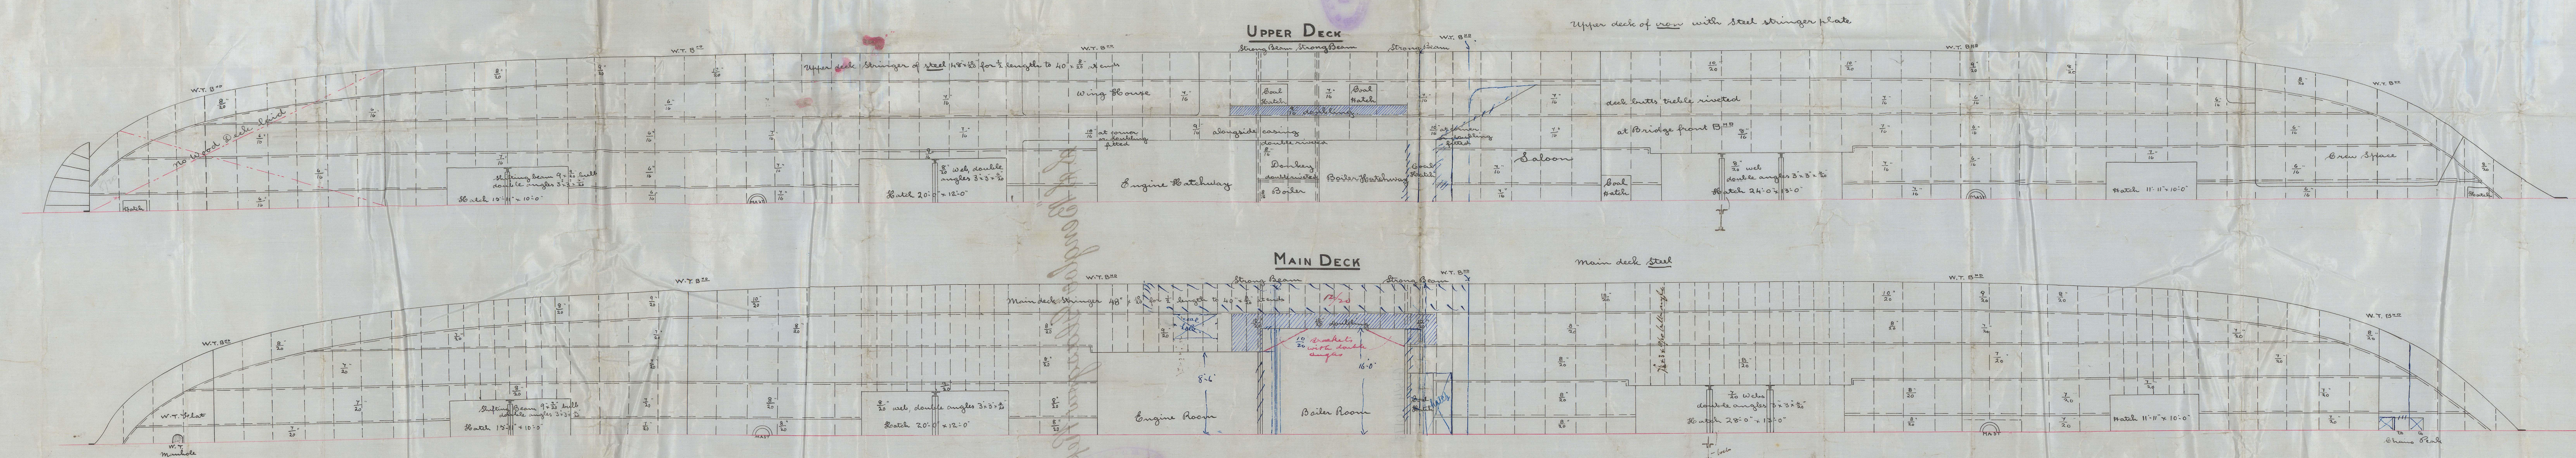

Main Deck

Alterations in blue are according to ship's drawings.

J.W.
30.10.94

645241-0173

S.S. "Bengloe" Glasgow Report No. 1368

MAIN DECK

GL5247-0173

© 2021

Lloyd's Register
Foundation