



20.10.94




19/10/94

Clear of line

Clear of line

Clear of line

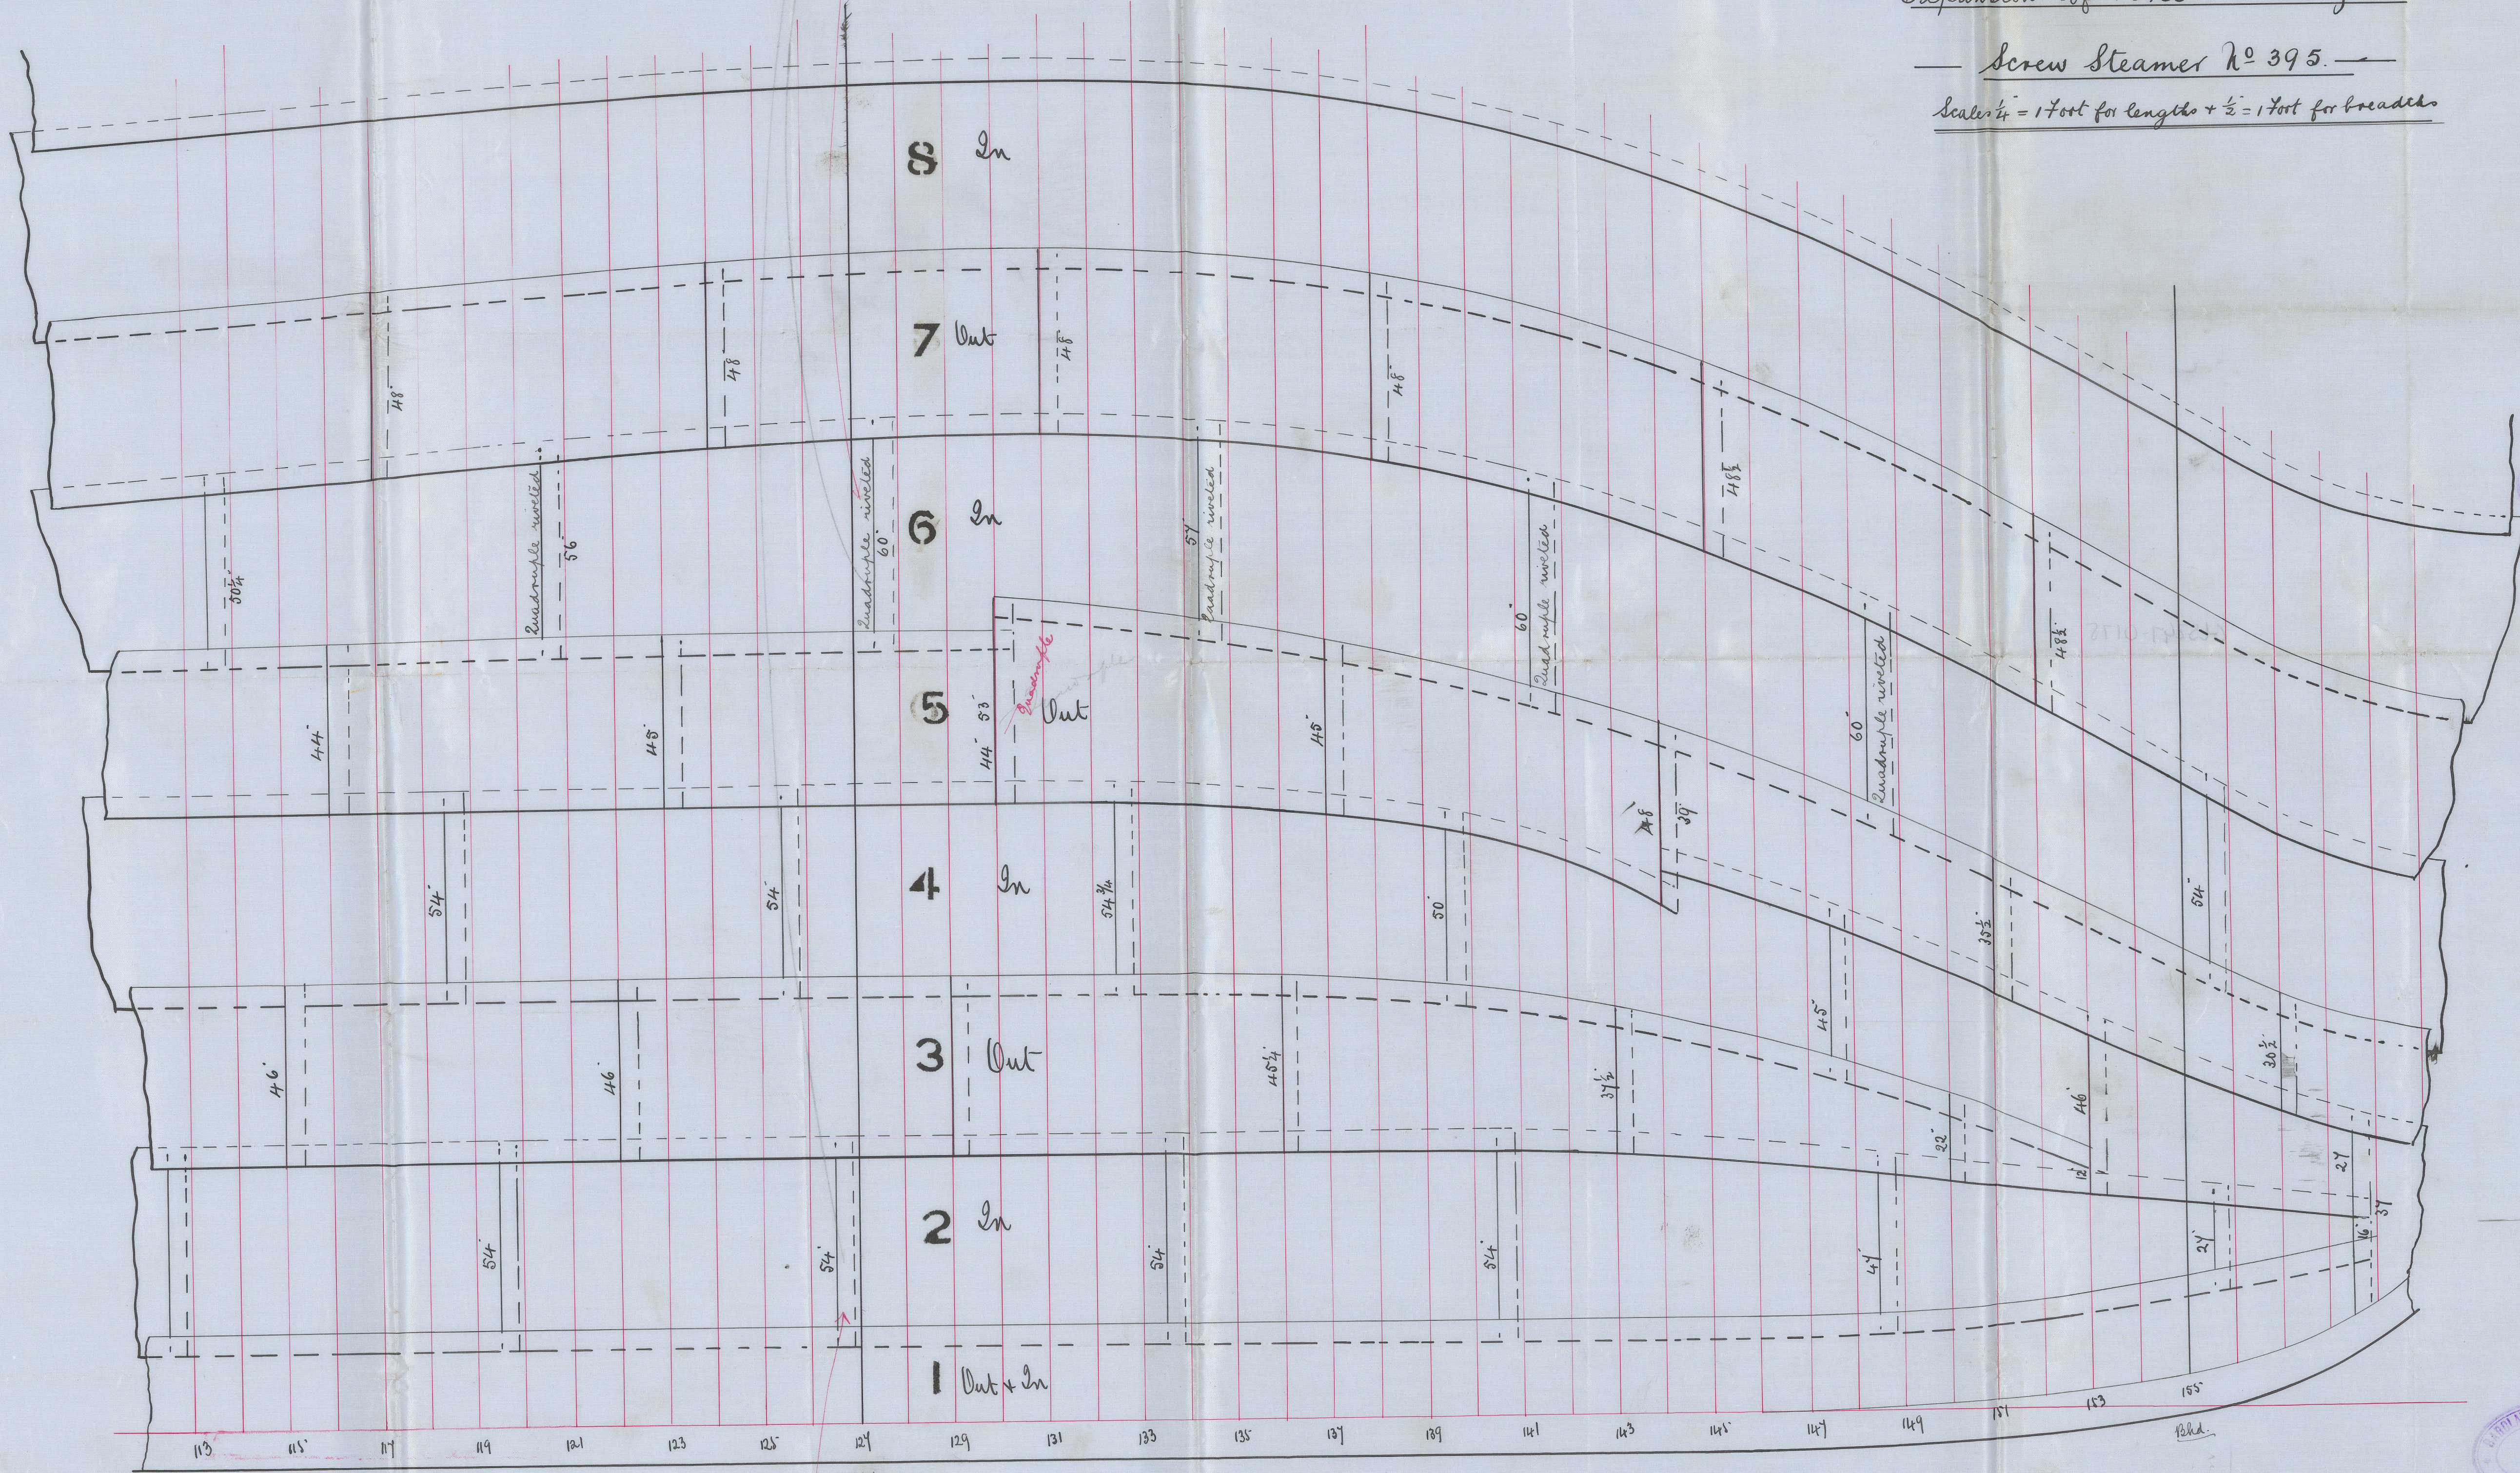

Expansion of Shell Plating for

Screw Steamer No 395.

Scale $\frac{1}{4}$ " = 1 foot for lengths + $\frac{1}{2}$ " = 1 foot for breadths




2.11
18/10/94

"
S.S. "Bengloe" Glasgow Report No. 13688.

10-10-99
— of shell plating for

— 2 PE of remanent metal

— $\frac{1}{4} = 1 \frac{1}{2}$ for length $\times \frac{1}{2} = 1 \frac{1}{2}$ for breadth

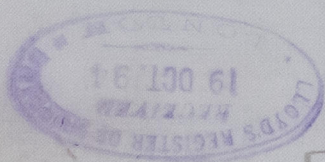

© 2021

Lloyd's Register
Foundation

GLS247-0175