


30.10.94


PLAN OF MAIN DECK.

£. £. N° 395.

SCALE 1/4" = 8' FOOT.

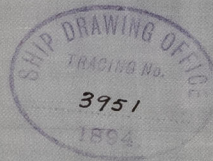


doubling extends  
aft to 12 beam.

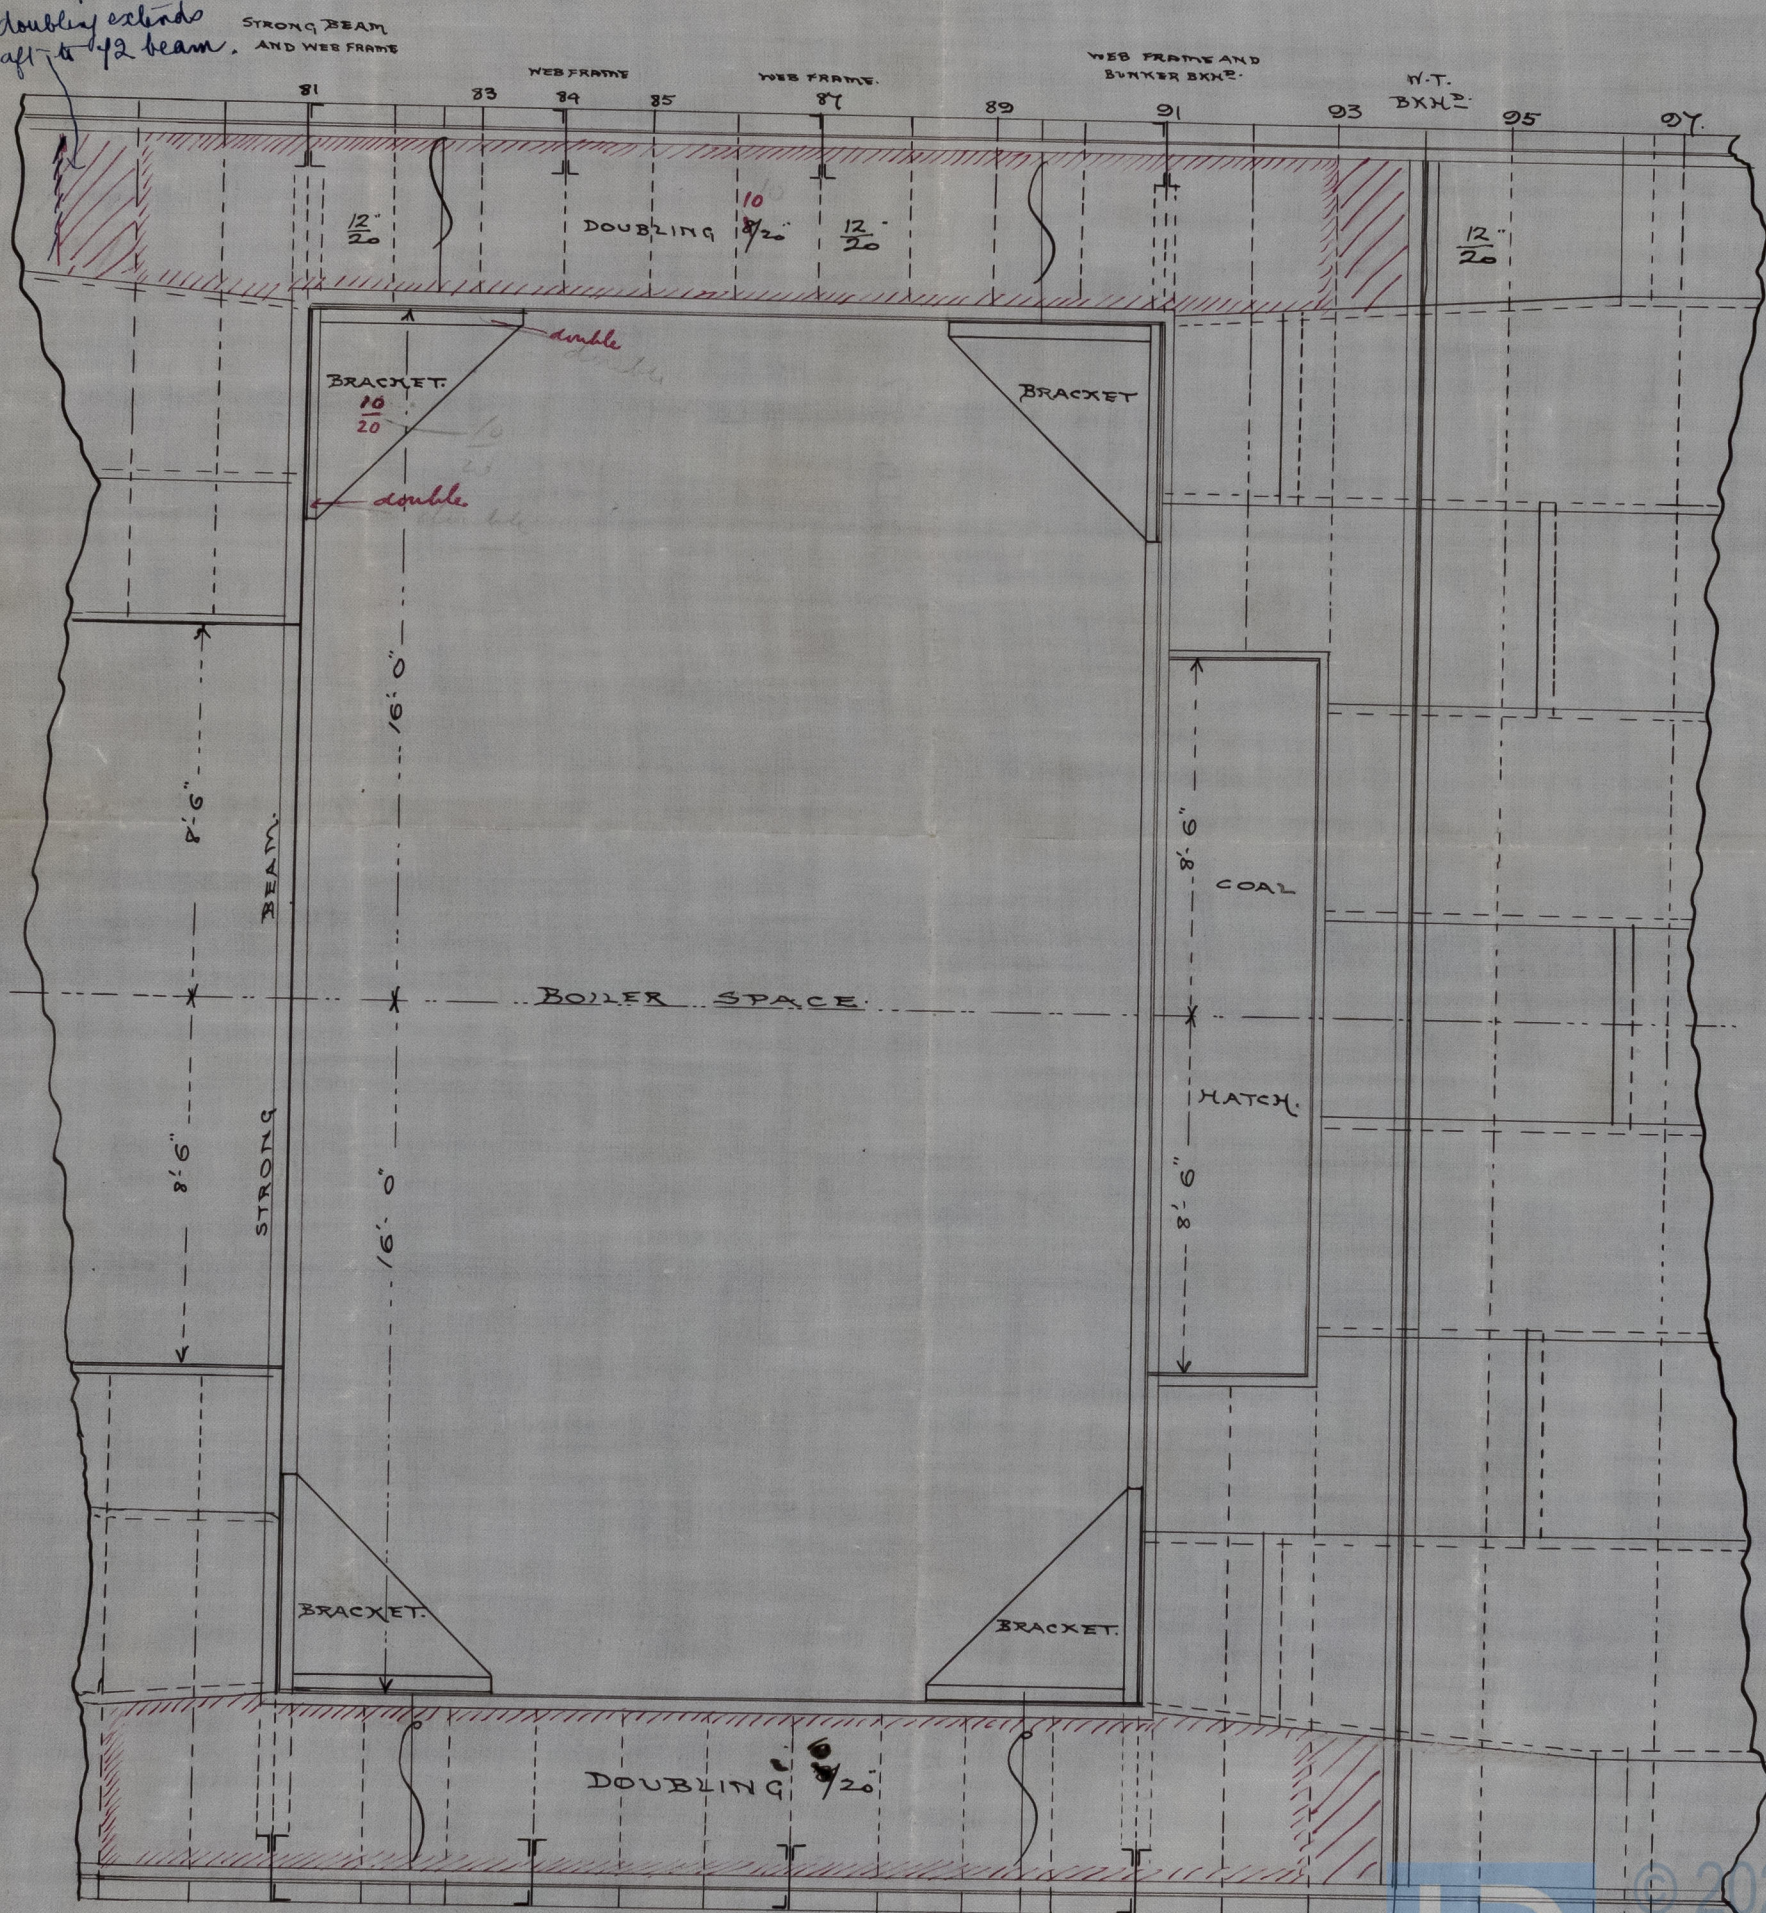



S.S. "Bengloe" Glasgow Report No. 13688.

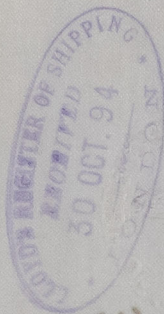

44.6.03

AM TO NA 19

Case 4 100  
116 92



chairs present  
strong and  
new and  
mast 14 ft 1/2

MEASUREMENTS  
21  
82  
84  
85



© 2021

Lloyd's Register  
Foundation

615247-0178