
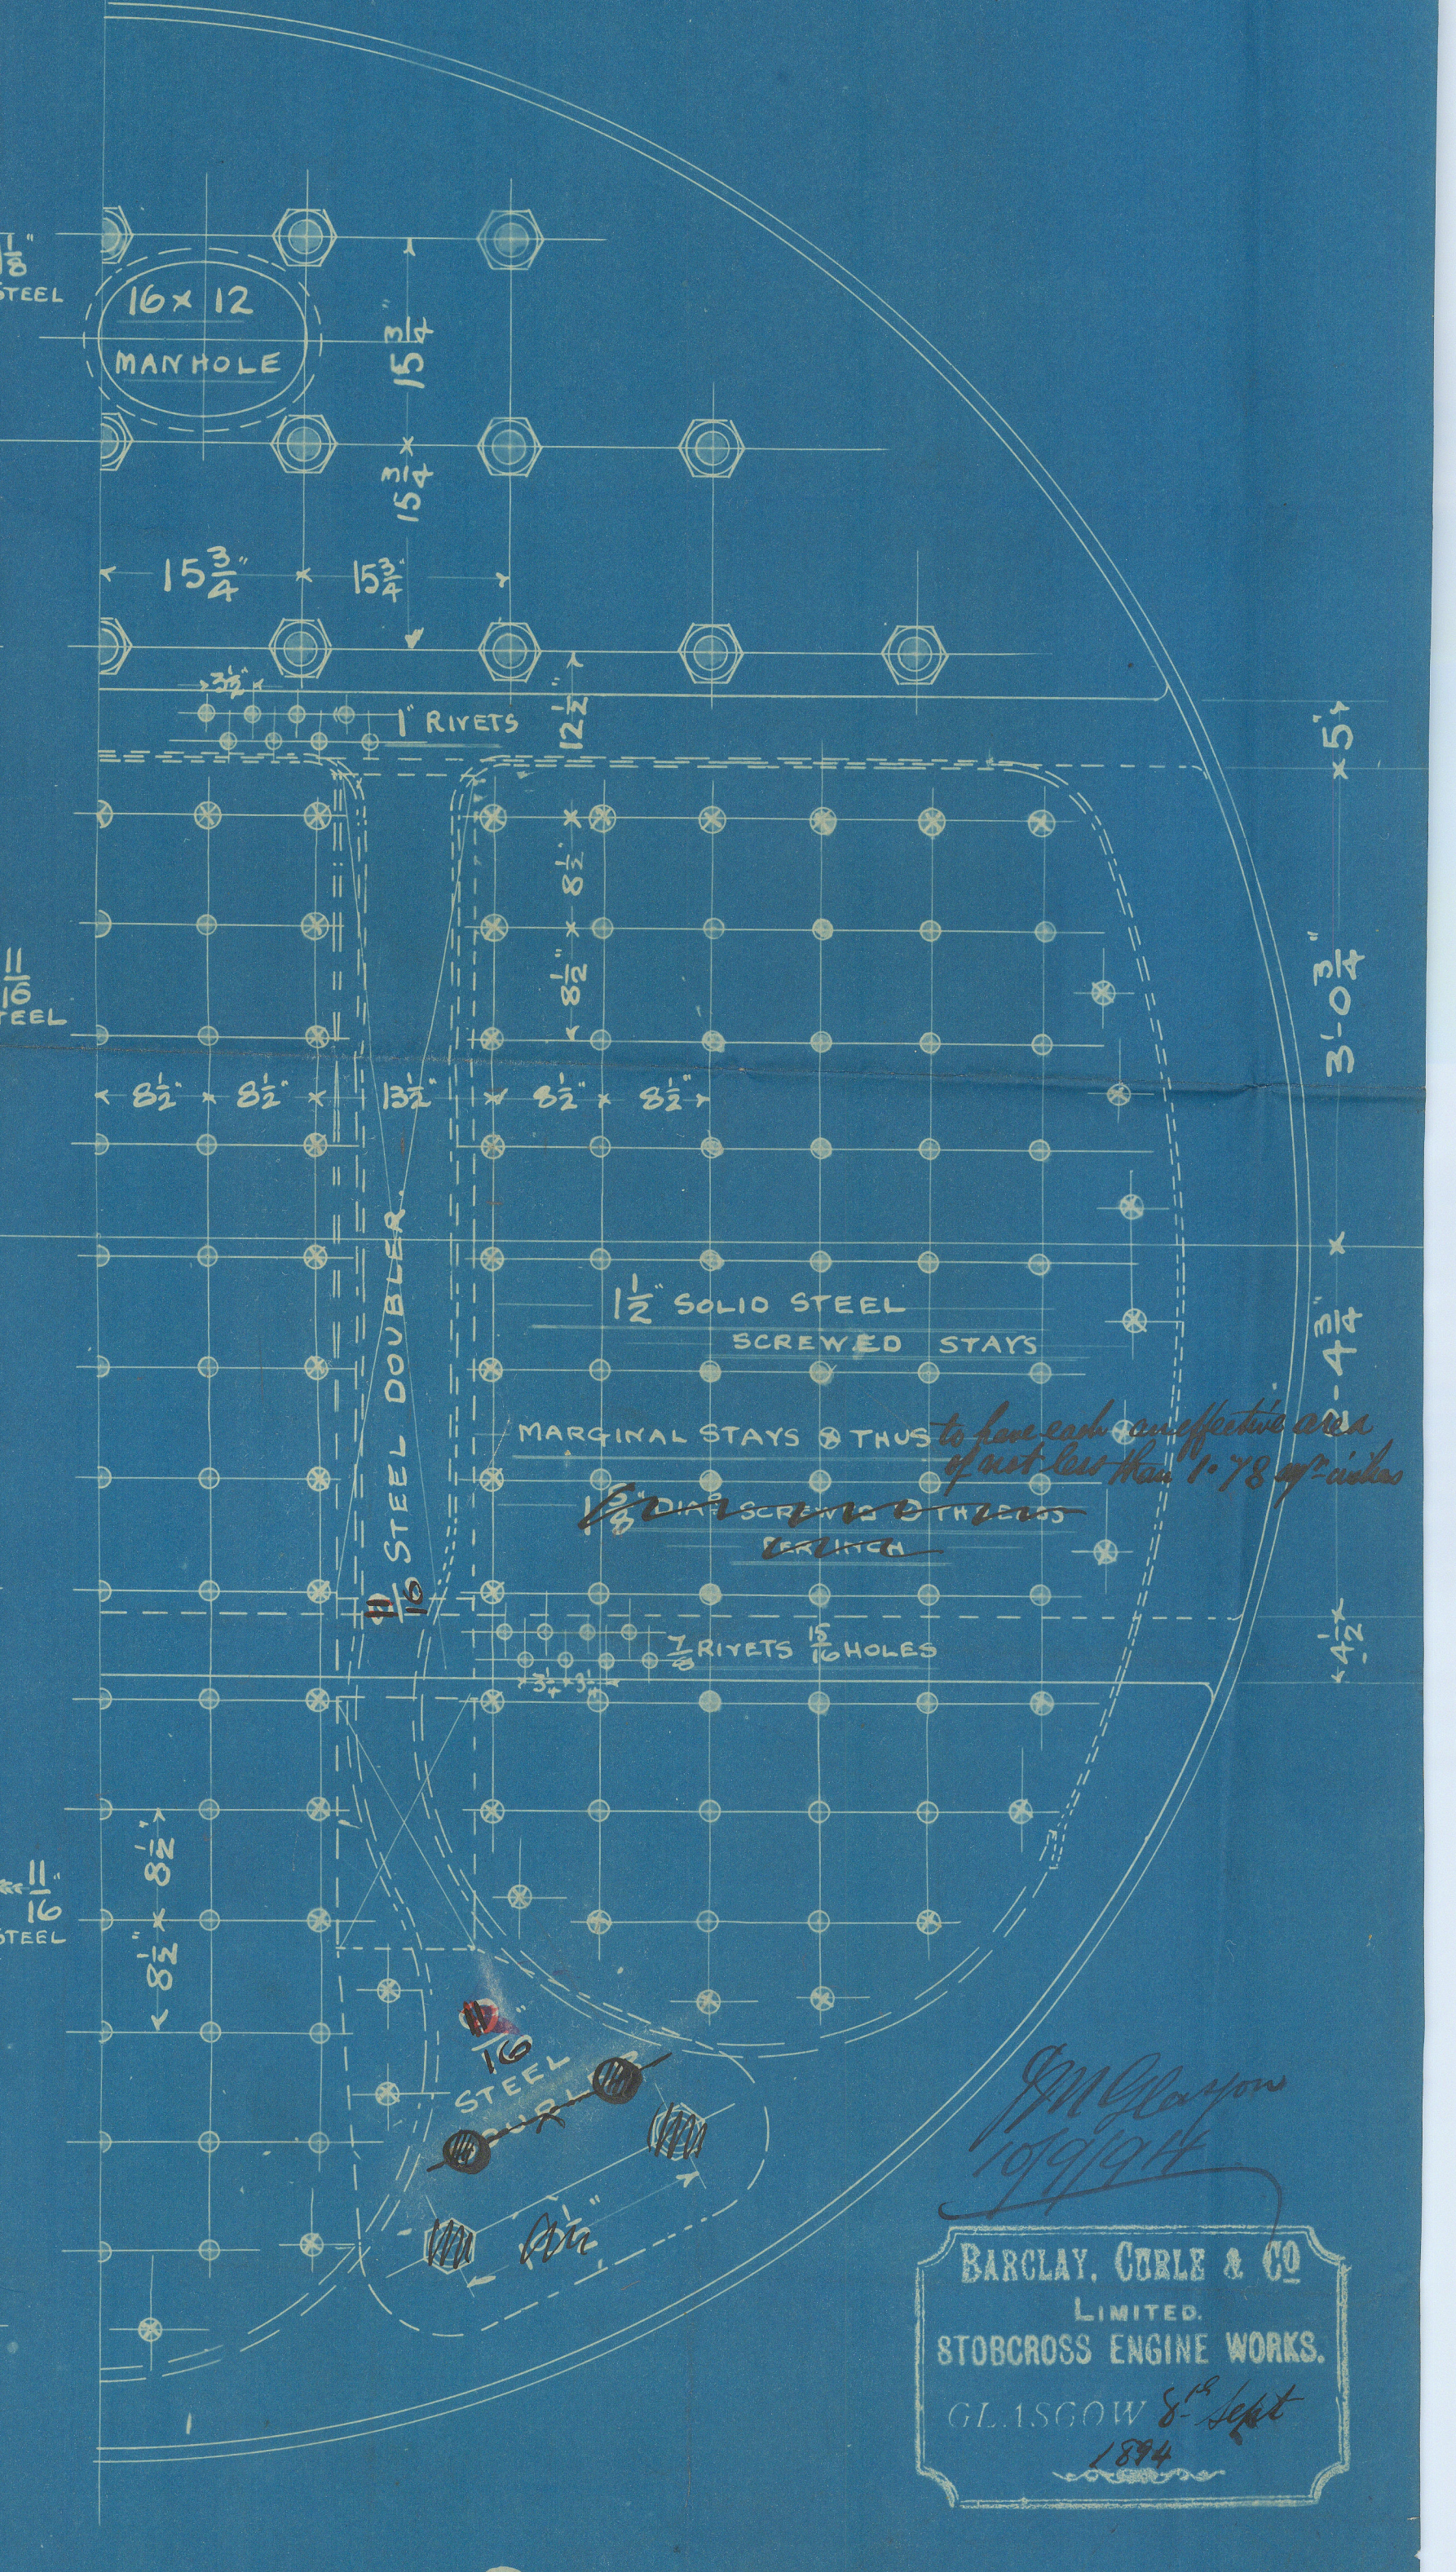
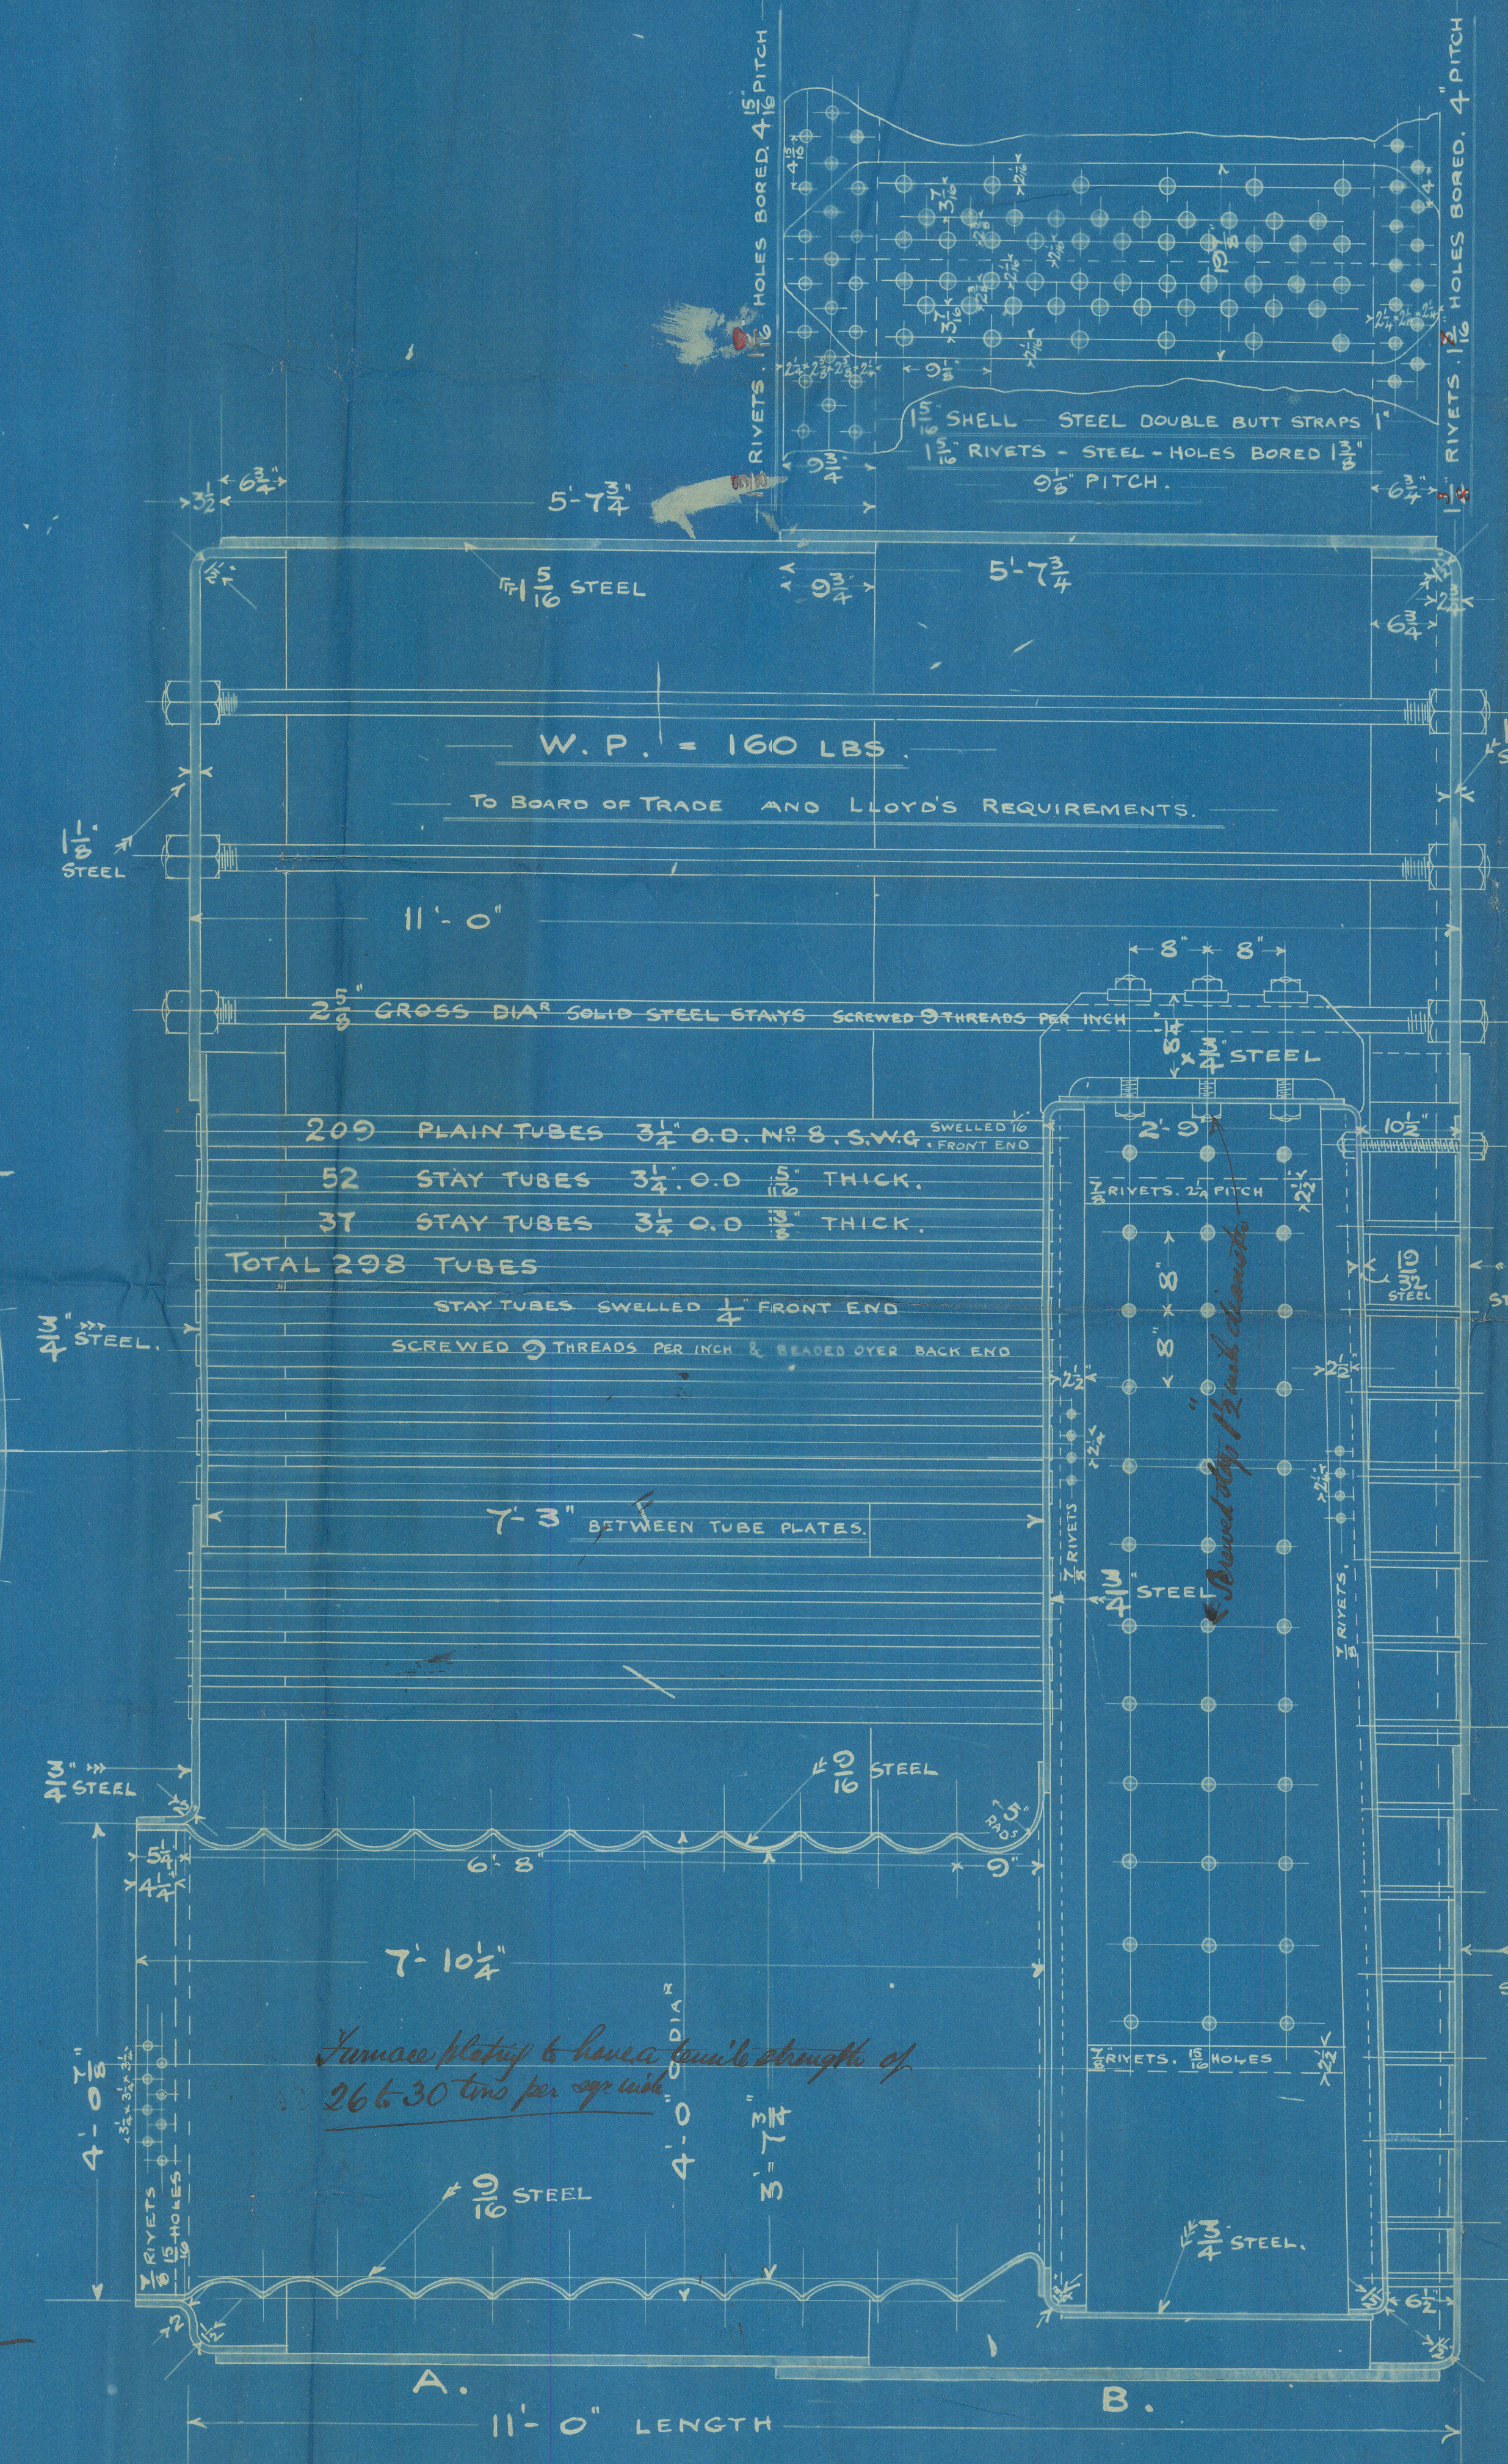


Ltr. 12: 4.94
 12: 4.94

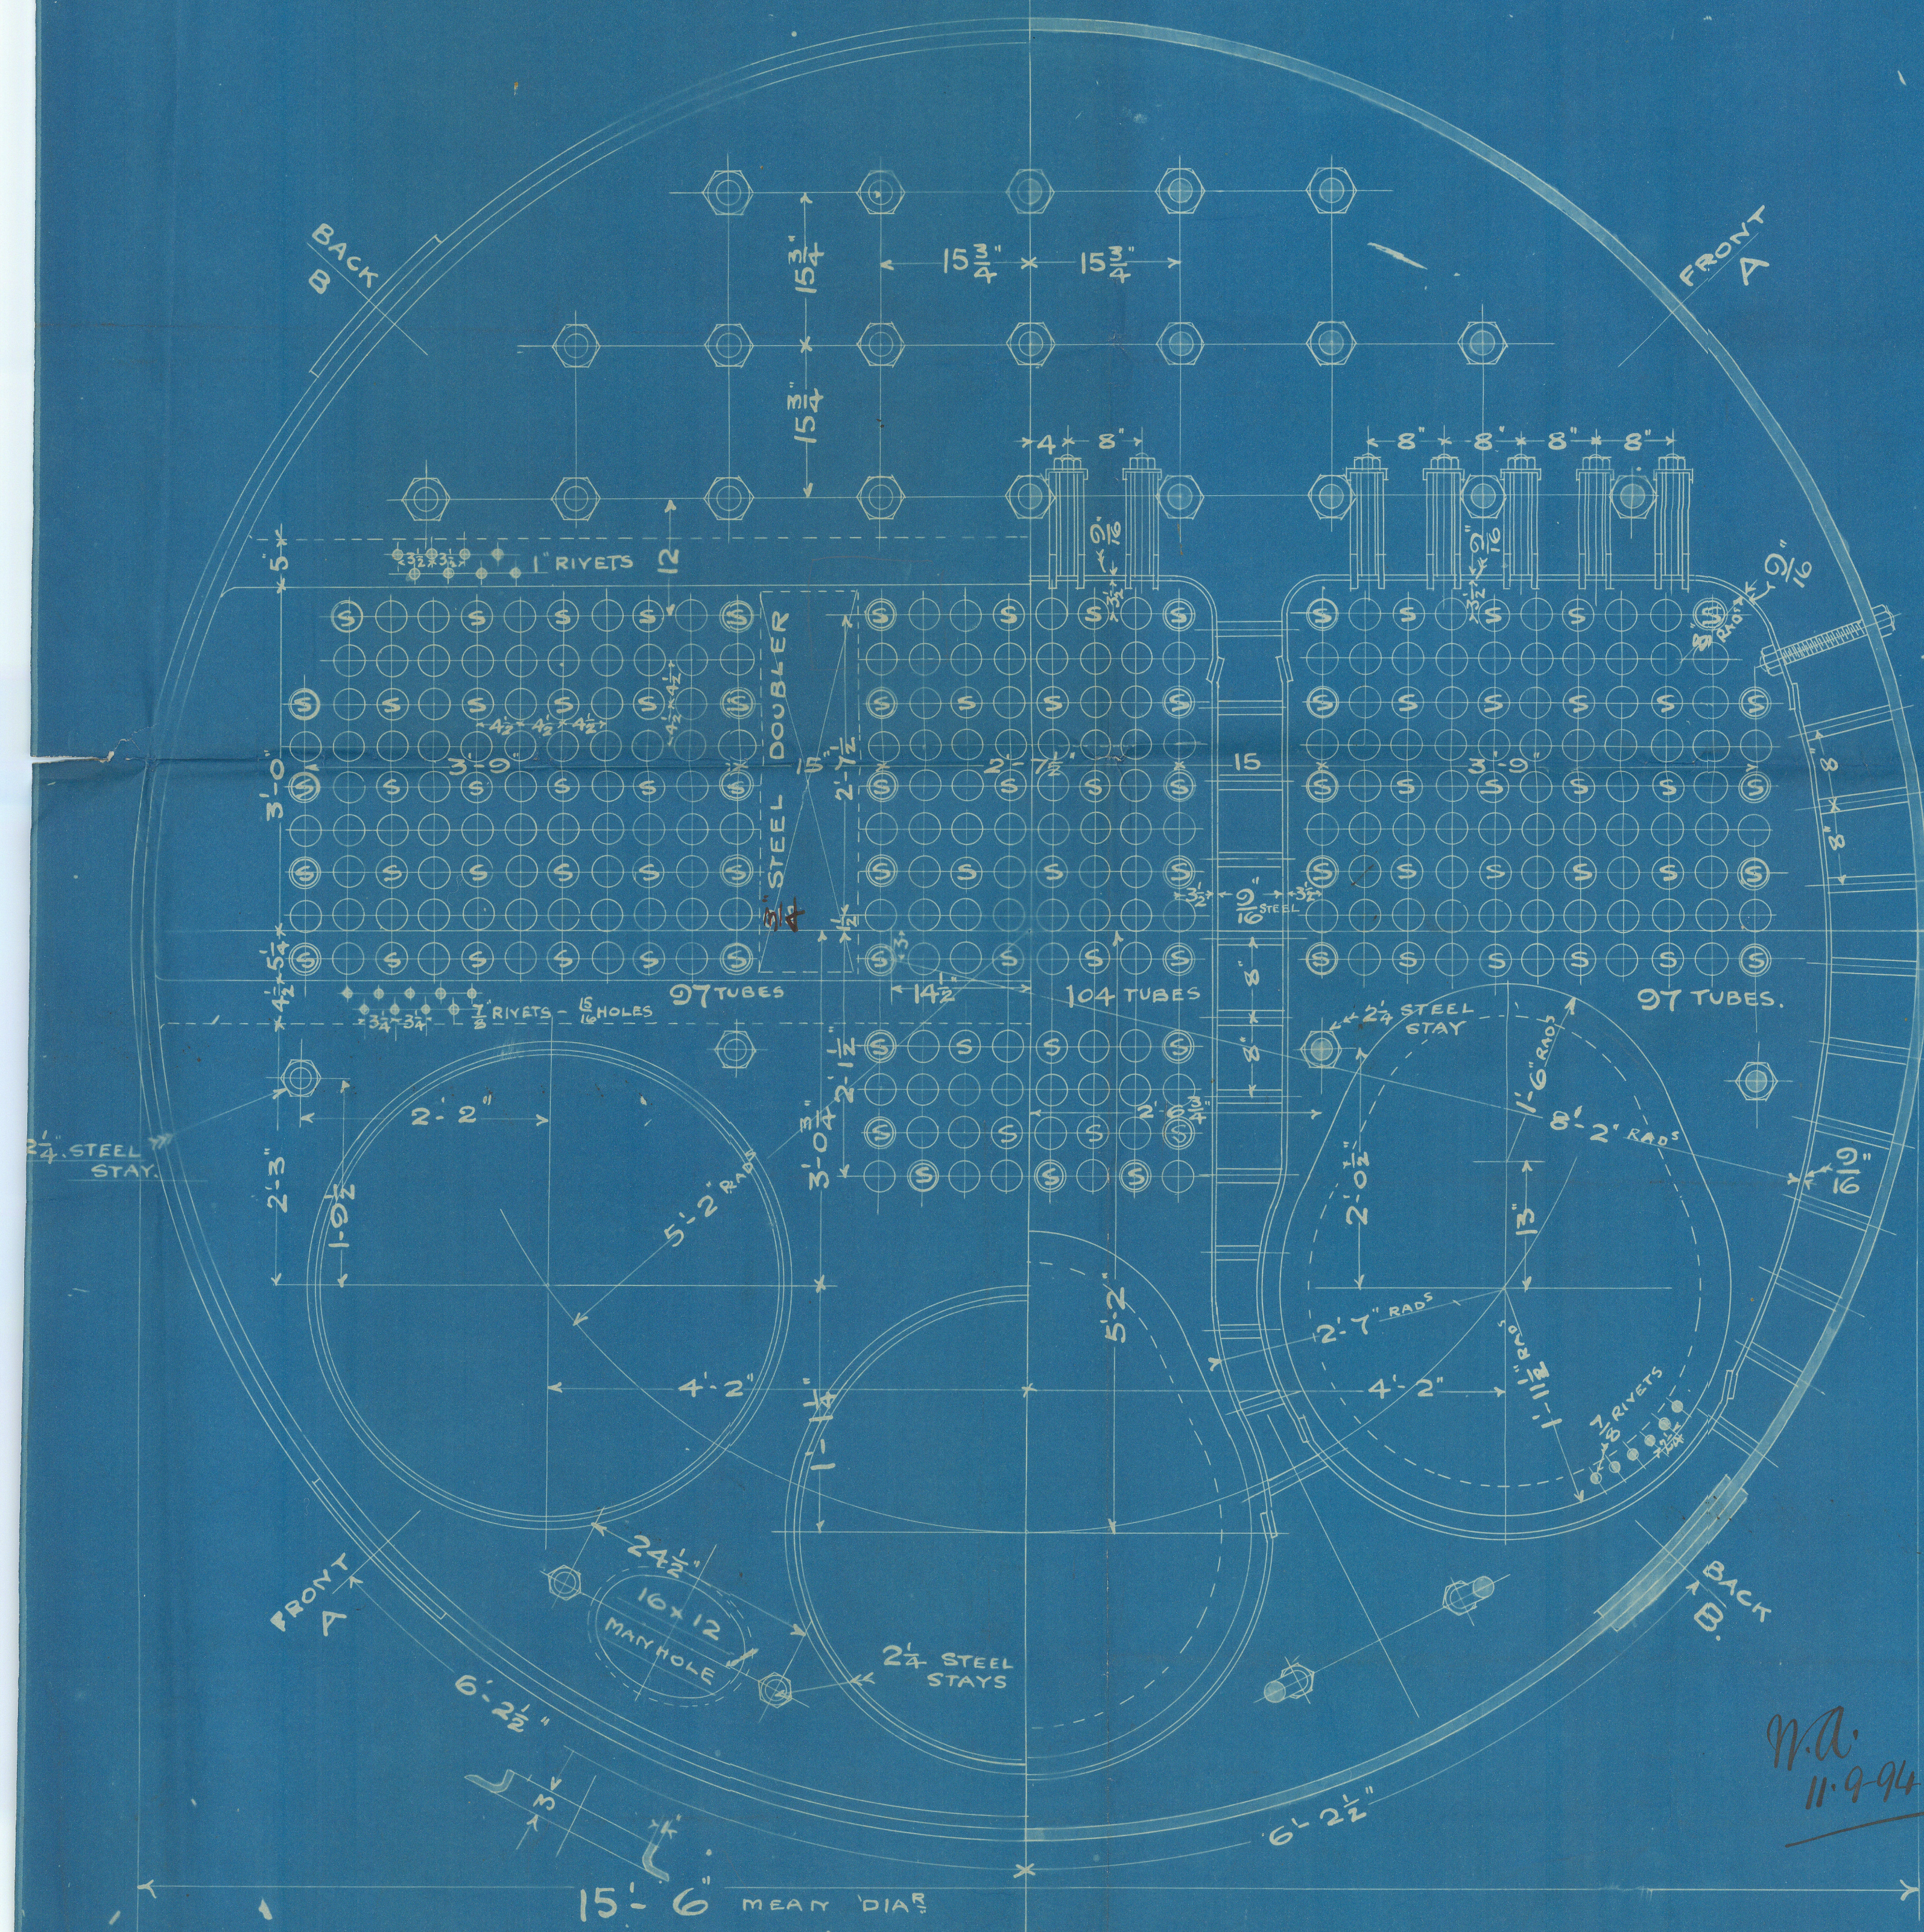


BOILERS - N^o 167.

2. OFF.
 SCALE 1" = 1 FOOT.

BARCLAY, CURLE & CO
 LIMITED
 STOBROCK ENGINE WORKS.
 GLASGOW 8. 1894

Bailers
S. S. "Bengloe" Glasgow Report No 13688.—

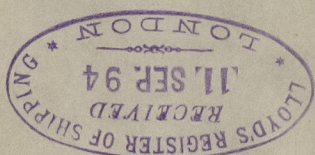

© 2021

Lloyd's Register
Foundation

615247-0174