


Plan 4: 12.94
 12.94

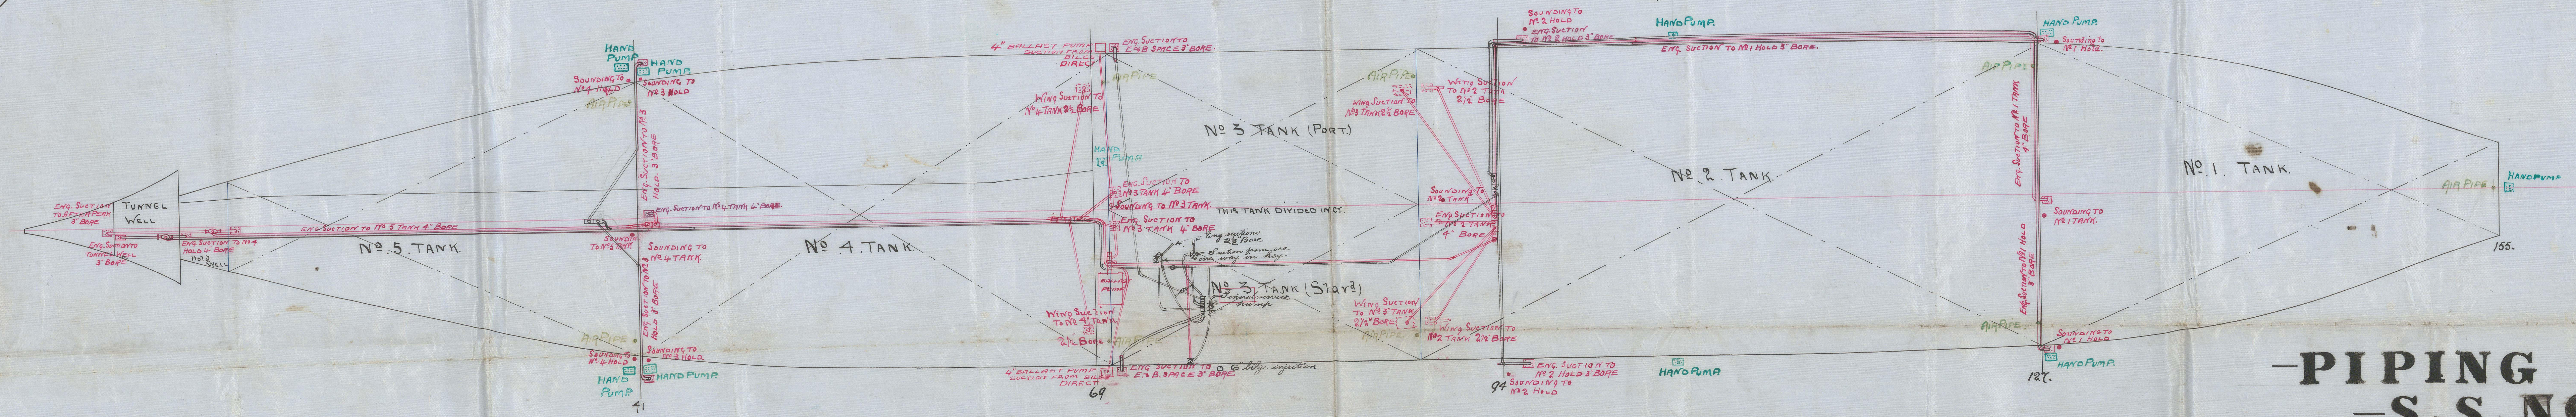


ELEVATION.

-PIPING PLAN- -S.S. NO 395-

Approx. Gross Tonnage 3060 Tons
 Approx. Under Deck Tonnage 2827 Tons


Scale 1/8" = 1 Foot

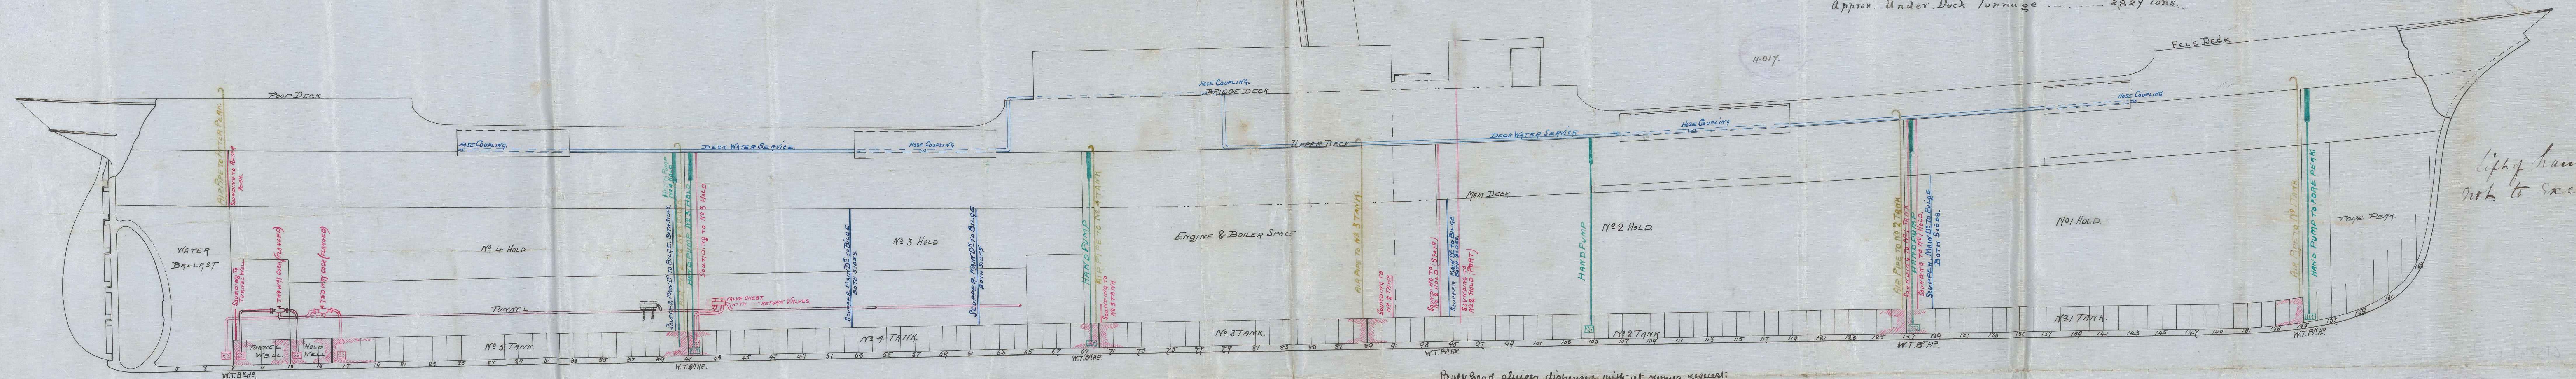

UPPER DECK.

Lift of hand pumps
 not to exceed 25 ft

J. L. M.
 3/12/44

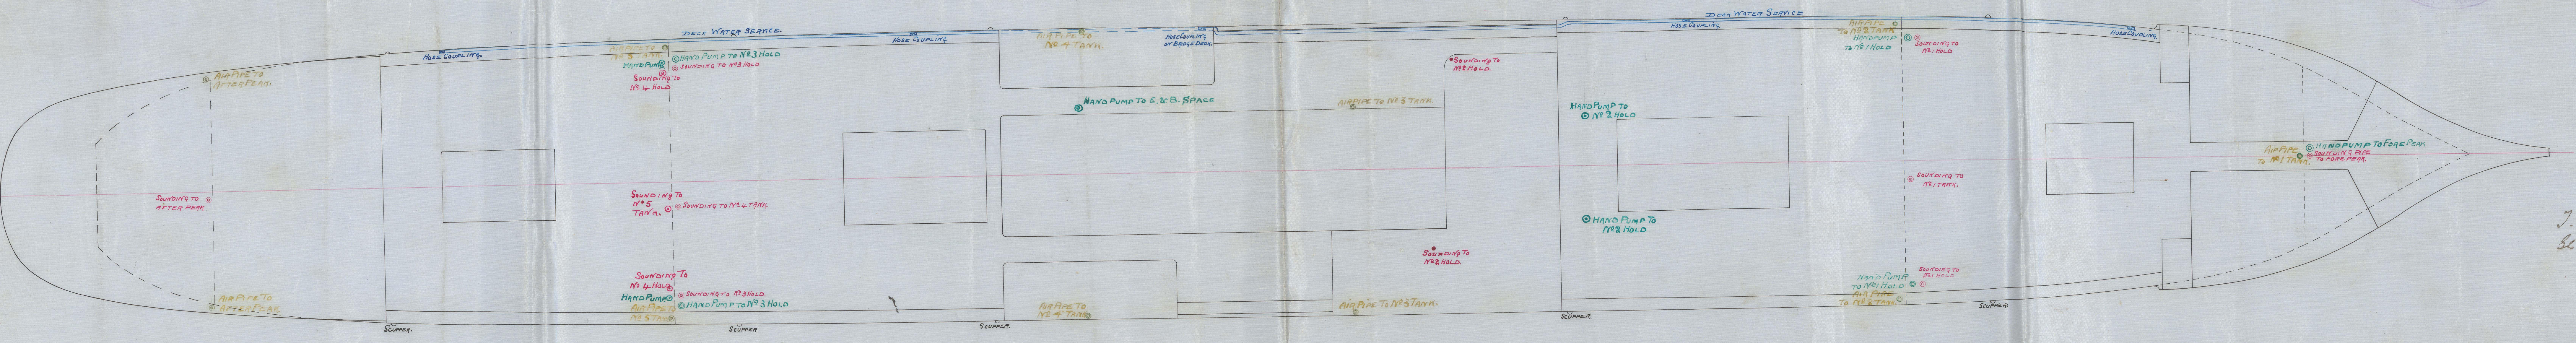

J. L.
 3/12/44

15241-0181

