

## Lloyd's Register of British and Foreign Shipping.

(Report on Vessel No. 13434 Port Glasgow)No. 4763 SHIP FORGINGS ~~OR CASTINGS~~.

I have to report that the undermentioned Iron ~~or Steel~~ Forgings ~~or Castings~~,  
 manufactured by The Portland Forge Coy  
 of Kilmarnock for the Vessel No. 219, being built  
 by Messrs Wm Connell & Coy of Glasgow  
 have been inspected by me as set forth below, and found to be, so far as can be seen,  
Sound & efficient

Mark on Forgings.

Lloyd's

No. 4763

W.H.


William Hamilton

Glasgow

15/2/95-  
STEM.

	STERN FRAME.	RUDDER FRAME.	STEM.
Material* ...	Scrap iron		
How made ...	Forged		
Dimensions ...	111 x 4		
Progress on Inspection	Forging & smithing		
Date when Inspected	24.12/12/95. 7.9.112 18.21. 125/1/95. 1.4 7/2/95		

SKETCHES OF FRAMES SHOWING POSITION AND DESCRIPTION OF WELDS OF FORGINGS, OR PARTICULARS OF  
 TESTS APPLIED TO CASTINGS.

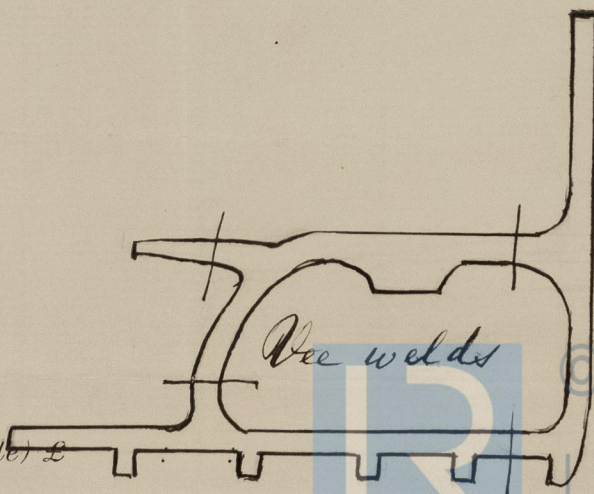

Fee (if any chargeable) £

To be paid at

\* If of Iron, state whether scrap or puddled Iron.