

Lloyd's Register of British and Foreign Shipping.

(Report on Vessel No. 13434 Port Glasgow
"Barcelona,")No. 4763

SHIP FORGINGS OR CASTINGS.

I have to report that the undermentioned Iron or Steel Forgings or Castings,
manufactured by Messrs. Charles Connell & Co.of Glasgow. for the Vessel No. 219, being builtby Messrs. Charles Connell & Co. of Glasgow.

have been inspected by me as set forth below, and found to be, so far as can be seen,

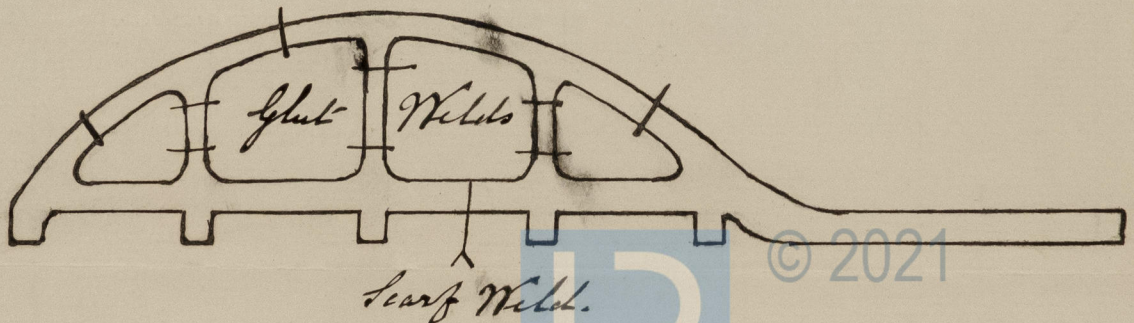
Sound.

Mark on Forgings.

Lloyd's

No. 4763ECFrank CookGlasgow. 3/4/95

	STERN FRAME.	RUDDER FRAME.	STEM.
Material*		<u>Scrap Iron</u>	<u>Scrap Iron</u>
How made		<u>Forged.</u>	<u>Forged</u>
Dimensions		<u>9 1/2 to 14 3/4 in</u>	<u>11 x 3"</u>
Progress on Inspection		<u>Forged & smithed</u>	<u>Forged & smithed</u>
Date when Inspected		<u>5.14.24/12/94. 9.14.24.24. 11.18.24/12/94. 28/1/95. 1</u> <u>29/1/95. 1.20/2/95. 1.8.13/3/95. 4/3/95</u>	

SKETCHES OF FRAMES SHOWING POSITION AND DESCRIPTION OF WELDS OF FORGINGS, OR PARTICULARS OF
TESTS APPLIED TO CASTINGS.3/4/95

Fee (if any chargeable) £

To be paid at

* If of Iron, state whether scrap or puddled Iron.