


**"SS. GLENAVON"**  
No 217  
SCALE 1/2 INCH TO THE FOOT  
*Glenavon altered to W.S. & Co. Ltd. 1884  
as shown in Red*




APR 15 1884

 

Glenarvon

Deck & Elevation Plan

GLS248-0090

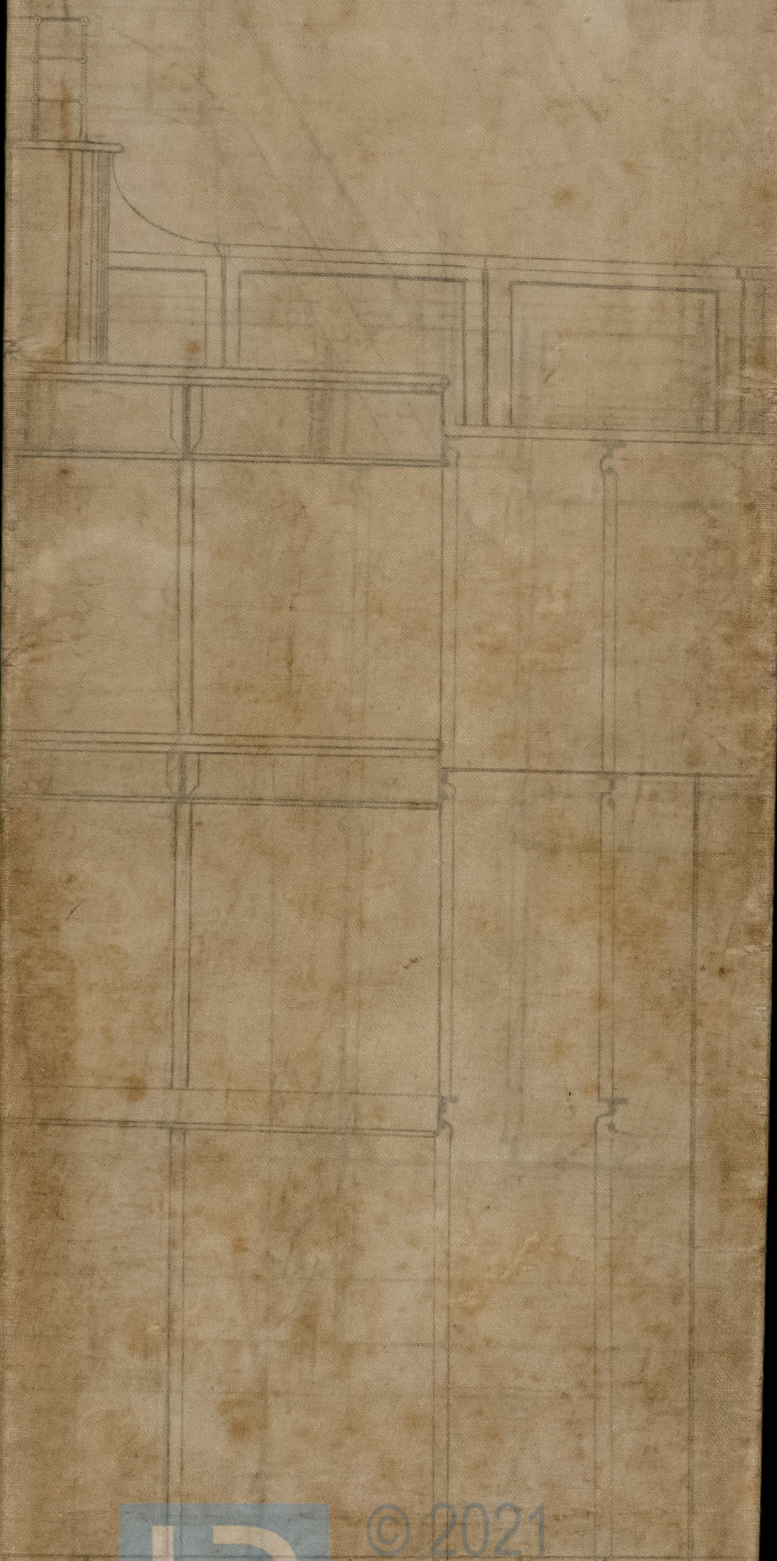

© 2021

Lloyd's Register  
Foundation