

# Equipment

1 Power 4 1/2 Hwt ex Stock	159 3/4 Hwt Coll Hwt ex Stock
1 " 4 1/2 " " "	
1 " 40 " " "	
1 " 36 3/4 " " "	
1 Stream 12 3/4 " " "	
1 Kedge 6 1/2 " " "	
135 Pths 2 7/8 Stud Chain cable	
90 " 1 3/16 Stream	
120 " 1 1/8 Towline or 1 1/2 Wire	
90 " N Hawser 3/4 in	
90 " X Warp 3	

# Midship Section Steel Screw Steamers Nos 219+220+ 222

To Class 100A. at Lloyds Spar Deck

Scale 1/2" - One Foot.

## Numeral

1/2 Girth	42.3
1/2 Breadth	22.89
Depth	24.45
	89.64 P.N.
	387.7
	34753.42 P.N.

## Proportions

Depths to Spar Deck	11.95
Main	15.85
Breadths	8.46

## Numeral for Rudder

105.6
98.6
387.7
387.7


## Equipment Numeral

1/2 Girth	50.3
1/2 Breadth	22.89
Depth	32.41
	105.60
	387.7

6" Line of Boats  
Davit = 1188 + 40941.12  
1188  
42129.12 E.N.

## Directions




Loop + File about 90 Feet.

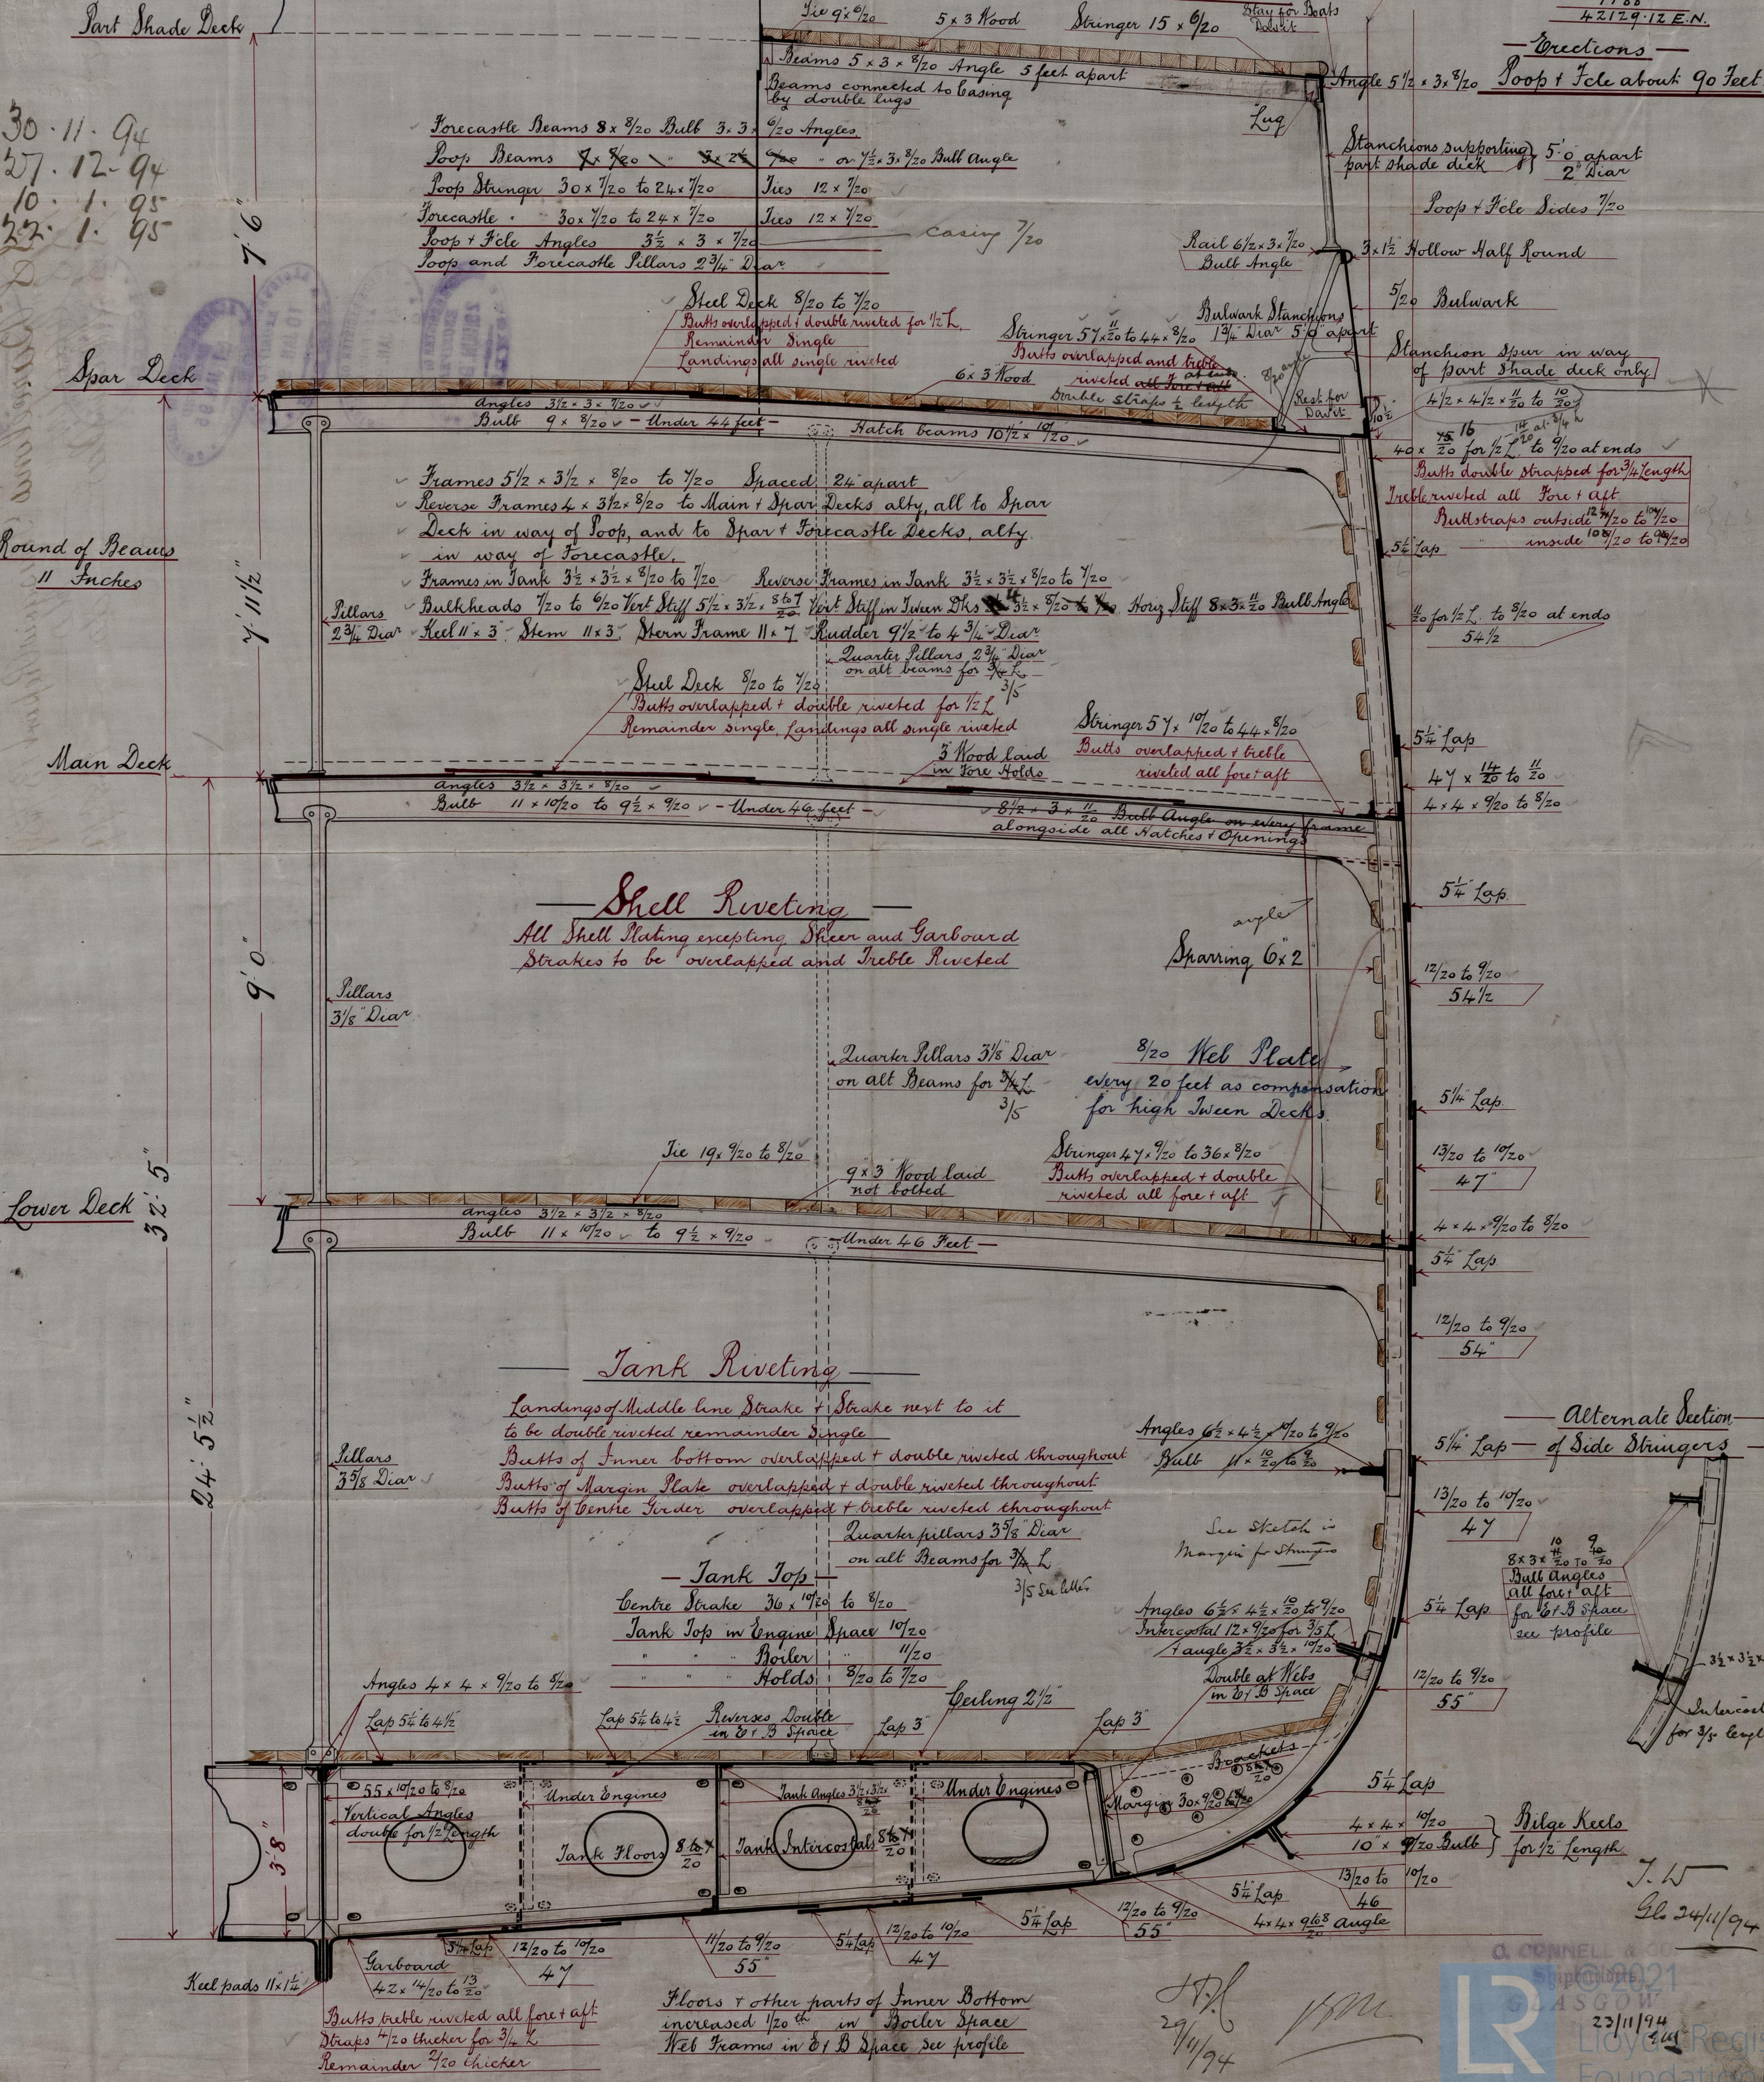



GLS248-0098

S.S. "Barcelona" Glasgow Report 13434  
S.S. "Ladino" do 13800  
S.S. "Manilla" do 13849

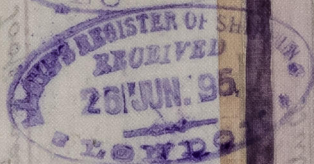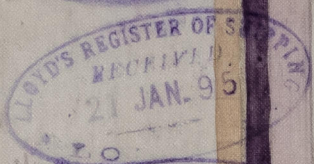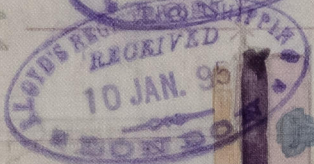

© 2021

Lloyd's Register Foundation