



2.7.94

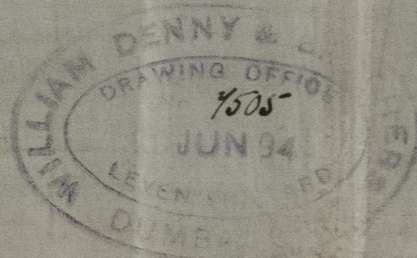

SKETCH OF FLOORS
IN
INNER BOTTOM
S. S. N^o 504

SCALE $\frac{1}{2}$ INCH = 1 FOOT.

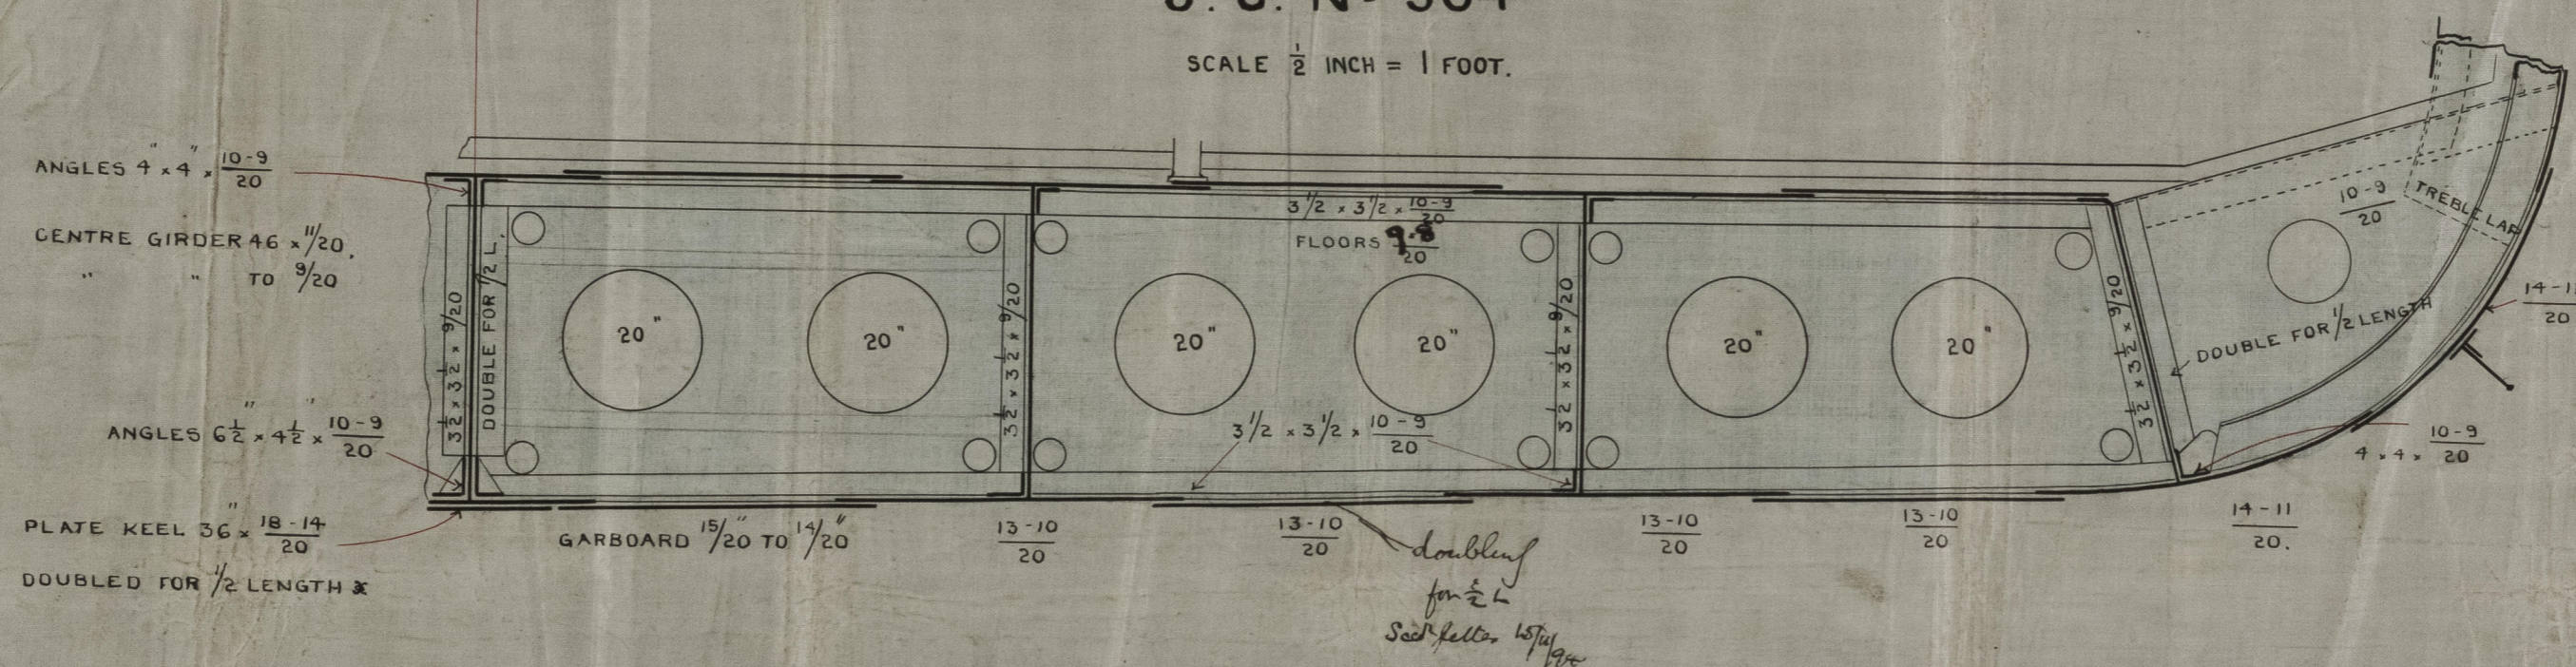


doubling
for $\frac{1}{2}$ L
See letter 10/14/94


24/9/4.

GLS249-000L

GLS249-0004

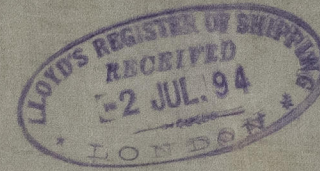

Handwritten notes:
27.10.94
for 5
J. B. B.

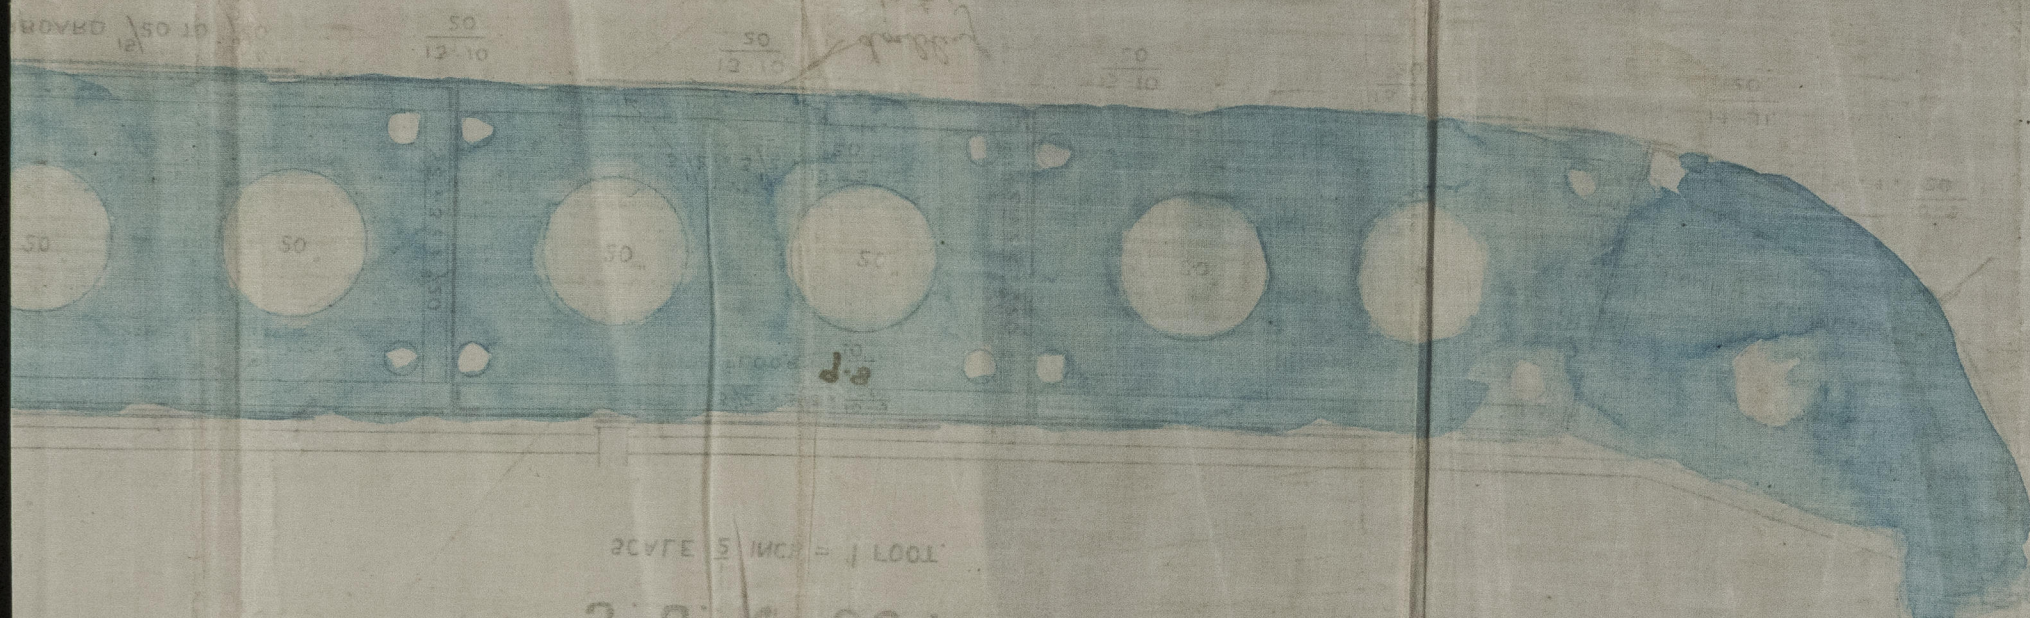


2 2 1/2 20+

INNER BOTTOM

SKETCH OF FLOORS



© 2021

Lloyd's Register
Foundation