




Boilers No. 336 & 7.
 Pressure 90 lbs. p. s.
 To pass "Lloyd's"
 Scale 1" = 1 Foot.

S. S. Saint Vagans.

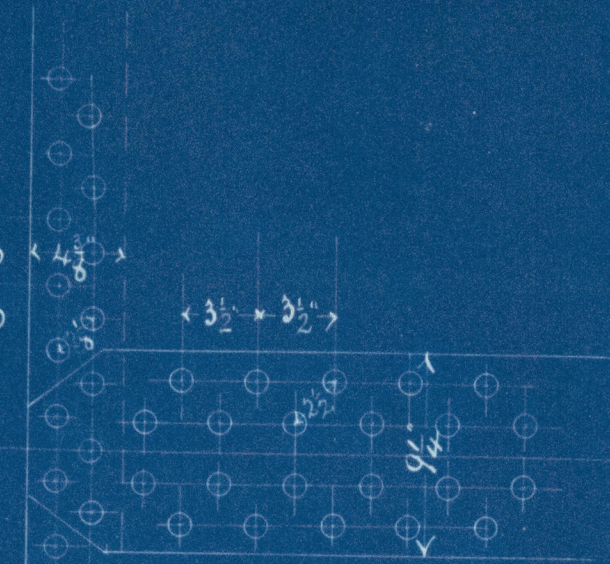

L Seams double, Butt Stays 1/2" thick
 All plates & rivets steel
 All holes drilled in place 7/8" dia.

Grate Surface, 5' 6" bars	34.8 sq. ft.
Heating surface in tubes	905.2 sq. ft.
" " Fire boxes	114.6 "
" " Furnaces	75.9 "
" " One Boiler	1095.7 "
" " Two "	2191.4 "

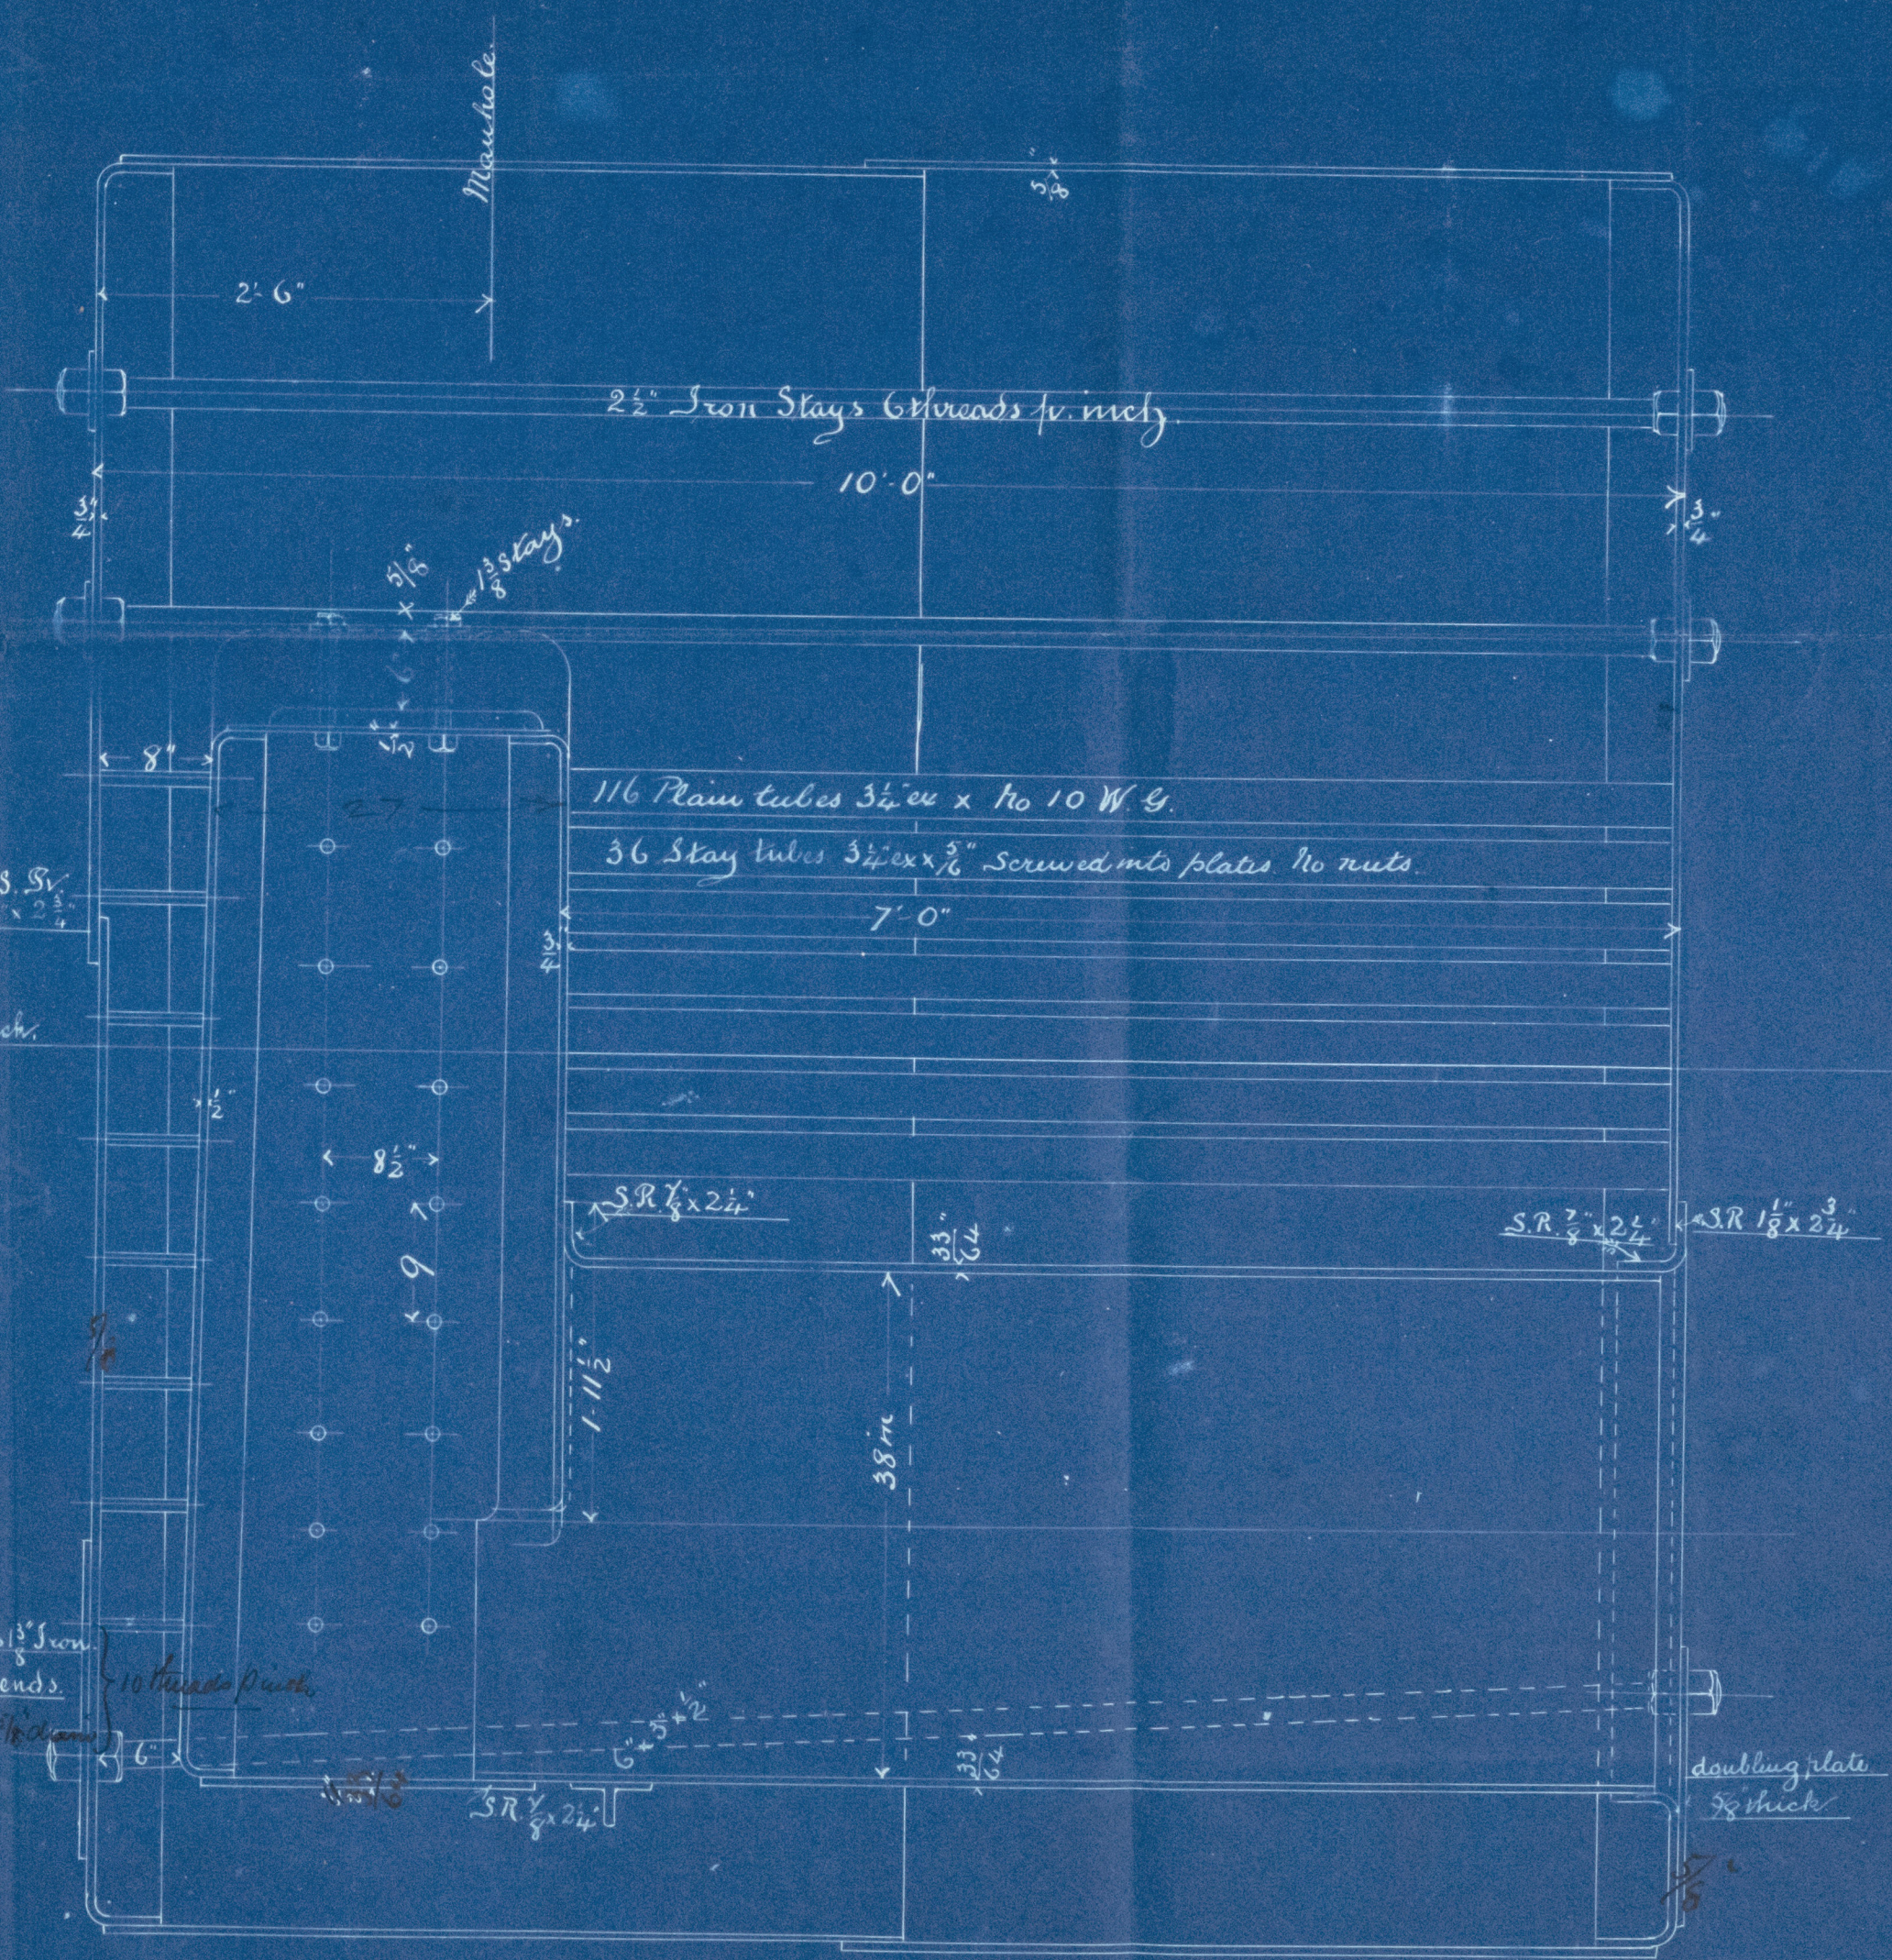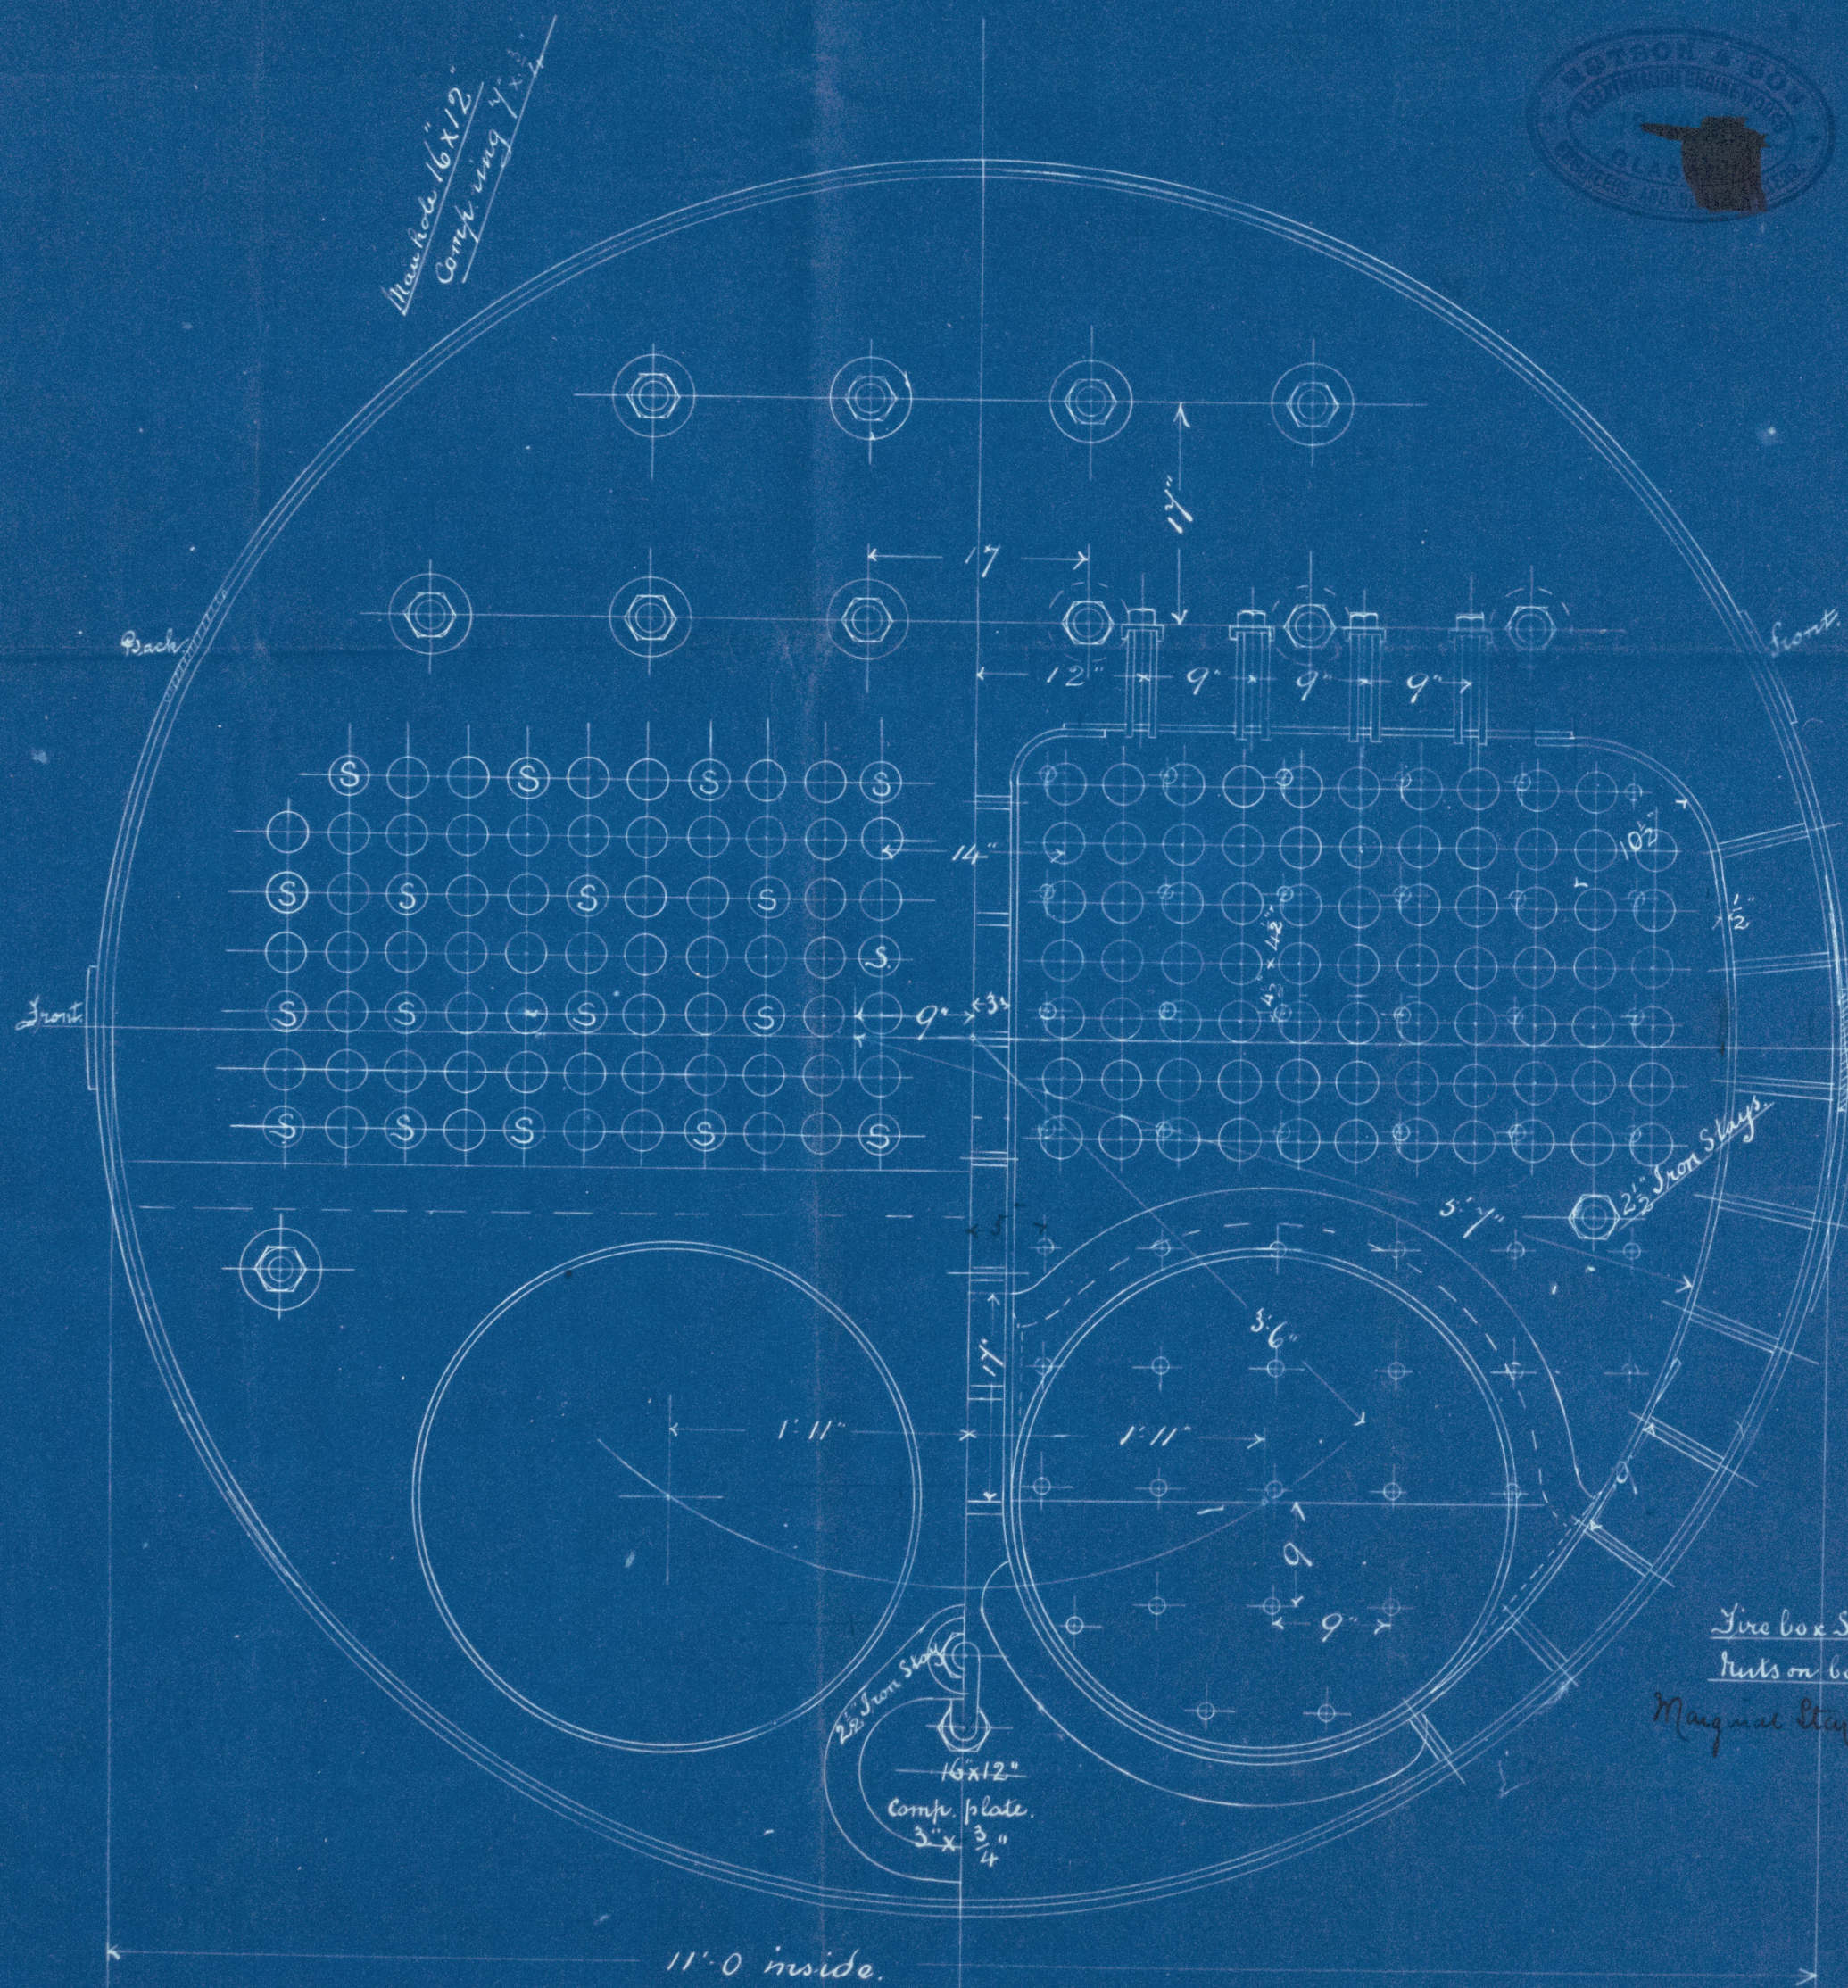

GLS249-0070

Boiler

S.S. "Saint Fagans" Glasgow Report No. 13830.—



© 2021

Lloyd's Register
Foundation