


8.3.95



S.S. Nos 382-3
Scale $\frac{1}{2}$ " = 1 Foot

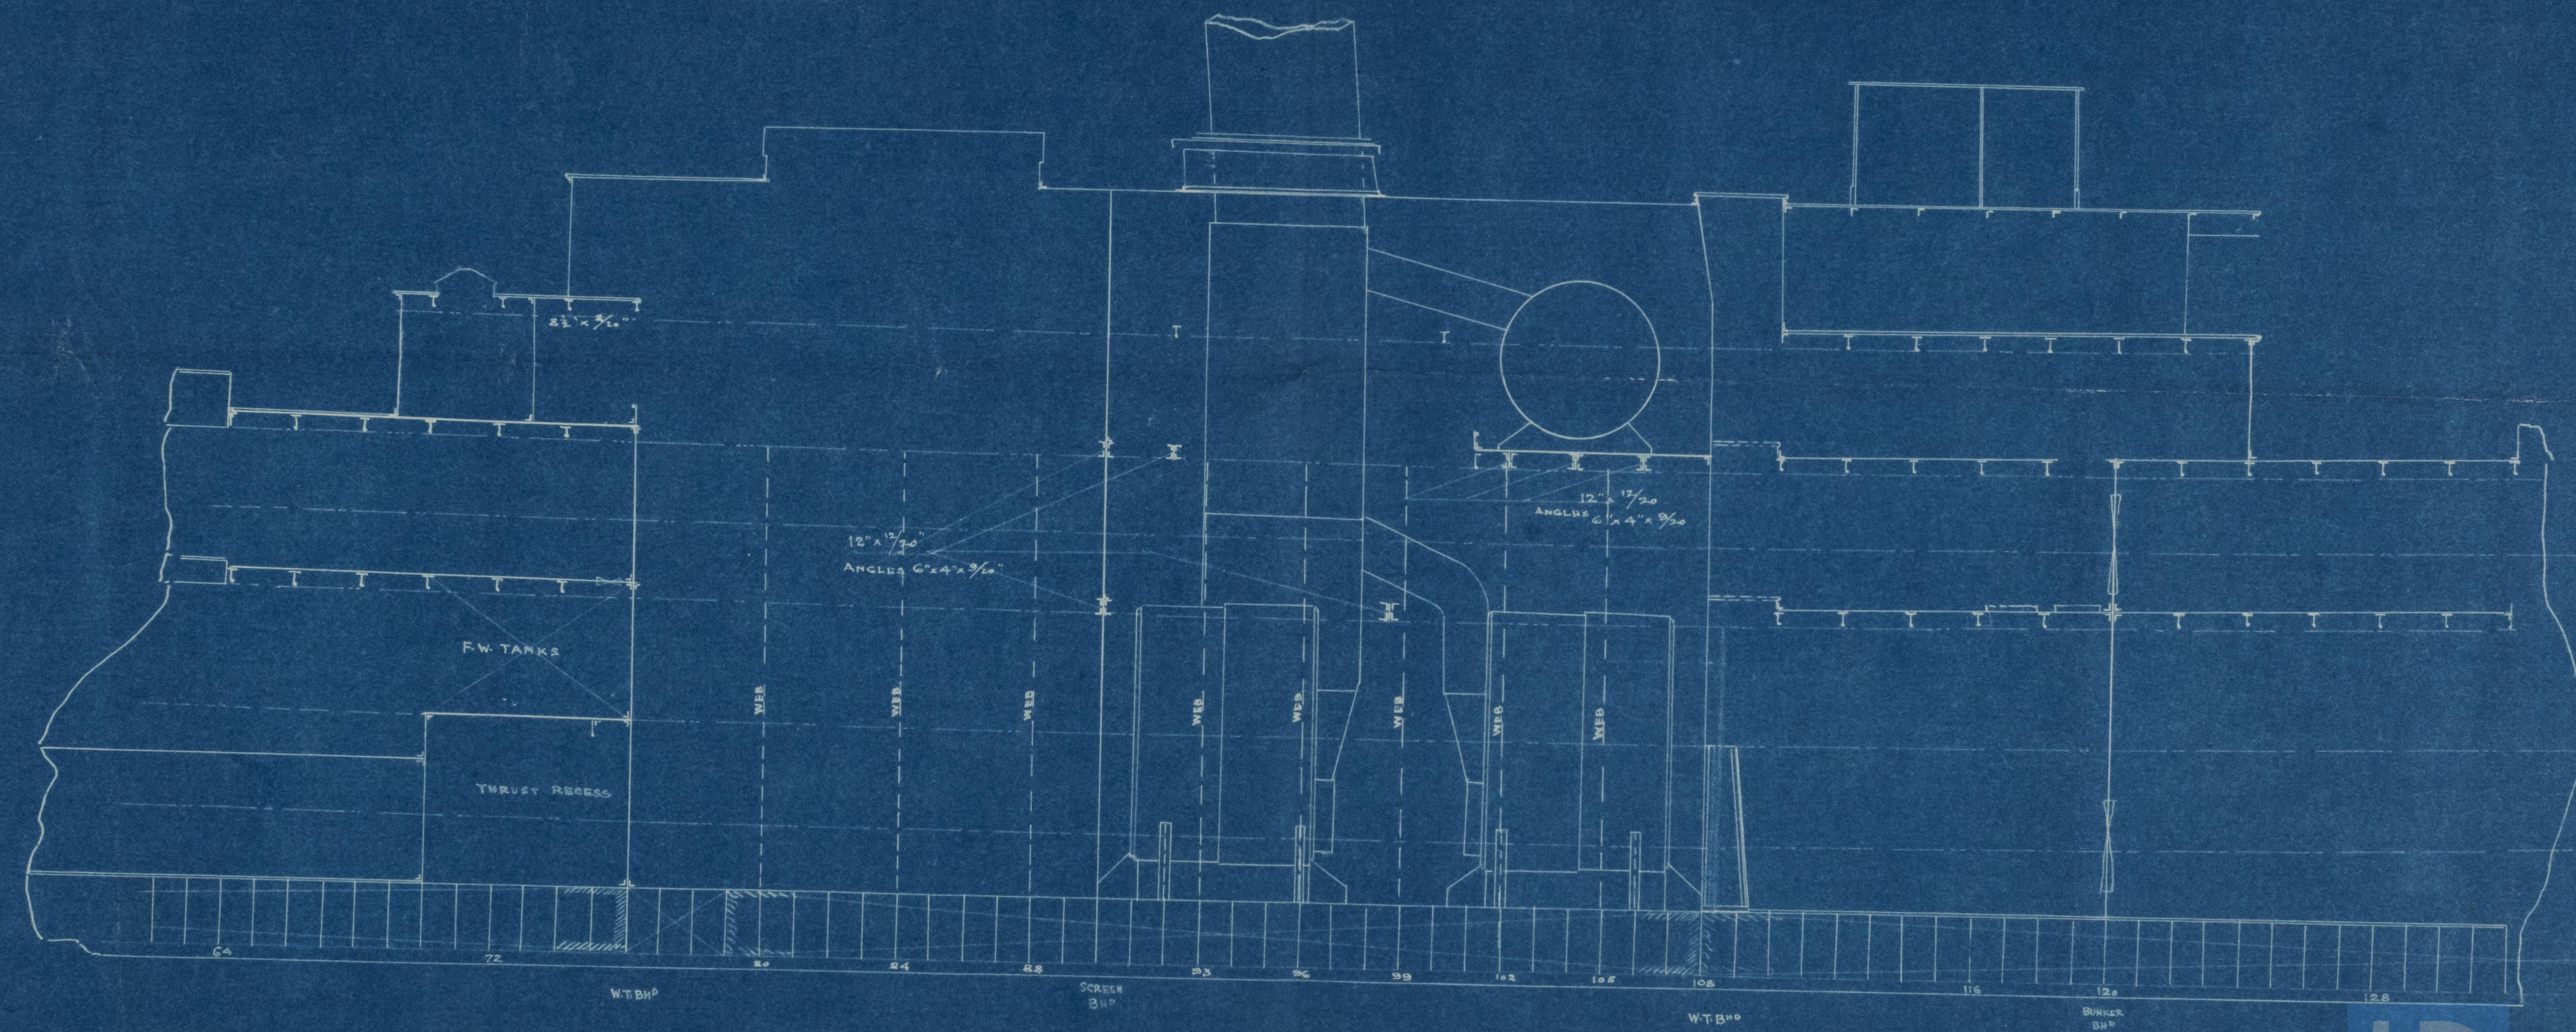

H.H.
8/3/95

S. S. "Moyune" Glasgow Report 13845.
S. S. "Teenkai" do — 14001.-
elevation in way of Bulers.
(appd)



© 2021

Lloyd's Register
Foundation

GLS249-0105