
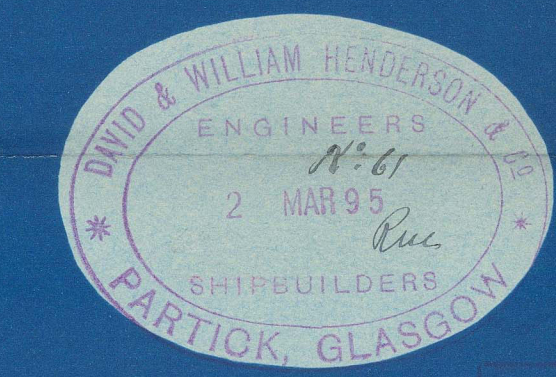


sb/ls
76P

— UPPER DECK —

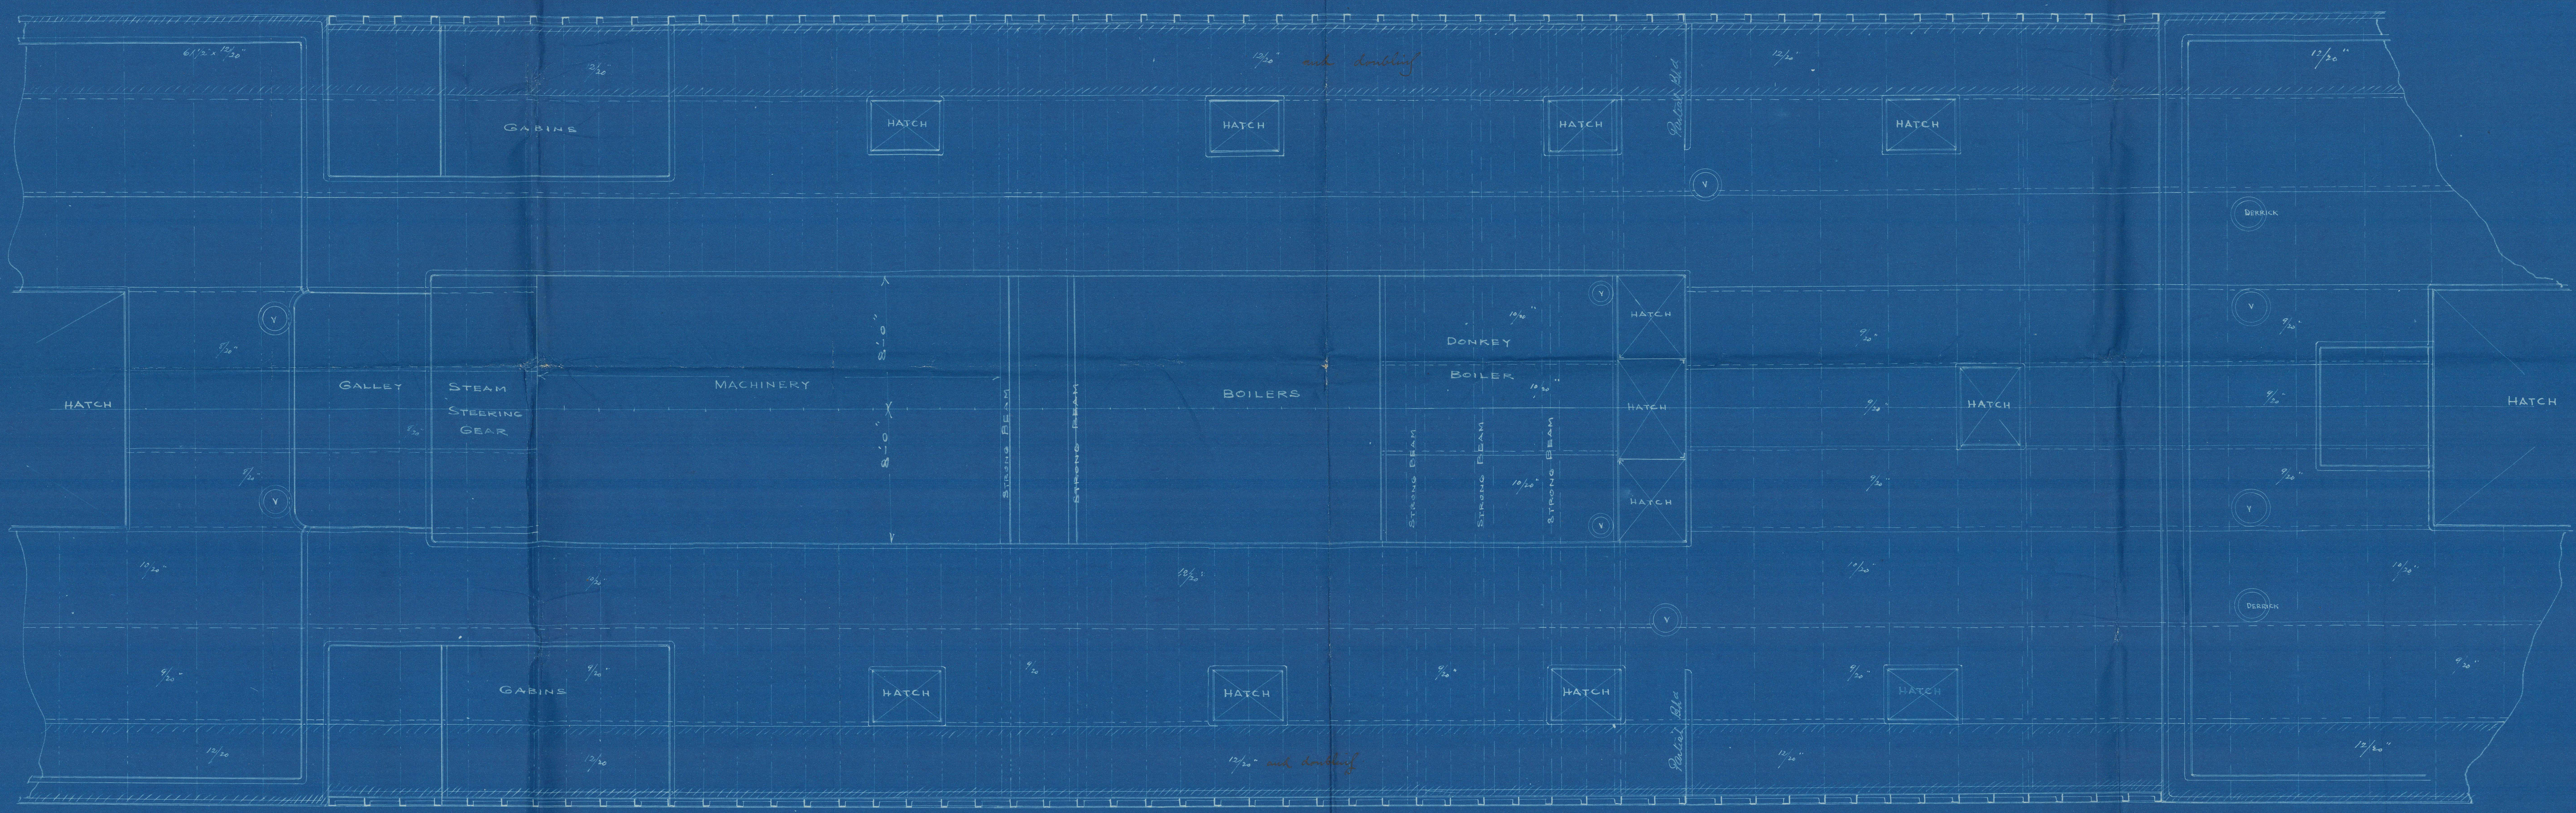


PLAN SHEWING ENGINE & BOILER OPENINGS


S.S. NOS 382-3

Scale 1/4" = 1'-0"

— MAIN DECK —

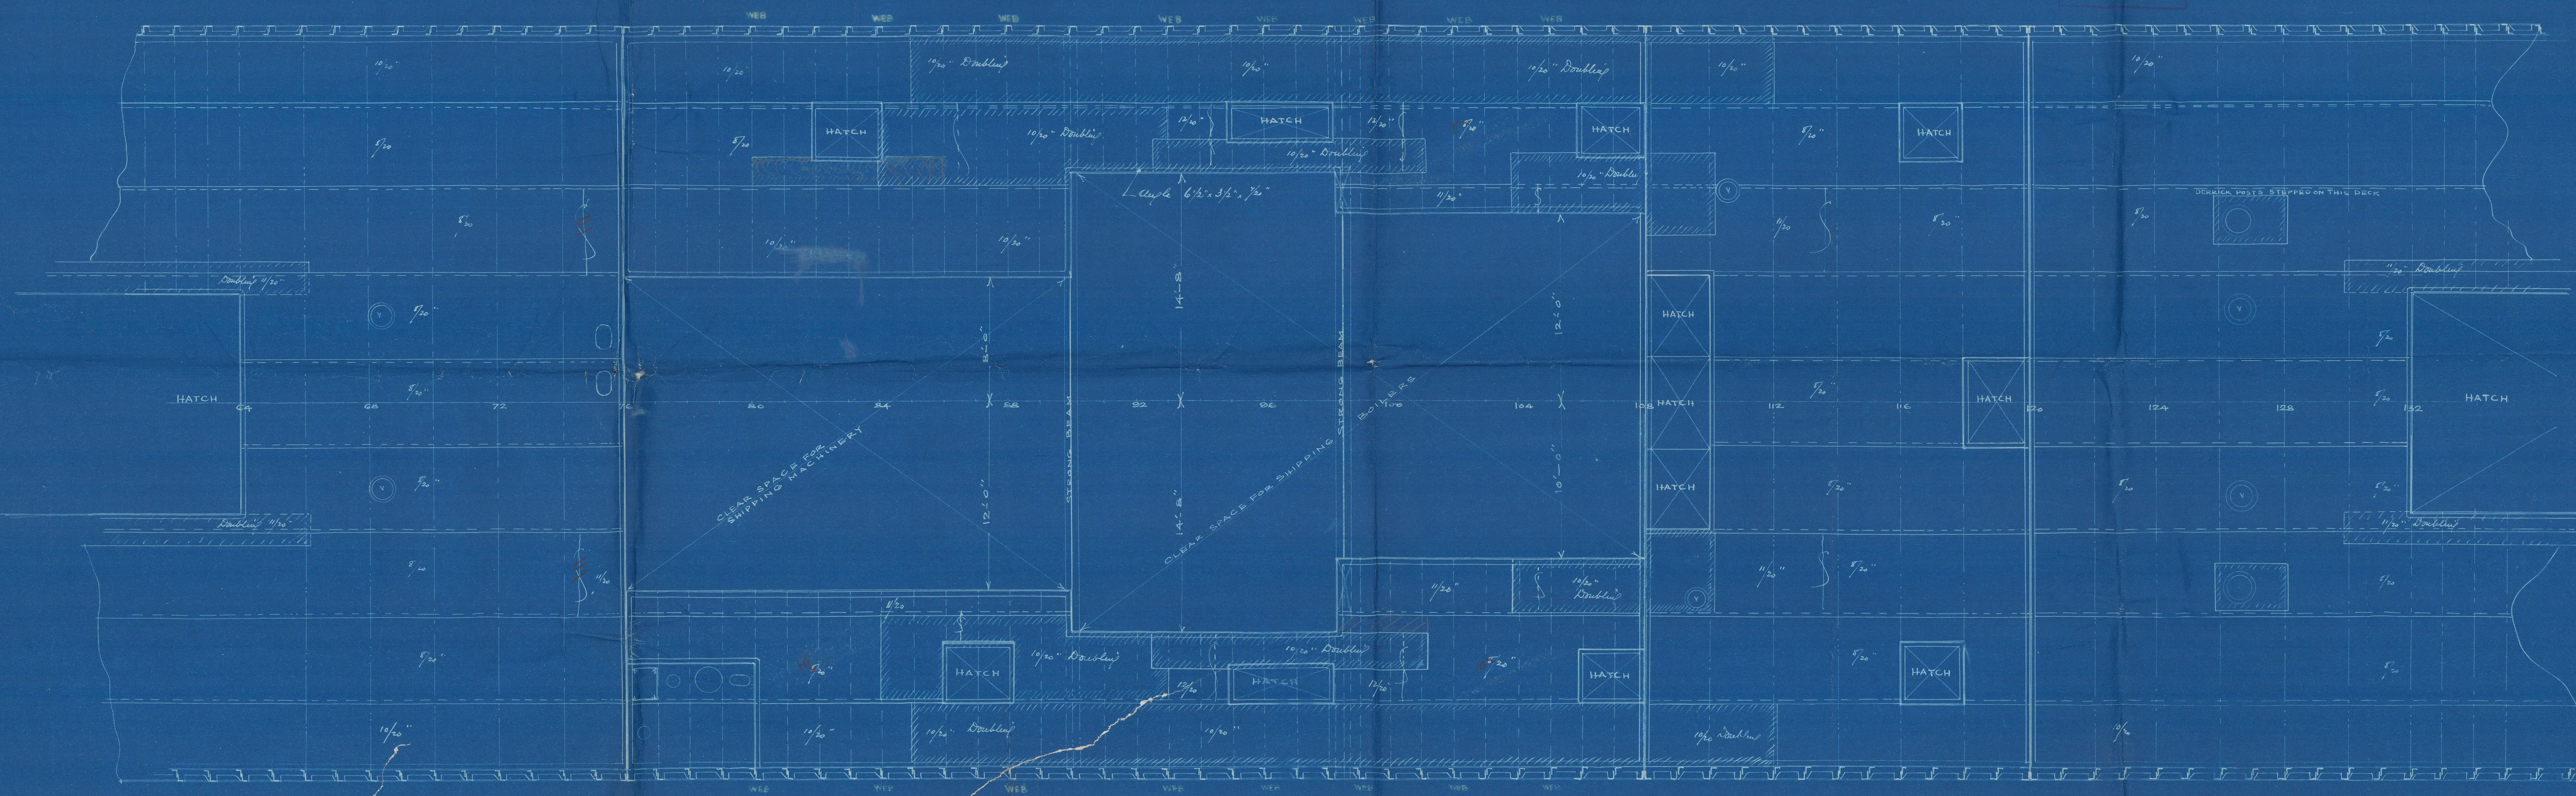


sb-8-8

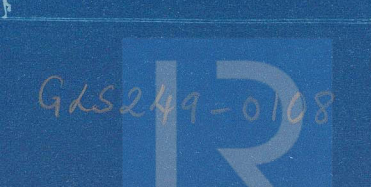

S. S. "Moryune" Glasgow Report No. 13845. —
S. S. "Teenkai" — do — " 14001. —
Deck plans (appd)

GLS249-0108

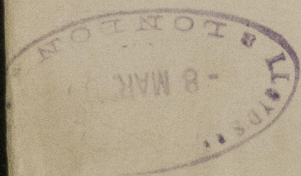

© 2021

Lloyd's Register
Foundation



8108



© 2021

Lloyd's Register
Foundation