

Scale $\frac{1}{2}'' = 1 \text{ Foot}$.

TO CLASS 100-A-1 AT LLOYDS.

$$\begin{array}{r} 100.88 \\ 7.00 \\ \hline 96.86 \\ 408 \\ \hline 39518.88 \end{array}$$

1st number
 2^d "





$$\begin{array}{r} 103.86 \\ 408 \\ \hline 42374.88 \end{array}$$

$$2601.66 = \text{Directions } 182^\circ \text{ gk}$$

$$44976.54 \text{ Output N:}$$

A diagram of a stepped profile with the following dimensions: a top horizontal segment of $8\frac{1}{2}$, a vertical segment of $3\frac{1}{2}$, a horizontal segment of $5\frac{1}{2}$, a vertical segment of 3 , and a bottom horizontal segment of 6 . The profile is shown in a perspective view.

S.S. "Panama" Glasgow Report No.
S.S. "Myrene" Glasgow Report No. 13845.
S.S. "Teekhai" — do — No. 14001.
Indship Sec (appn)

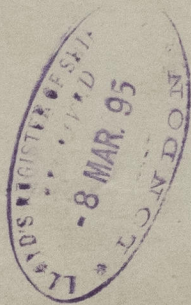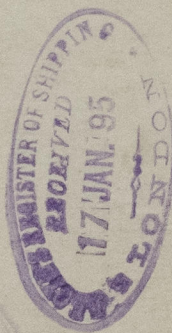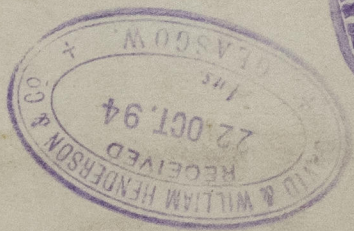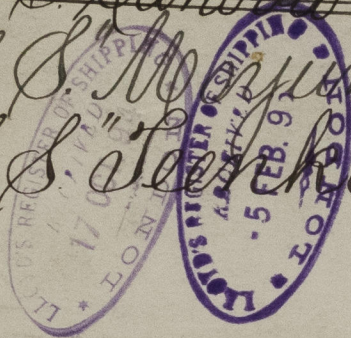

© 2021

Lloyd's Register
Foundation

GLS249-0113