

Lloyd's Register of British and Foreign Shipping.

(Report on Vessel No. 114035 Port Glasgow)Emperor Nicolas IINo. 4727

SHIP FORGINGS OR CASTINGS.

I have to report that the undermentioned ~~Iron or Steel Forgings or Castings~~,
 manufactured by The Kilmystown Forge Co.
 of Kilmystown for the Vessel No. 510, being built
 by Messrs. Wm. Henry & Bros. of Kilmystown.
 have been inspected by me as set forth below, and found to be, so far as can be seen,
Sound.

Mark on Forgings.

Lloyd's

No. 4727
F.C.


Frank Cook.

Glasgow.

27/6/95.

| | STERN FRAME. | RUDDER FRAME. | STEM. |
|------------------------|--------------|-----------------------------|-------|
| Material* | | <u>Scrap Steel.</u> | |
| How made | | <u>Forged</u> | |
| Dimensions | | <u>9" to 4 1/2" in</u> | |
| Progress on Inspection | | <u>Forged & omitted</u> | |
| Date when Inspected | | <u>22/3/95. to 26/6/95.</u> | |

SKETCHES OF FRAMES SHOWING POSITION AND DESCRIPTION OF WELDS OF FORGINGS, OR PARTICULARS OF
 TESTS APPLIED TO CASTINGS.

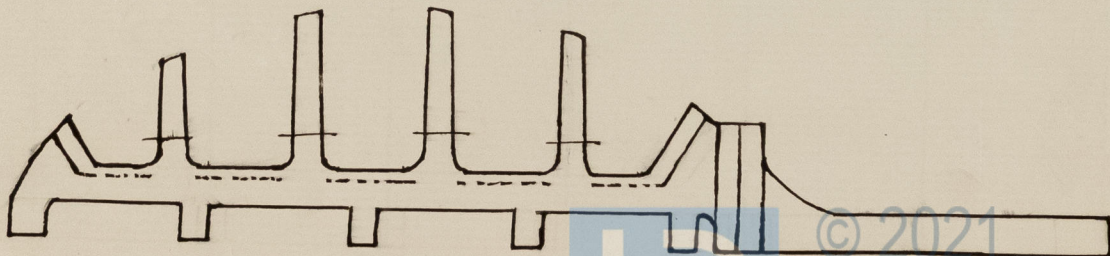

Fee (if any chargeable) £

Glut Welds.

To be paid at

Lloyd's Register
Foundation