


## A circular purple ink stamp. The outer ring contains the text "WILLIAM DENNY &amp; BROTHERS" at the top and "DUMBARTON" at the bottom. Inside the ring, the text "DRAWING OFFICE" is at the top, "NO. 2929" is in the center, "15 COLLYER" is below the center, and "LEVEN" is at the bottom. A wavy line is drawn across the center of the stamp, passing through the number "2929" and the text "15 COLLYER".

TO CLASS 100 A1 AT LLOYDS 3 DECK RULE  
SCALE  $\frac{1}{2}$  INCH - 1 FOOT.  
[BUILT OF STEEL]

as built



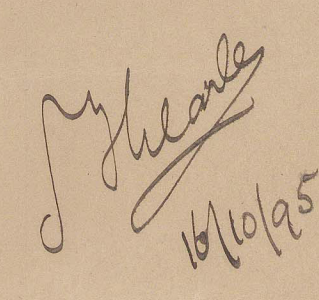


S. S. Emperor Nicolas II"  
Glasgow Report  
No

Midship Section (as built)

same as Queen Olga - 12696

and Schuchhoff - 11788

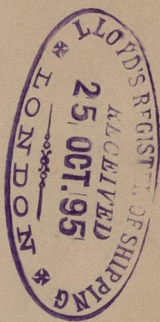

© 2021

Lloyd's Register  
Foundation

GLS251-0076