

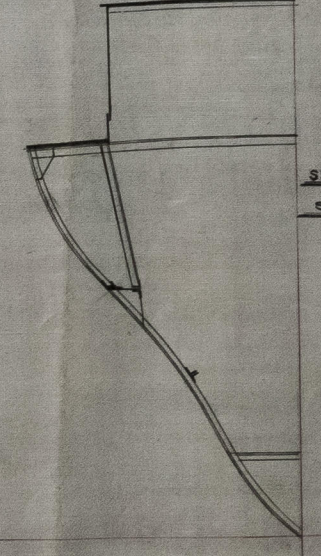
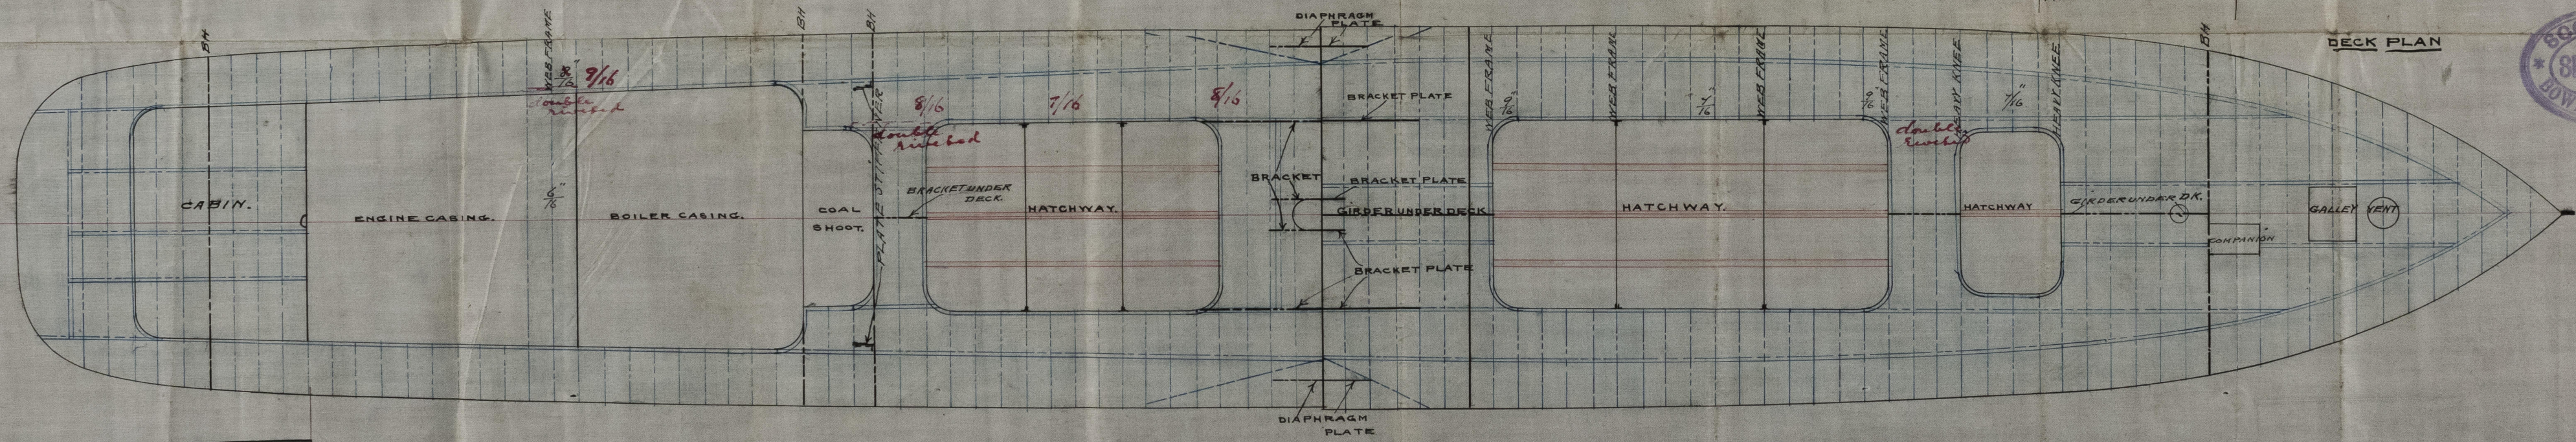


27.8.95

S. S. N<sup>o</sup> 116.  
SCALE  $\frac{1}{8}$ " = ONE FOOT.

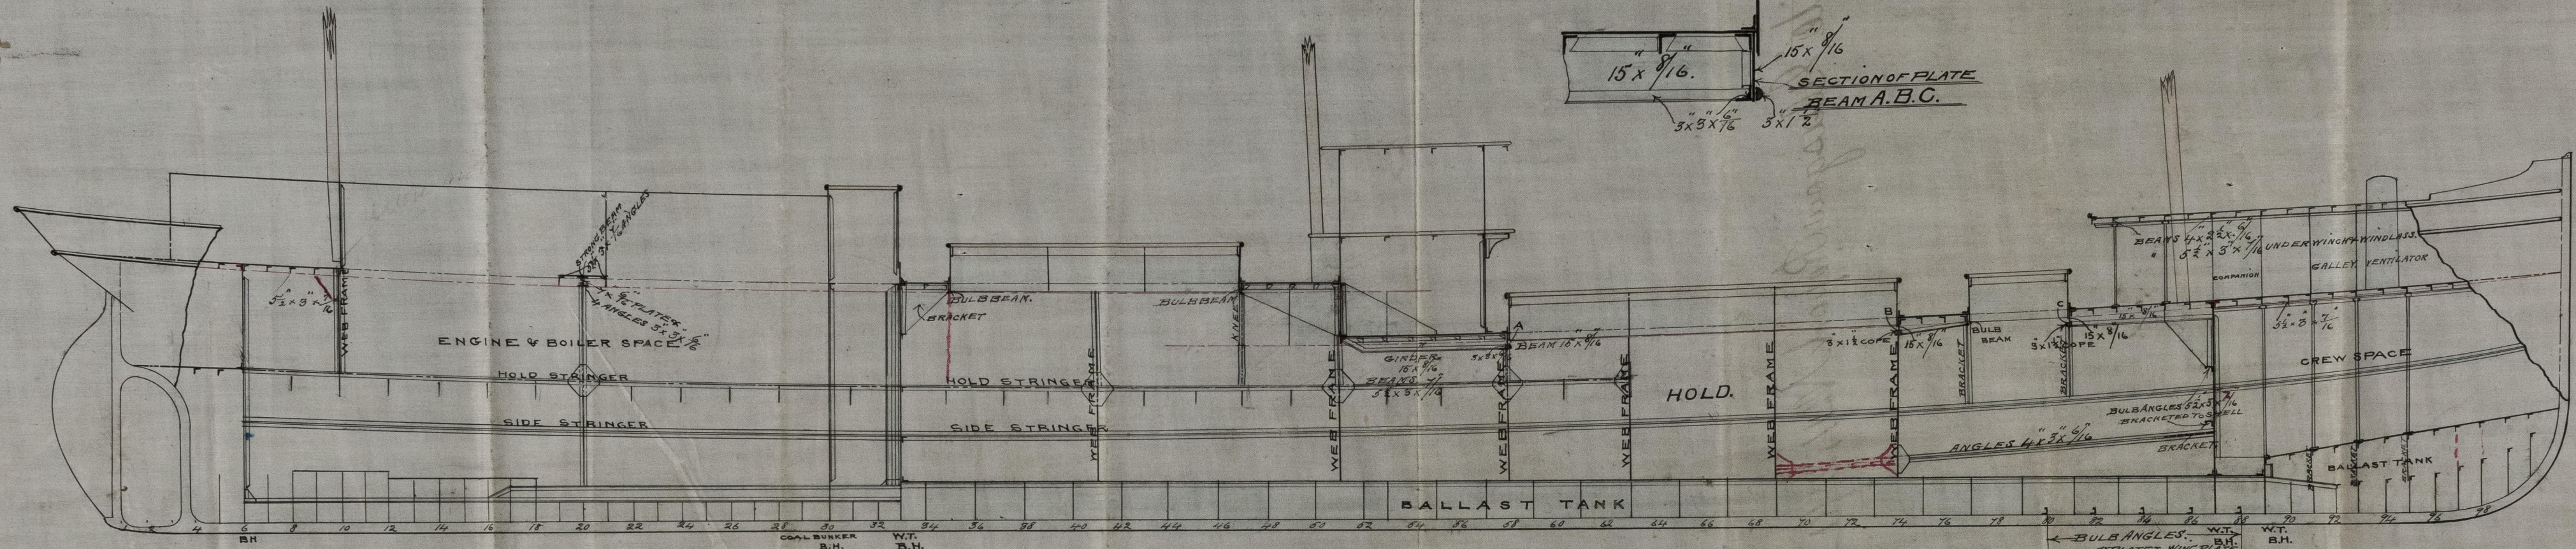

SECTION AT NO 10 FRAME  
SHOWING WEB FRAME.

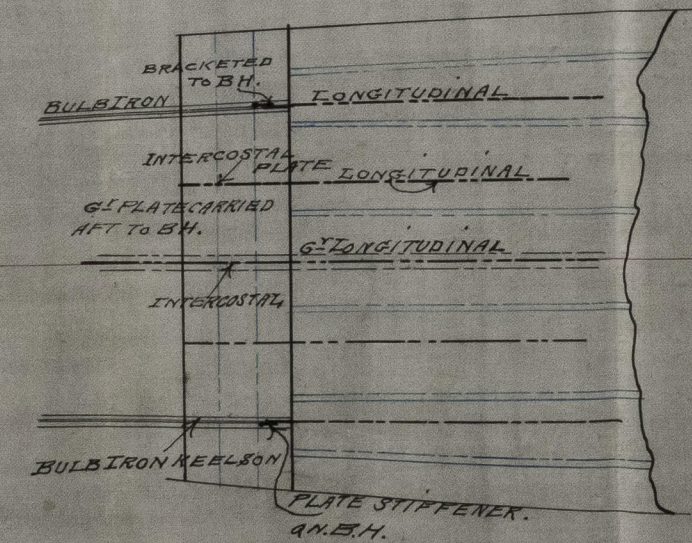

18/8  
2/8/95



© 2021  
Lloyd's Register  
Foundation

005252-0130



S.S. "Nephrite" Glasgow Report No. 14240.

THE REGISTER OF SHIPS  
REGISTERED  
22 AUG 95

THE REGISTER OF SHIPS  
REGISTERED  
24 AUG 95

THE REGISTER OF SHIPS  
REGISTERED  
13 DEC 1895

46255-0130