



NEW ARRANGEMENT SHOWN IN RED.

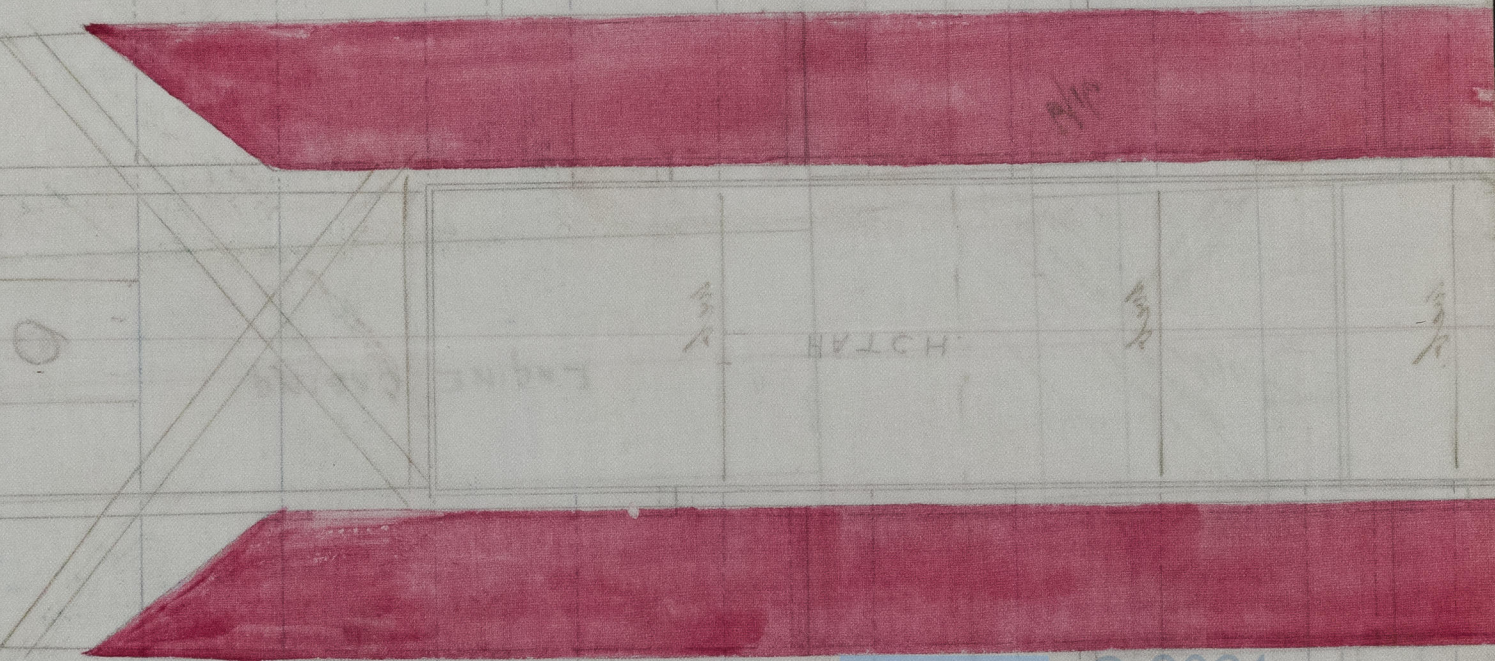

S.S. "Maggie" Glasgow Report No. 14246. —



© 2021

Lloyd's Register  
Foundation

6LS252-0145