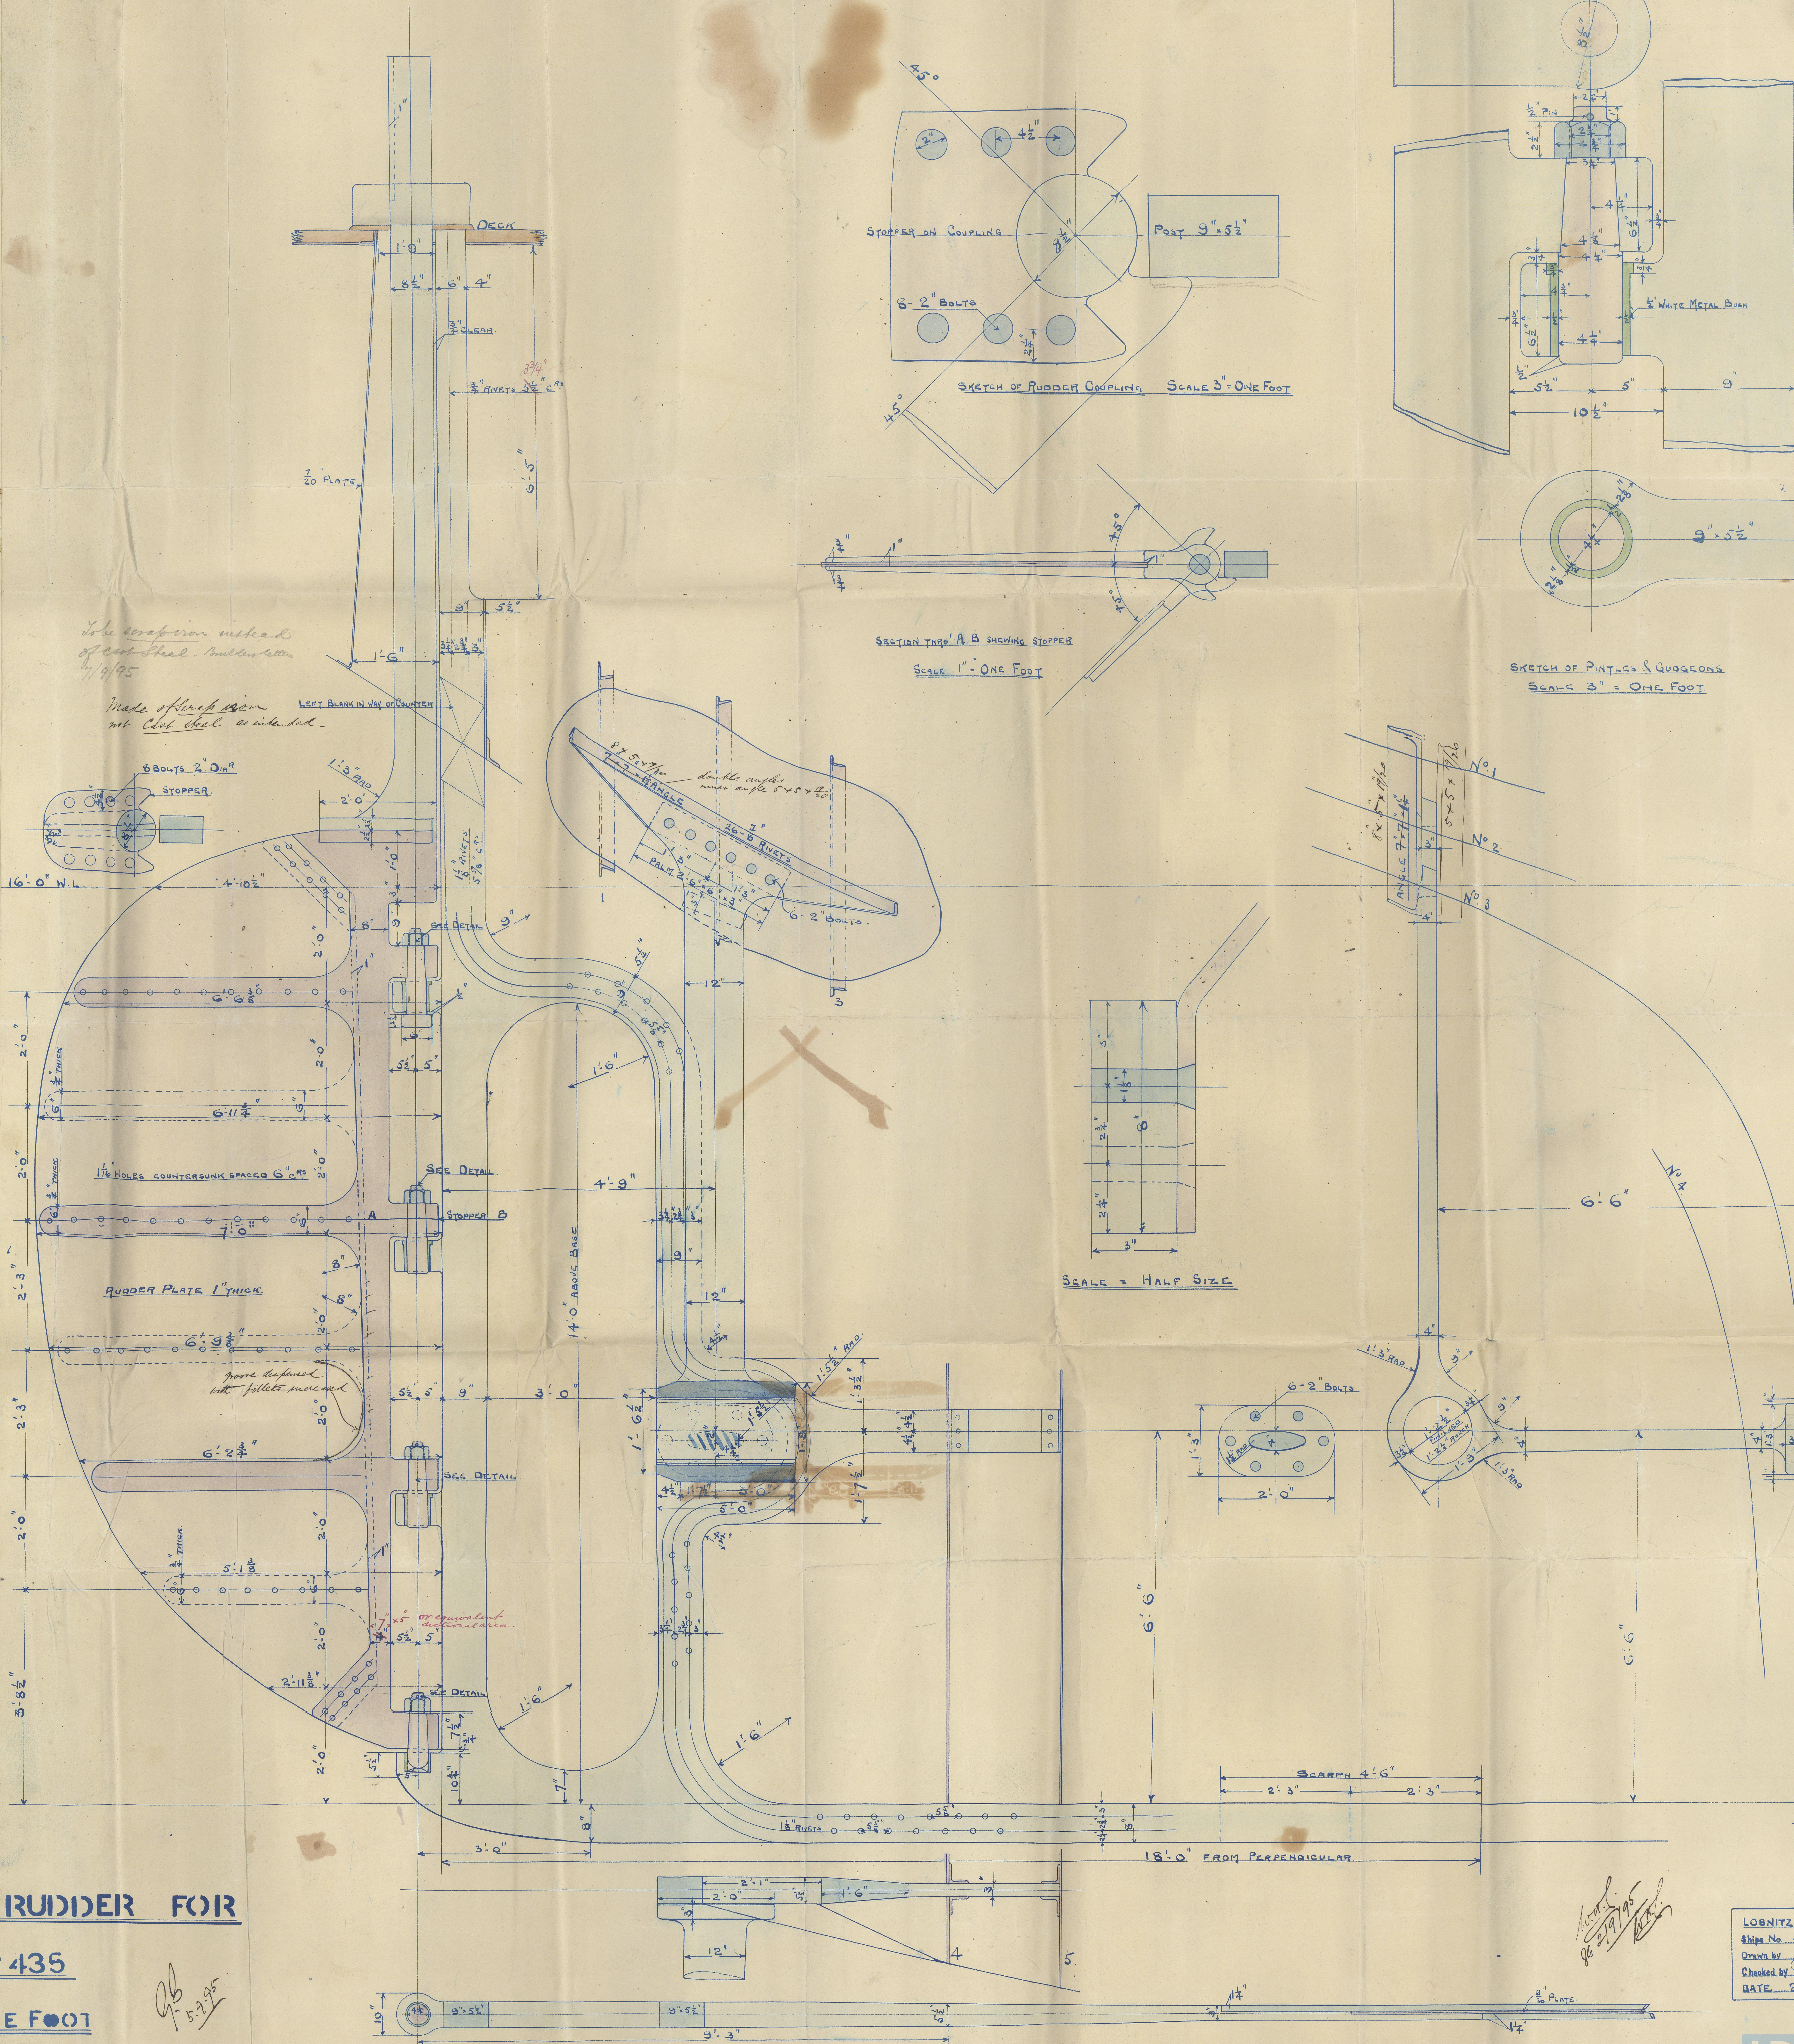


[illegible]

STERNPOST & RUIDDER FOR

S S N° 435


SCALE 1 ^{INCH} = ONE FOOT

LOBNITZ & Co., RENFREW
Ships No 435.
Drawn by J. Macdonald
Checked by *W. B.*
DATE 29th Aug 1895.

S.S. "Okinawa Maru" Glasgow Report 14333.-

*London
435-1*

*Stonington
Kendal*

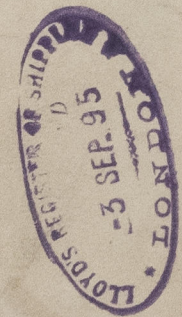

GLS253-0124