



| | FT | INS. |
|--------------------------|-----|-------------------------------|
| LENGTH ON 16'-0" W.L. | 290 | 0 |
| BREADTH MOULDED | 40 | 0 |
| DEPTH MOULDED TO MAIN DS | 16 | 8 $\frac{1}{2}$ $\frac{3}{4}$ |
| DEPTH MOULDED TO SPAR DS | 24 | 8 $\frac{7}{8}$ |

20: 8: 95.
2. 9. 95

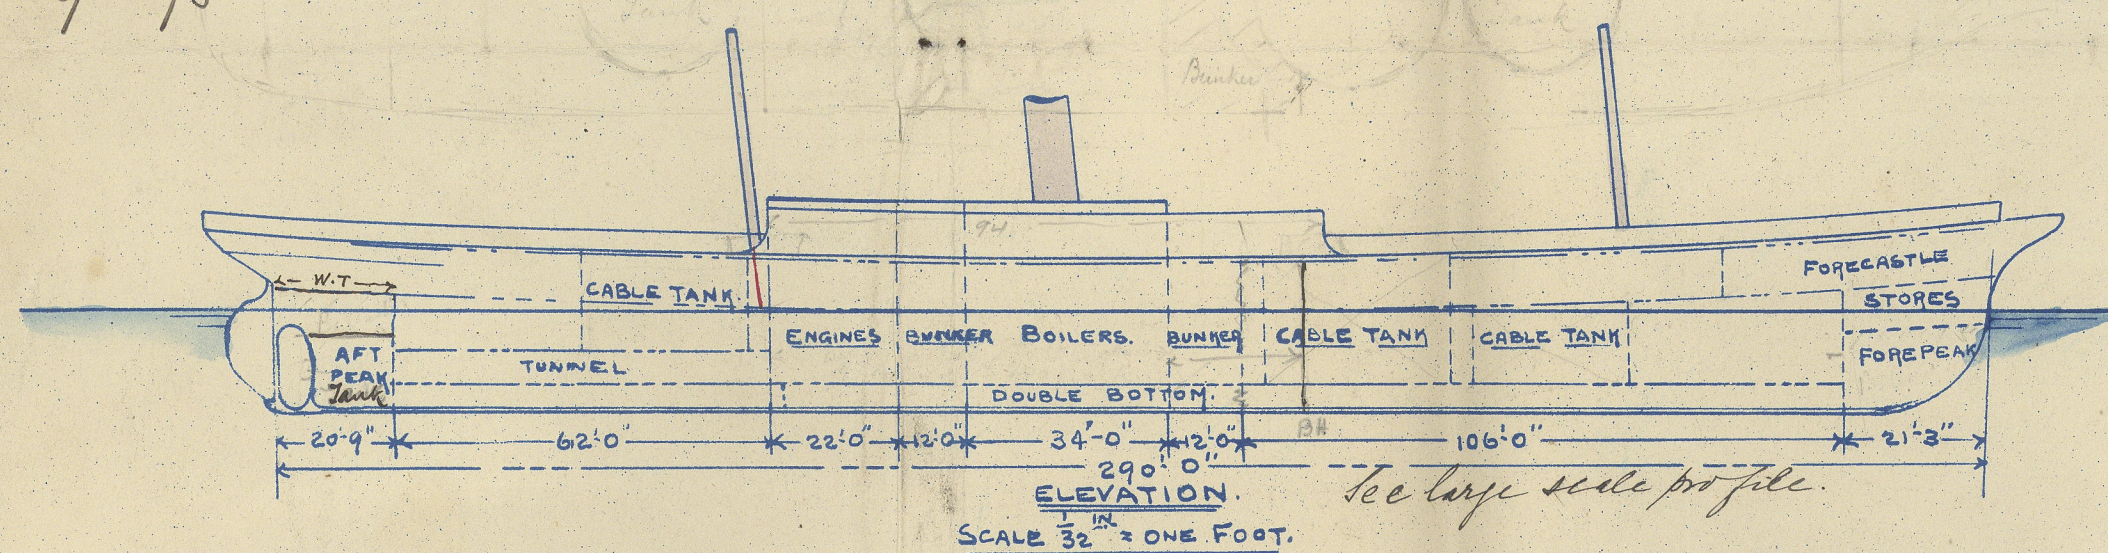





| | | | | | |
|------------------------|------------------|------------------|--|------------------|--------------|
| $\frac{1}{2}$ GIRTH | <u>33.27</u> | <u>33.28</u> | $\frac{1}{2}$ GIRTH TO SPAR D ^K | <u>41.27</u> | <u>38</u> |
| $\frac{1}{2}$ BREADTH | <u>20.00</u> | <u>20.00</u> | $\frac{1}{2}$ BREADTH | <u>20.00</u> | |
| DEPTH | <u>17.33</u> | <u>17.44</u> | DEPTH TO SPAR. D ^K | <u>25.33</u> | <u>44</u> |
| FRAMING N ⁴ | <u>70.6</u> | <u>70.82</u> | | <u>86.82</u> | |
| LENGTH | <u>290.6</u> | <u>290.6</u> | | <u>290.6</u> | |
| PLTQ. N ⁴ | <u>29,516.36</u> | <u>29,516.36</u> | EQUIPMENT N ⁴ | <u>251,659.6</u> | |
| | | <u>205.80</u> | | <u>261.6</u> | <u>29.75</u> |
| | | | | | IRON SPAR |

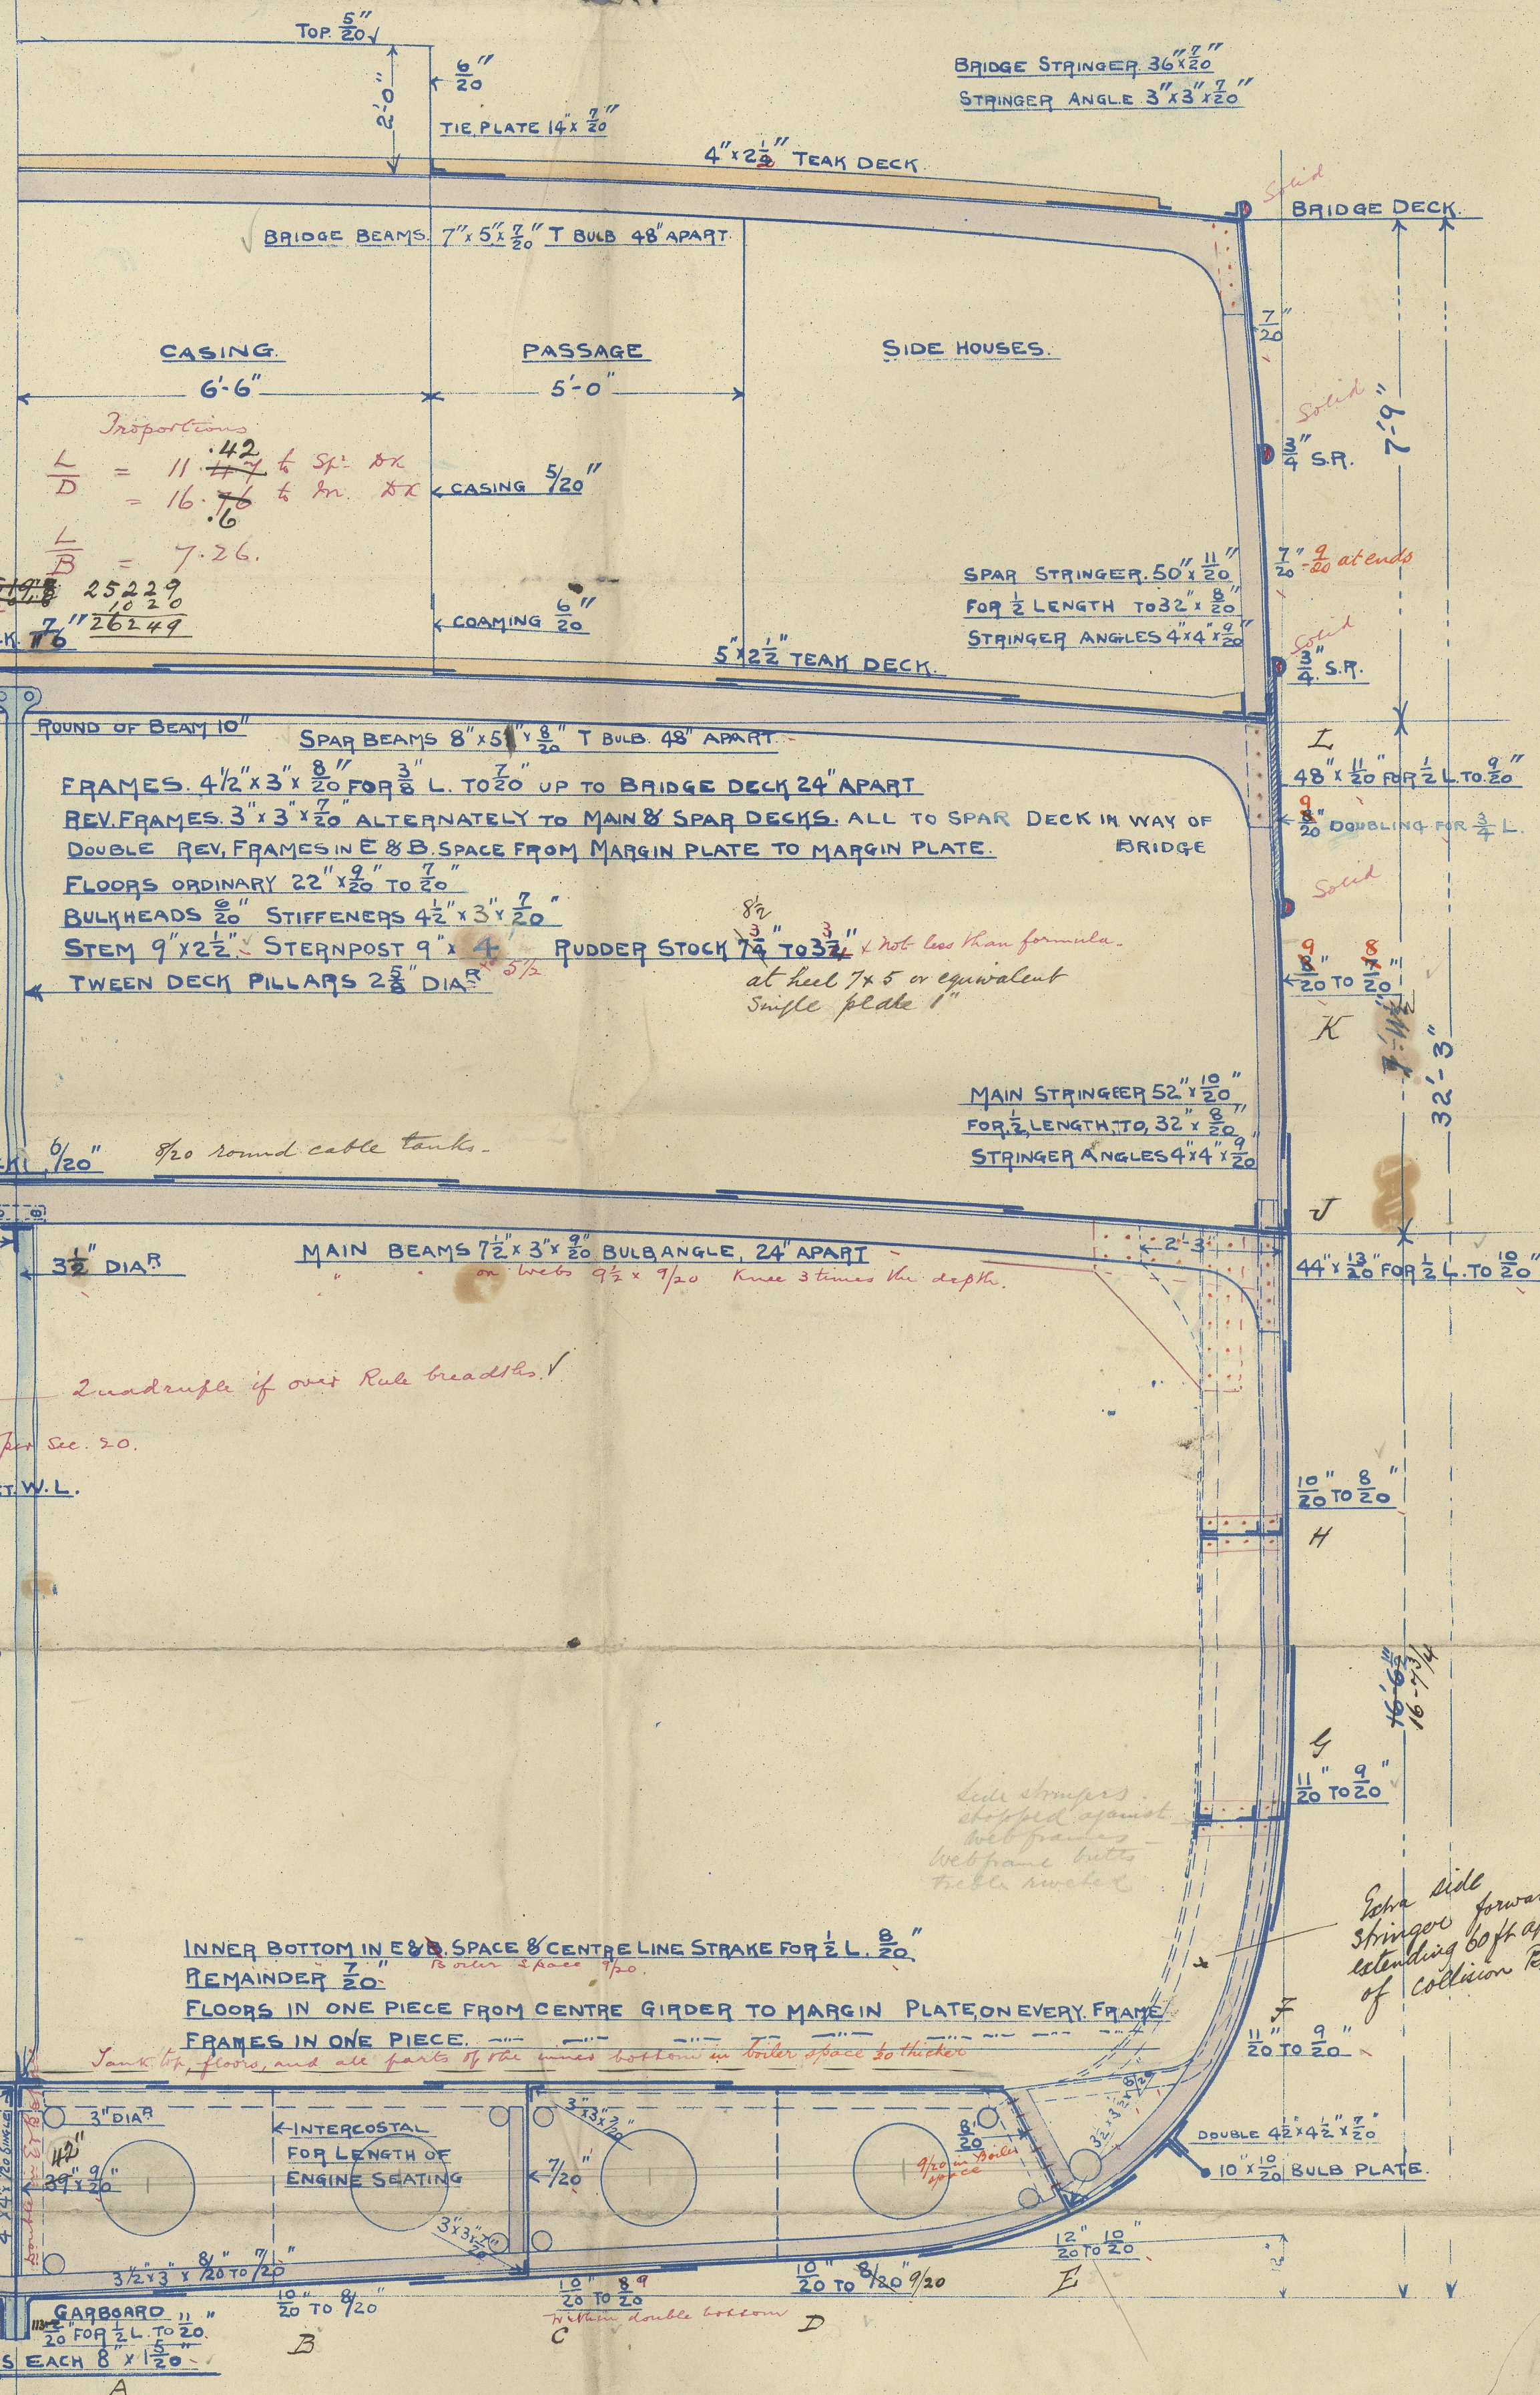

MIDSHIP SECTION OF TWIN SCREW CABLE STEAMER
N^o 435
SCALE $\frac{1}{2}$ IN = ONE FOOT

LOBNITZ & Co., RENFREW.
Ships No 425
Drawn by W. W. Hyatt.
Checked by Jas. B. Reid
DATE 15th August. 1895.

S. S. "Okinawa Maru" Glasgow Report No. 14333, -

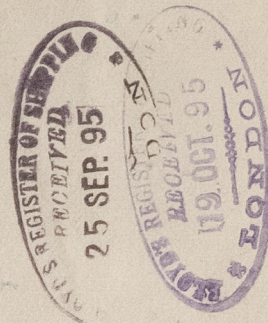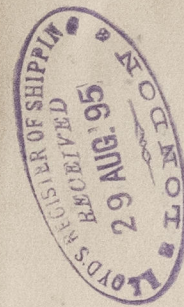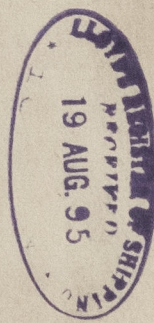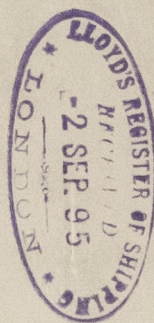

GLS253-0125



© 2021

Lloyd's Register
Foundation