

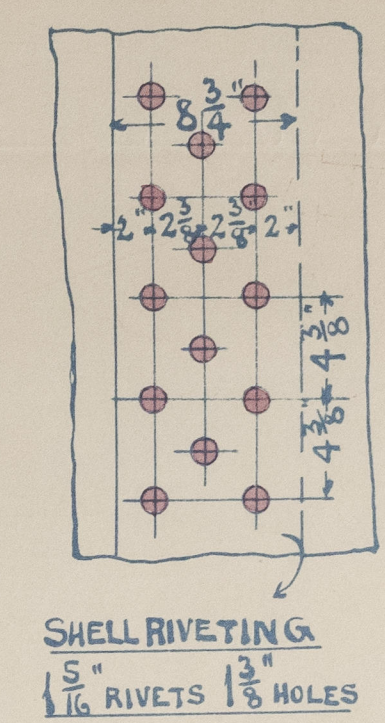
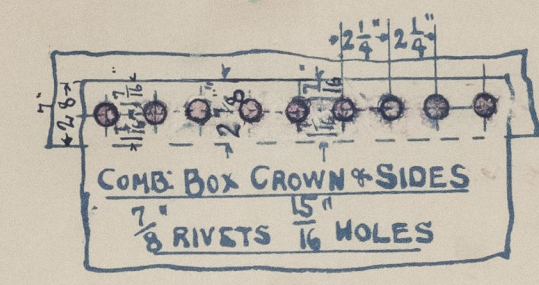
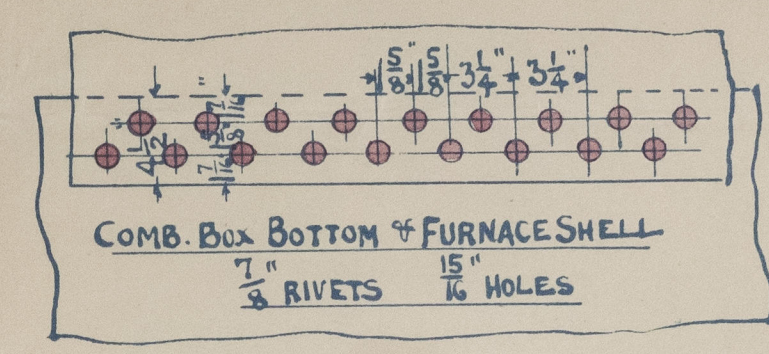
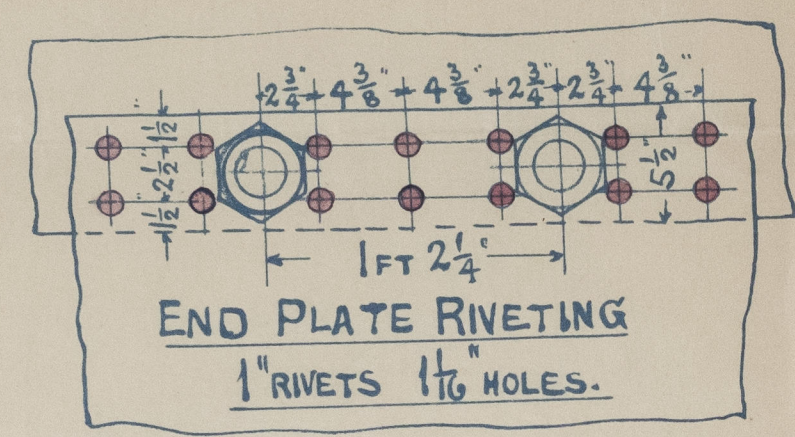
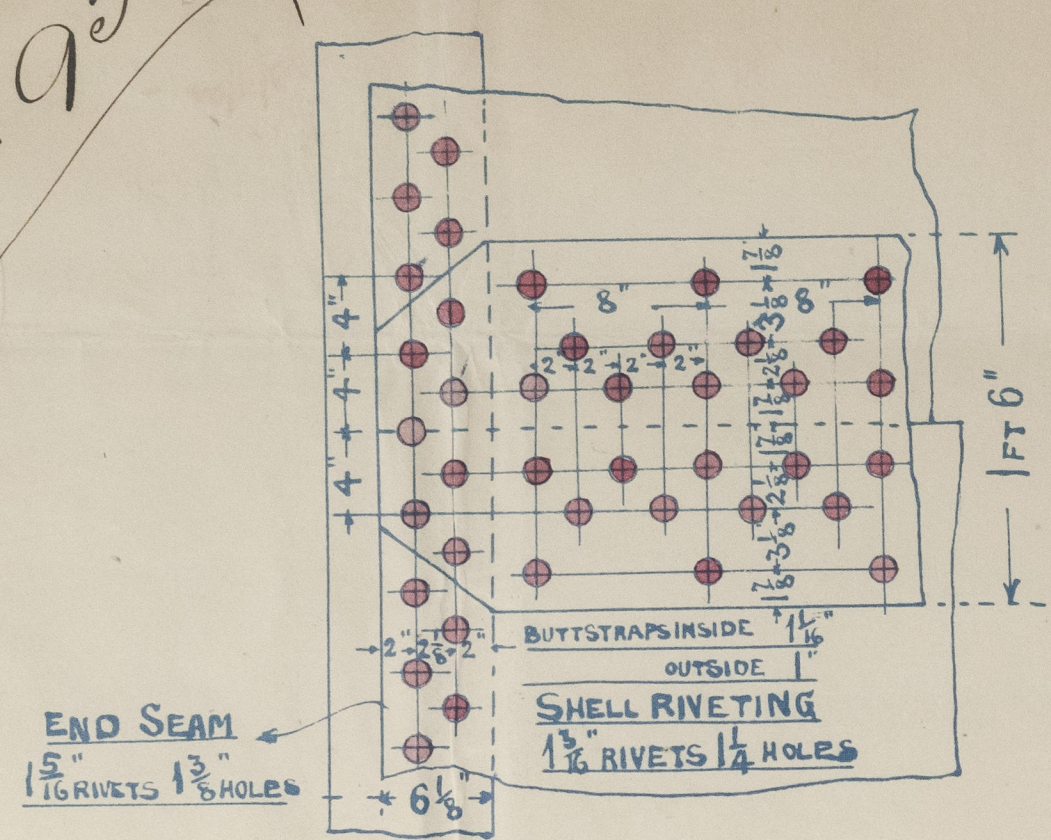


24.9.95

24.9.95

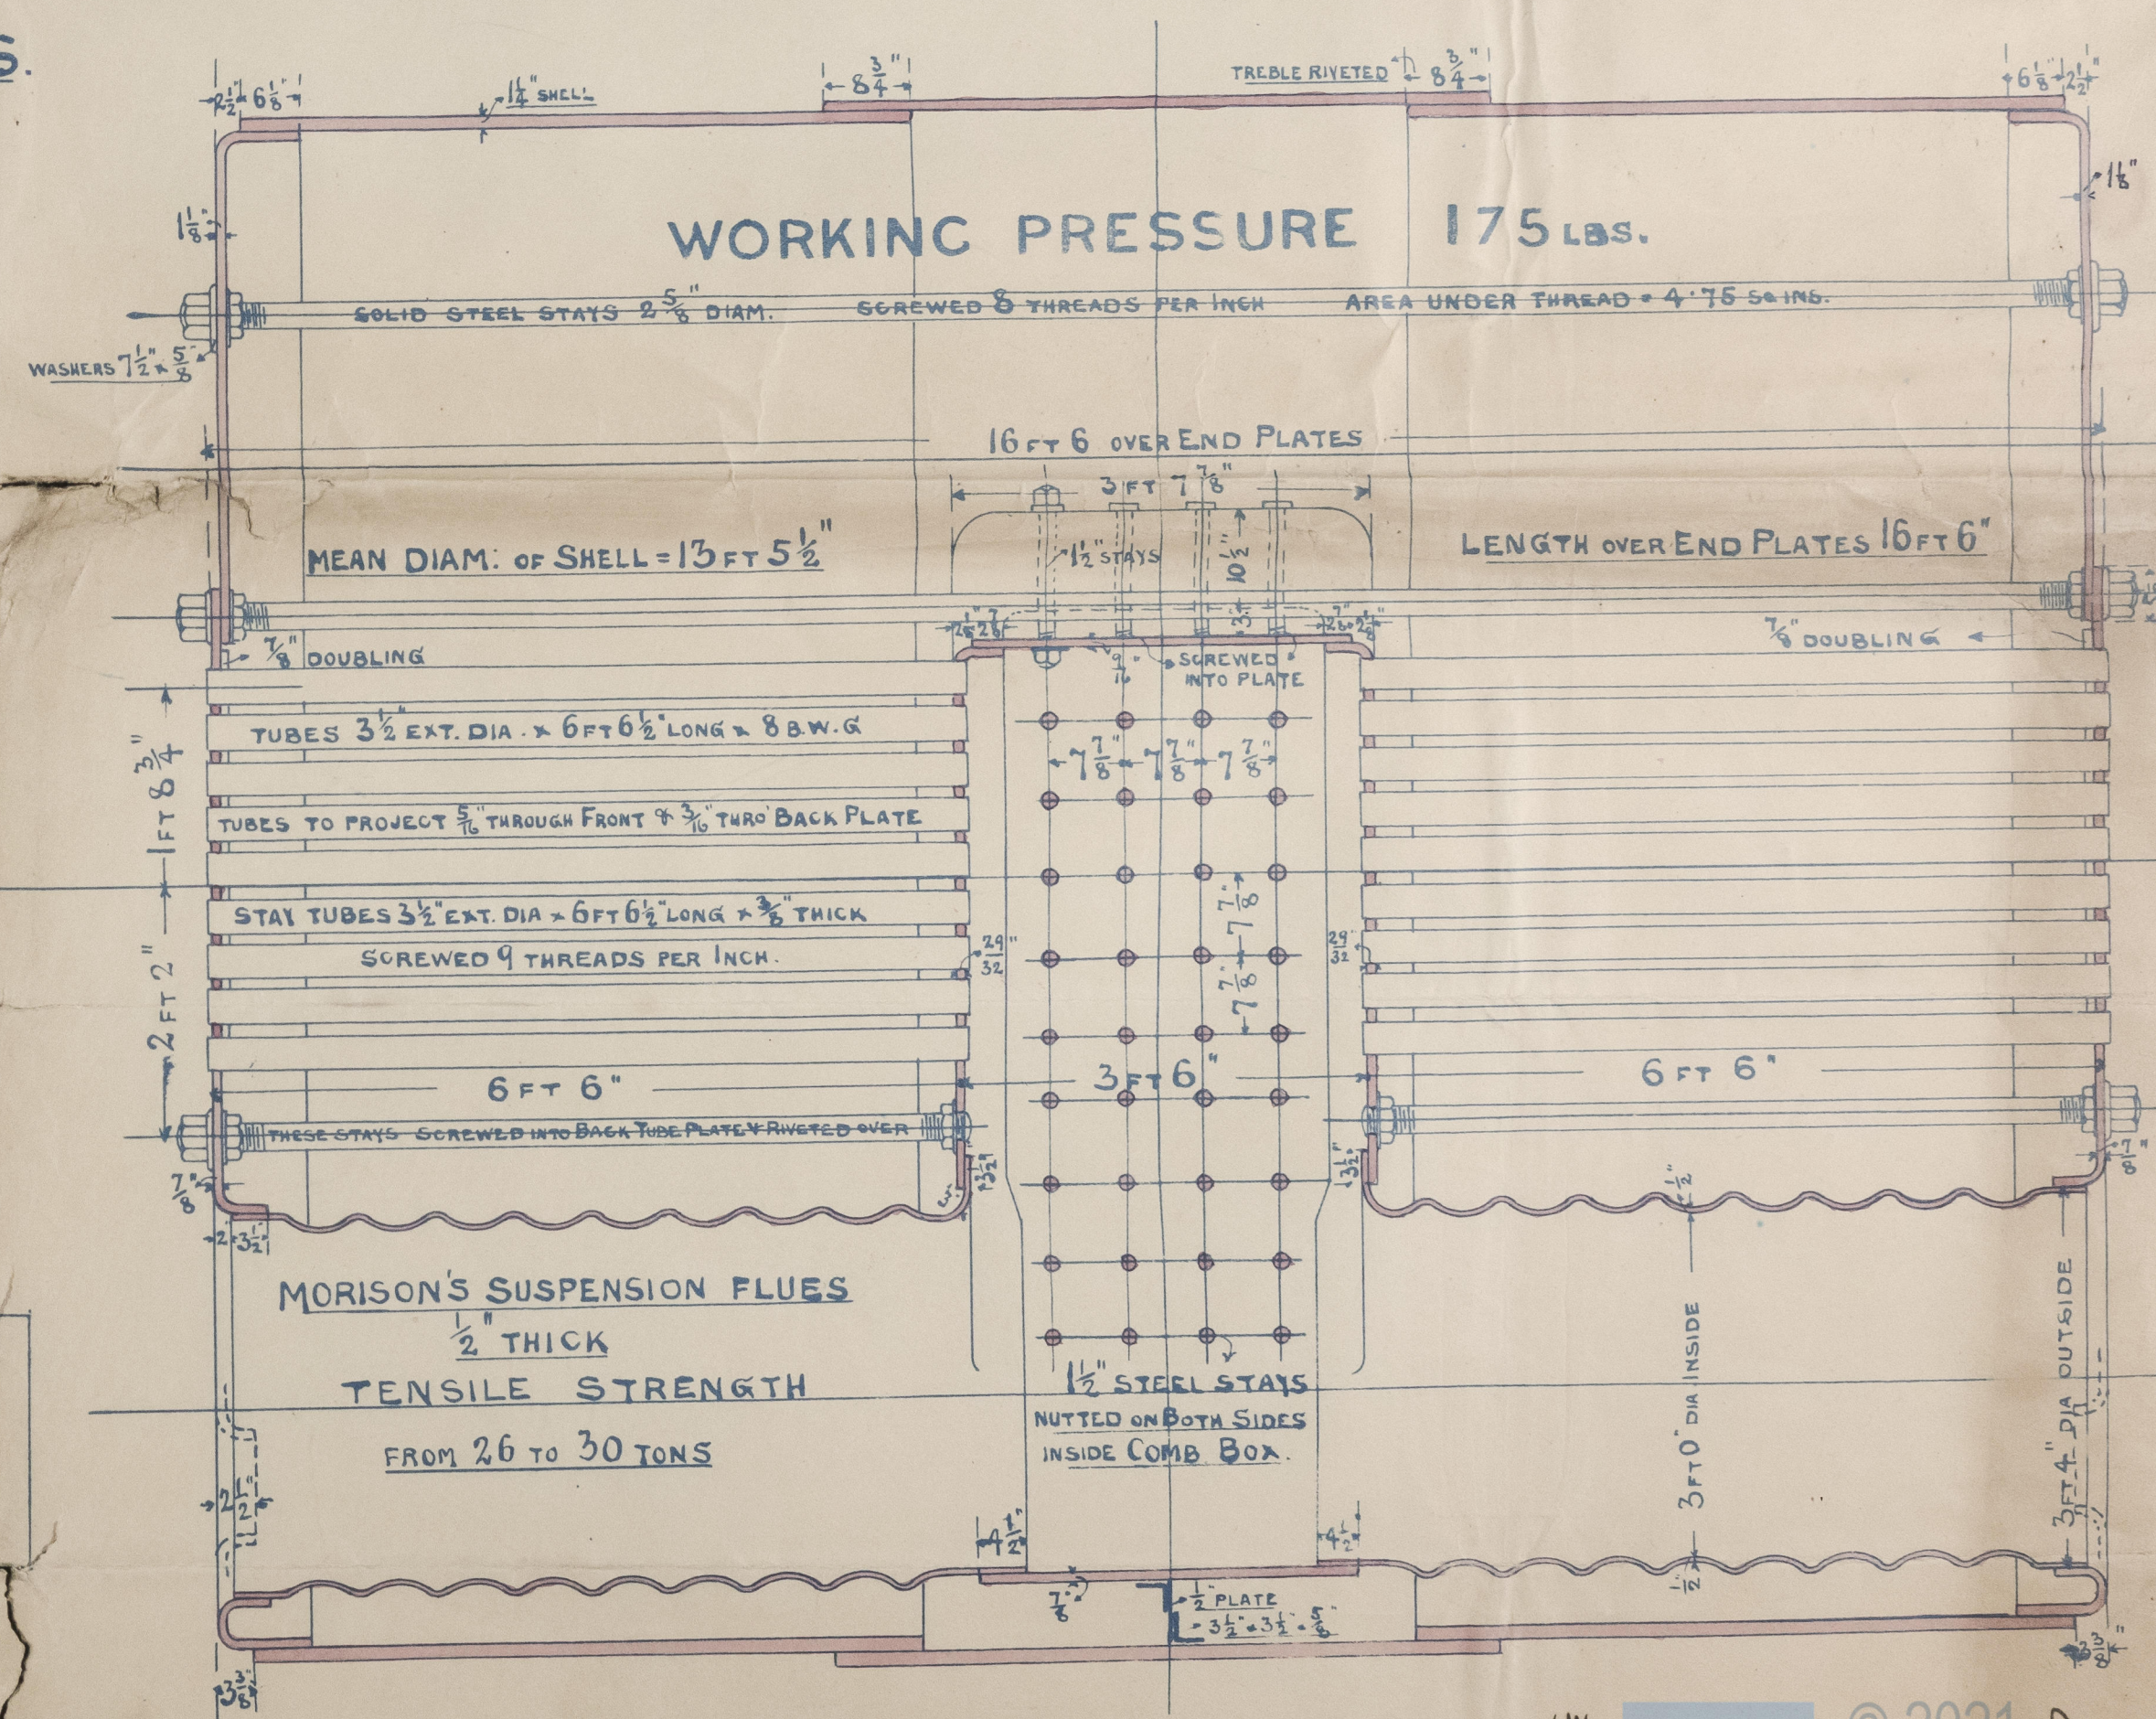

**LOBNITZ & CO.**  
ENGINEERS & SHIPBUILDERS.  
**RENFREW.**

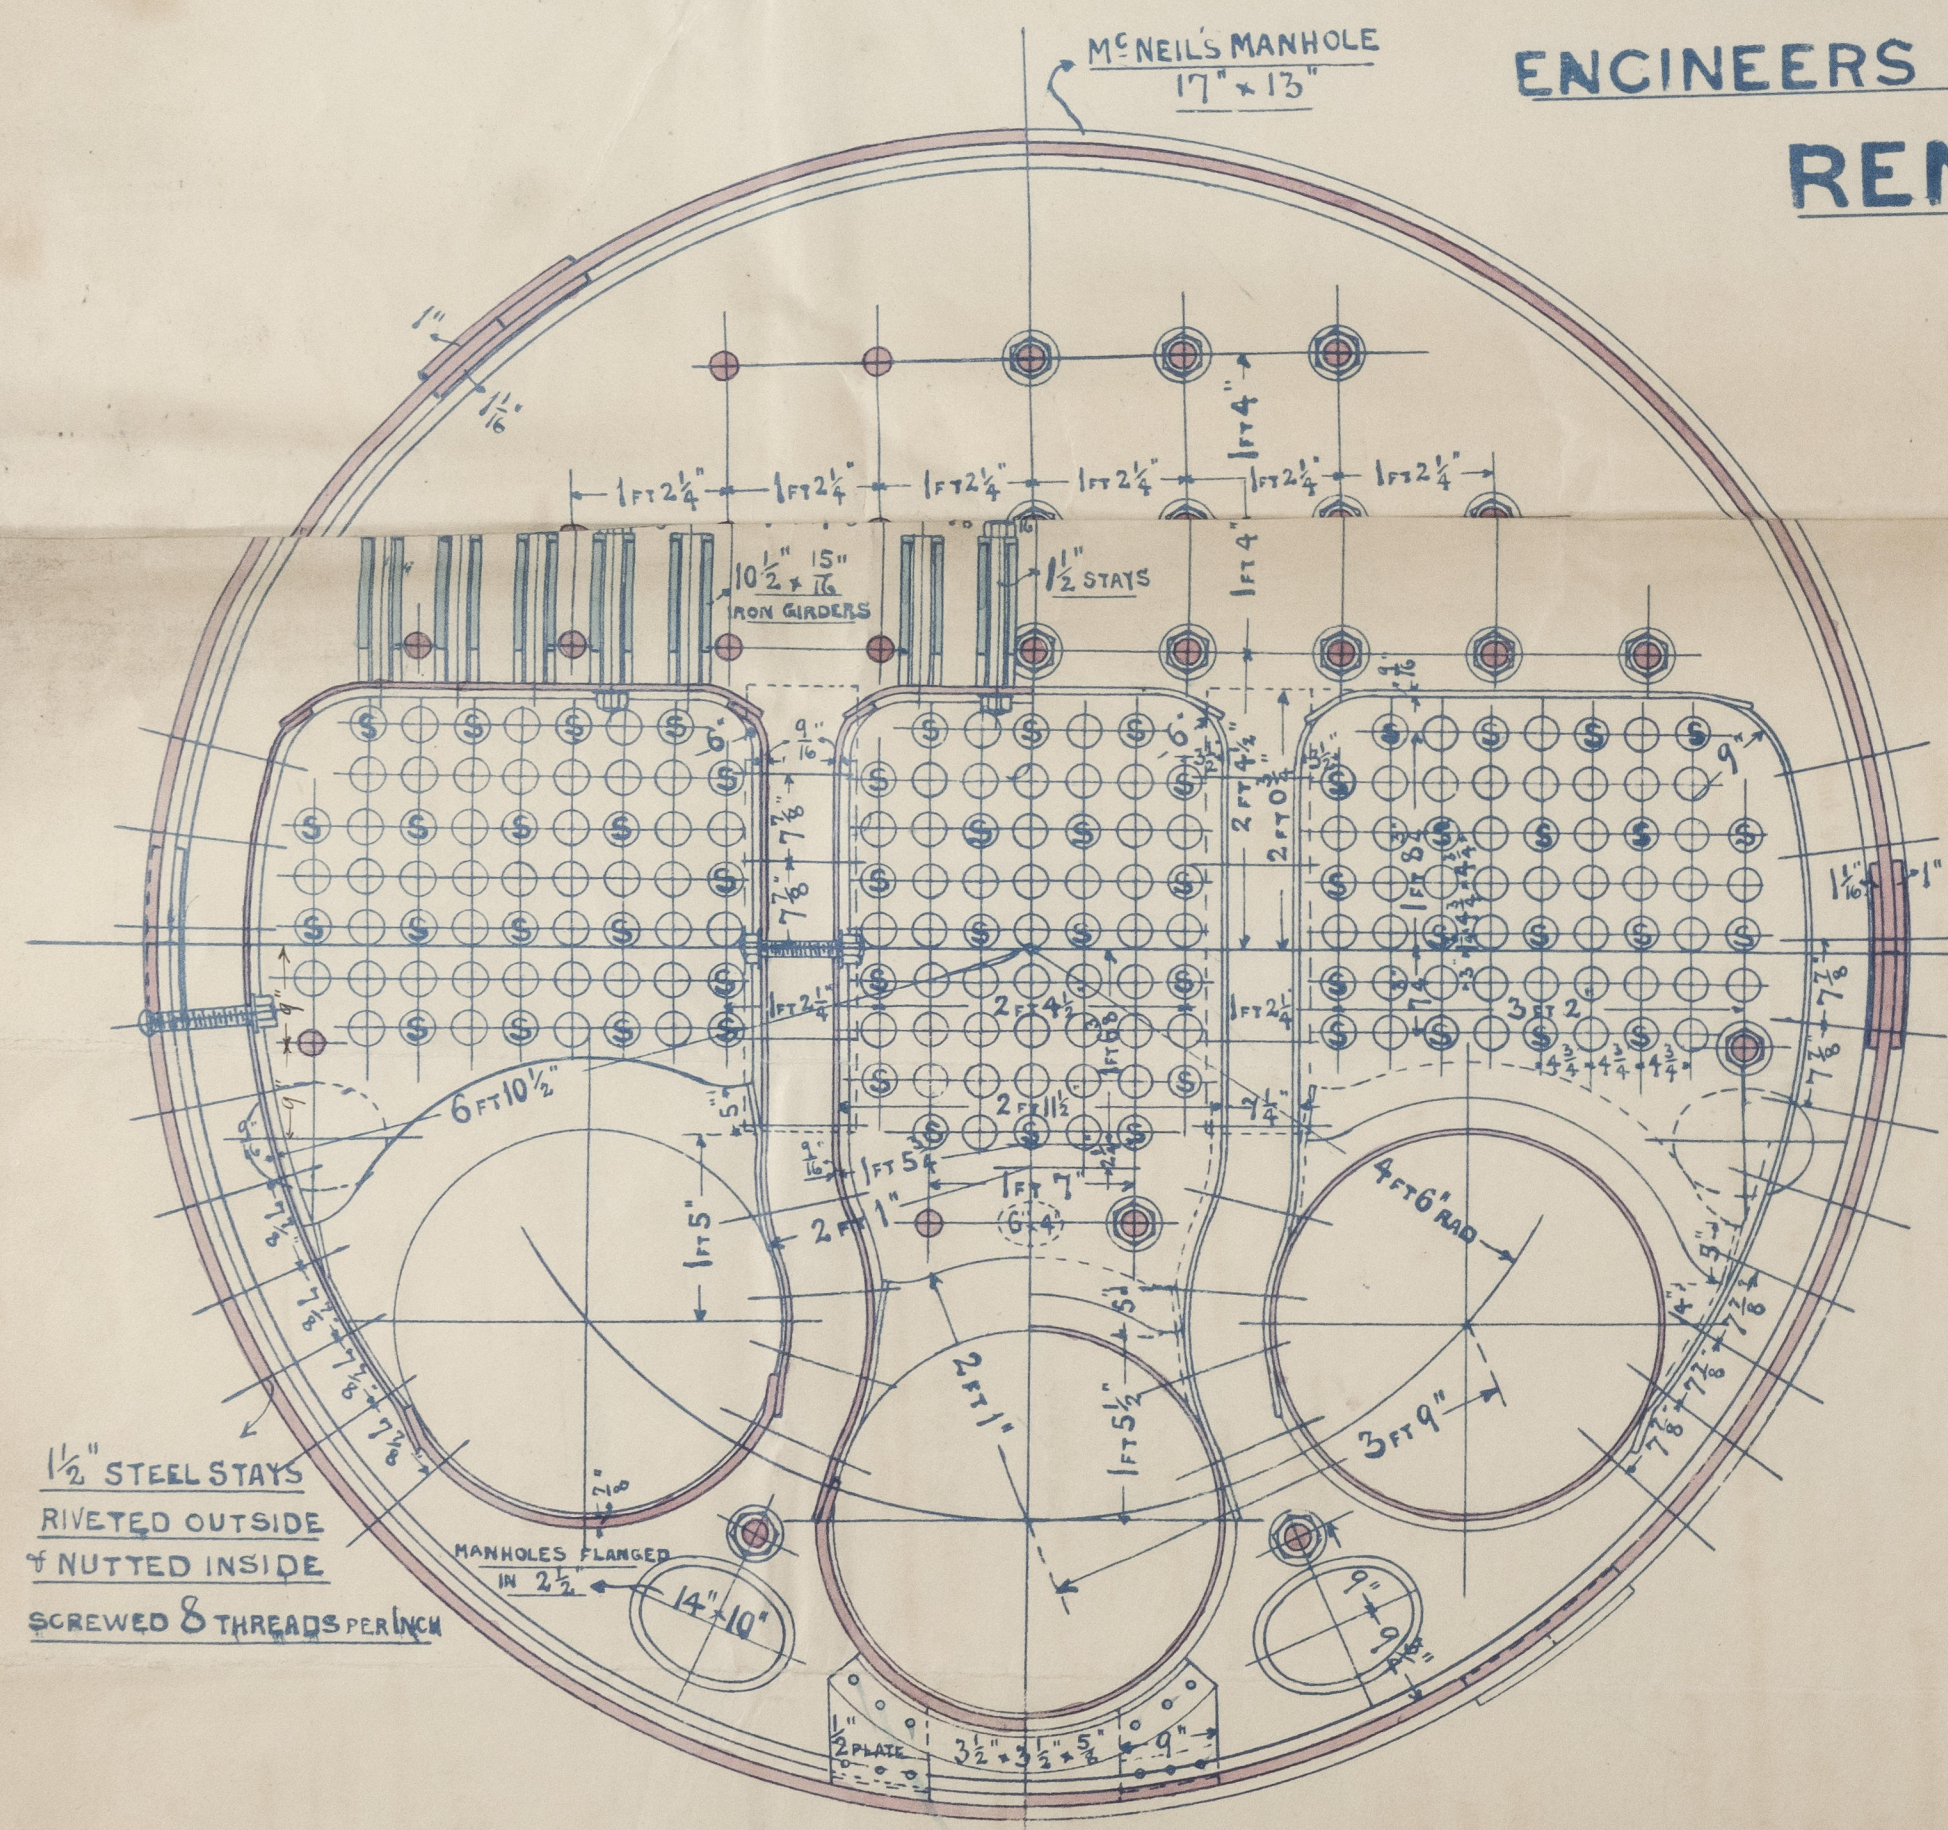

LOBNITZ & CO., RENFREW  
BOILER No. 435  
Drawn by *A. J.*  
Checked by *E. J.*  
DATE 17<sup>th</sup> September 1895

**LLOYDS PLAN**

**MAIN BOILER N° 435**

**SCALE 3/4" ONE FOOT**



Boiler  
S.S. "Okinaawa Maru" Glasgow Report No. 4335

Voluntary  
J. Leo

