

Lloyd's Register of British and Foreign Shipping.

(Report on Vessel No. 14333 Port Glasgow)Okinawa MaruNo. 5052 SHIP FORGINGS OR CASTINGS.

I have to report that the undermentioned Iron or Steel Forgings or Castings, manufactured by The Hennytown Forge Co. of Lumberton for the Vessel No. 435, being built by Messrs. Lobnitz & Co. of Renfrew have been inspected by me as set forth below, and found to be, so far as can be seen, Sound.


Mark on Forgings.

Lloyd's

No. 5052FCFrank CookGlasgow 23/10/95

	STERN FRAME.	RUDDER FRAME.	STEM.
Material*	<u>Scrap Iron</u>		<u>Scrap Iron</u>
How made	<u>Forged</u>		<u>Forged</u>
Dimensions	<u>9 x 5 1/2</u>		<u>10 x 8</u>
Progress on Inspection	<u>Forged & smithed</u>		<u>Forged & smithed</u>
Date when Inspected	<u>10/9/95 to 9/10/95</u>		<u>9.18.22/10/95</u>

SKETCHES OF FRAMES SHOWING POSITION AND DESCRIPTION OF WELDS OF FORGINGS, OR PARTICULARS OF TESTS APPLIED TO CASTINGS.

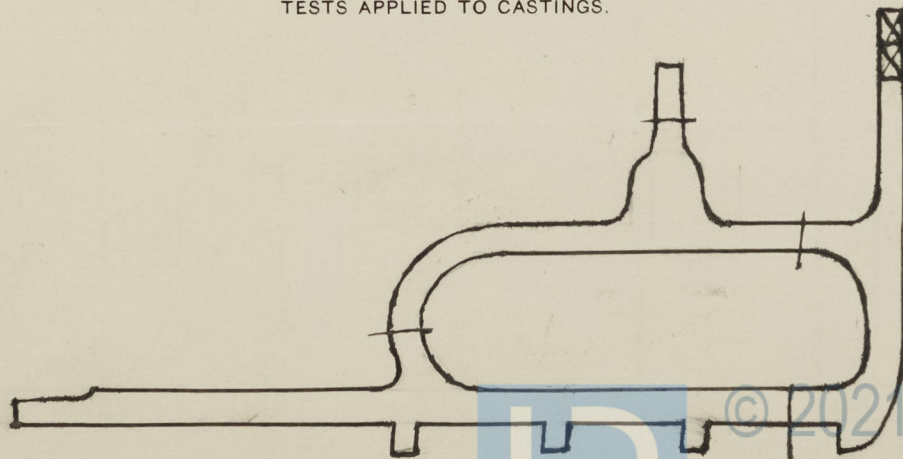

Fee (if any chargeable) £

To be paid at

Flat Welds

* If of Iron, state whether scrap or puddled Iron.

No 435

Steufrance
&
Steufrance



© 2021

Lloyd's Register
Foundation