
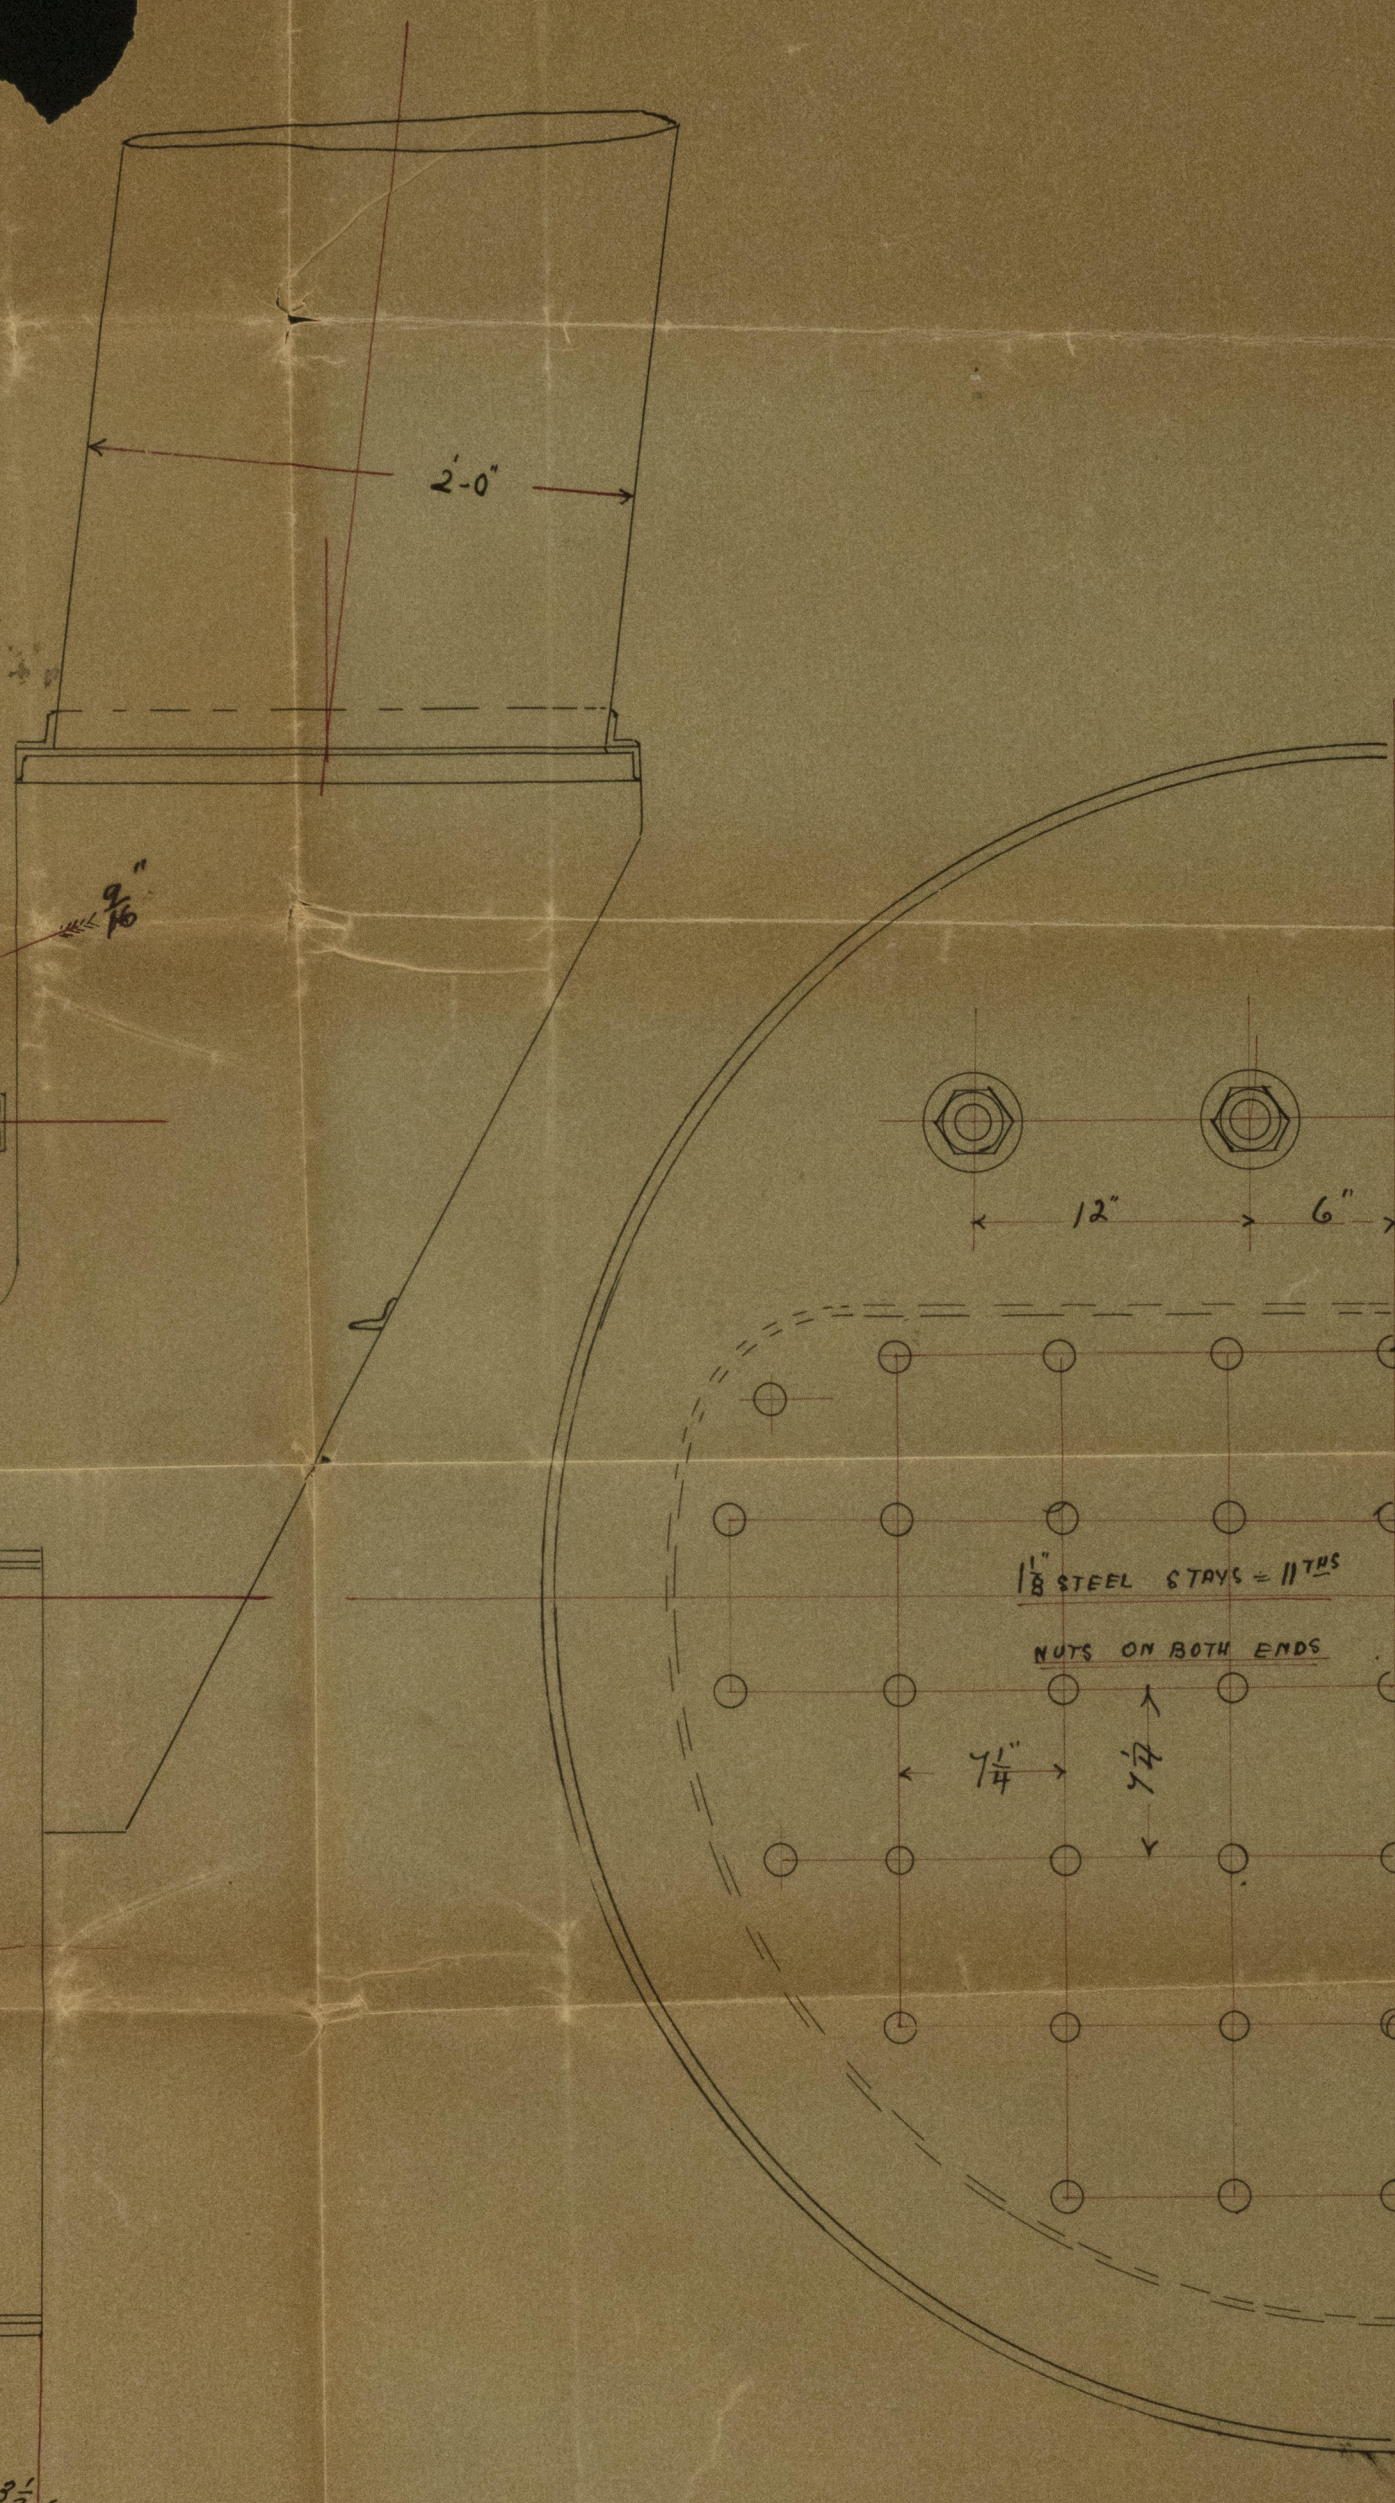
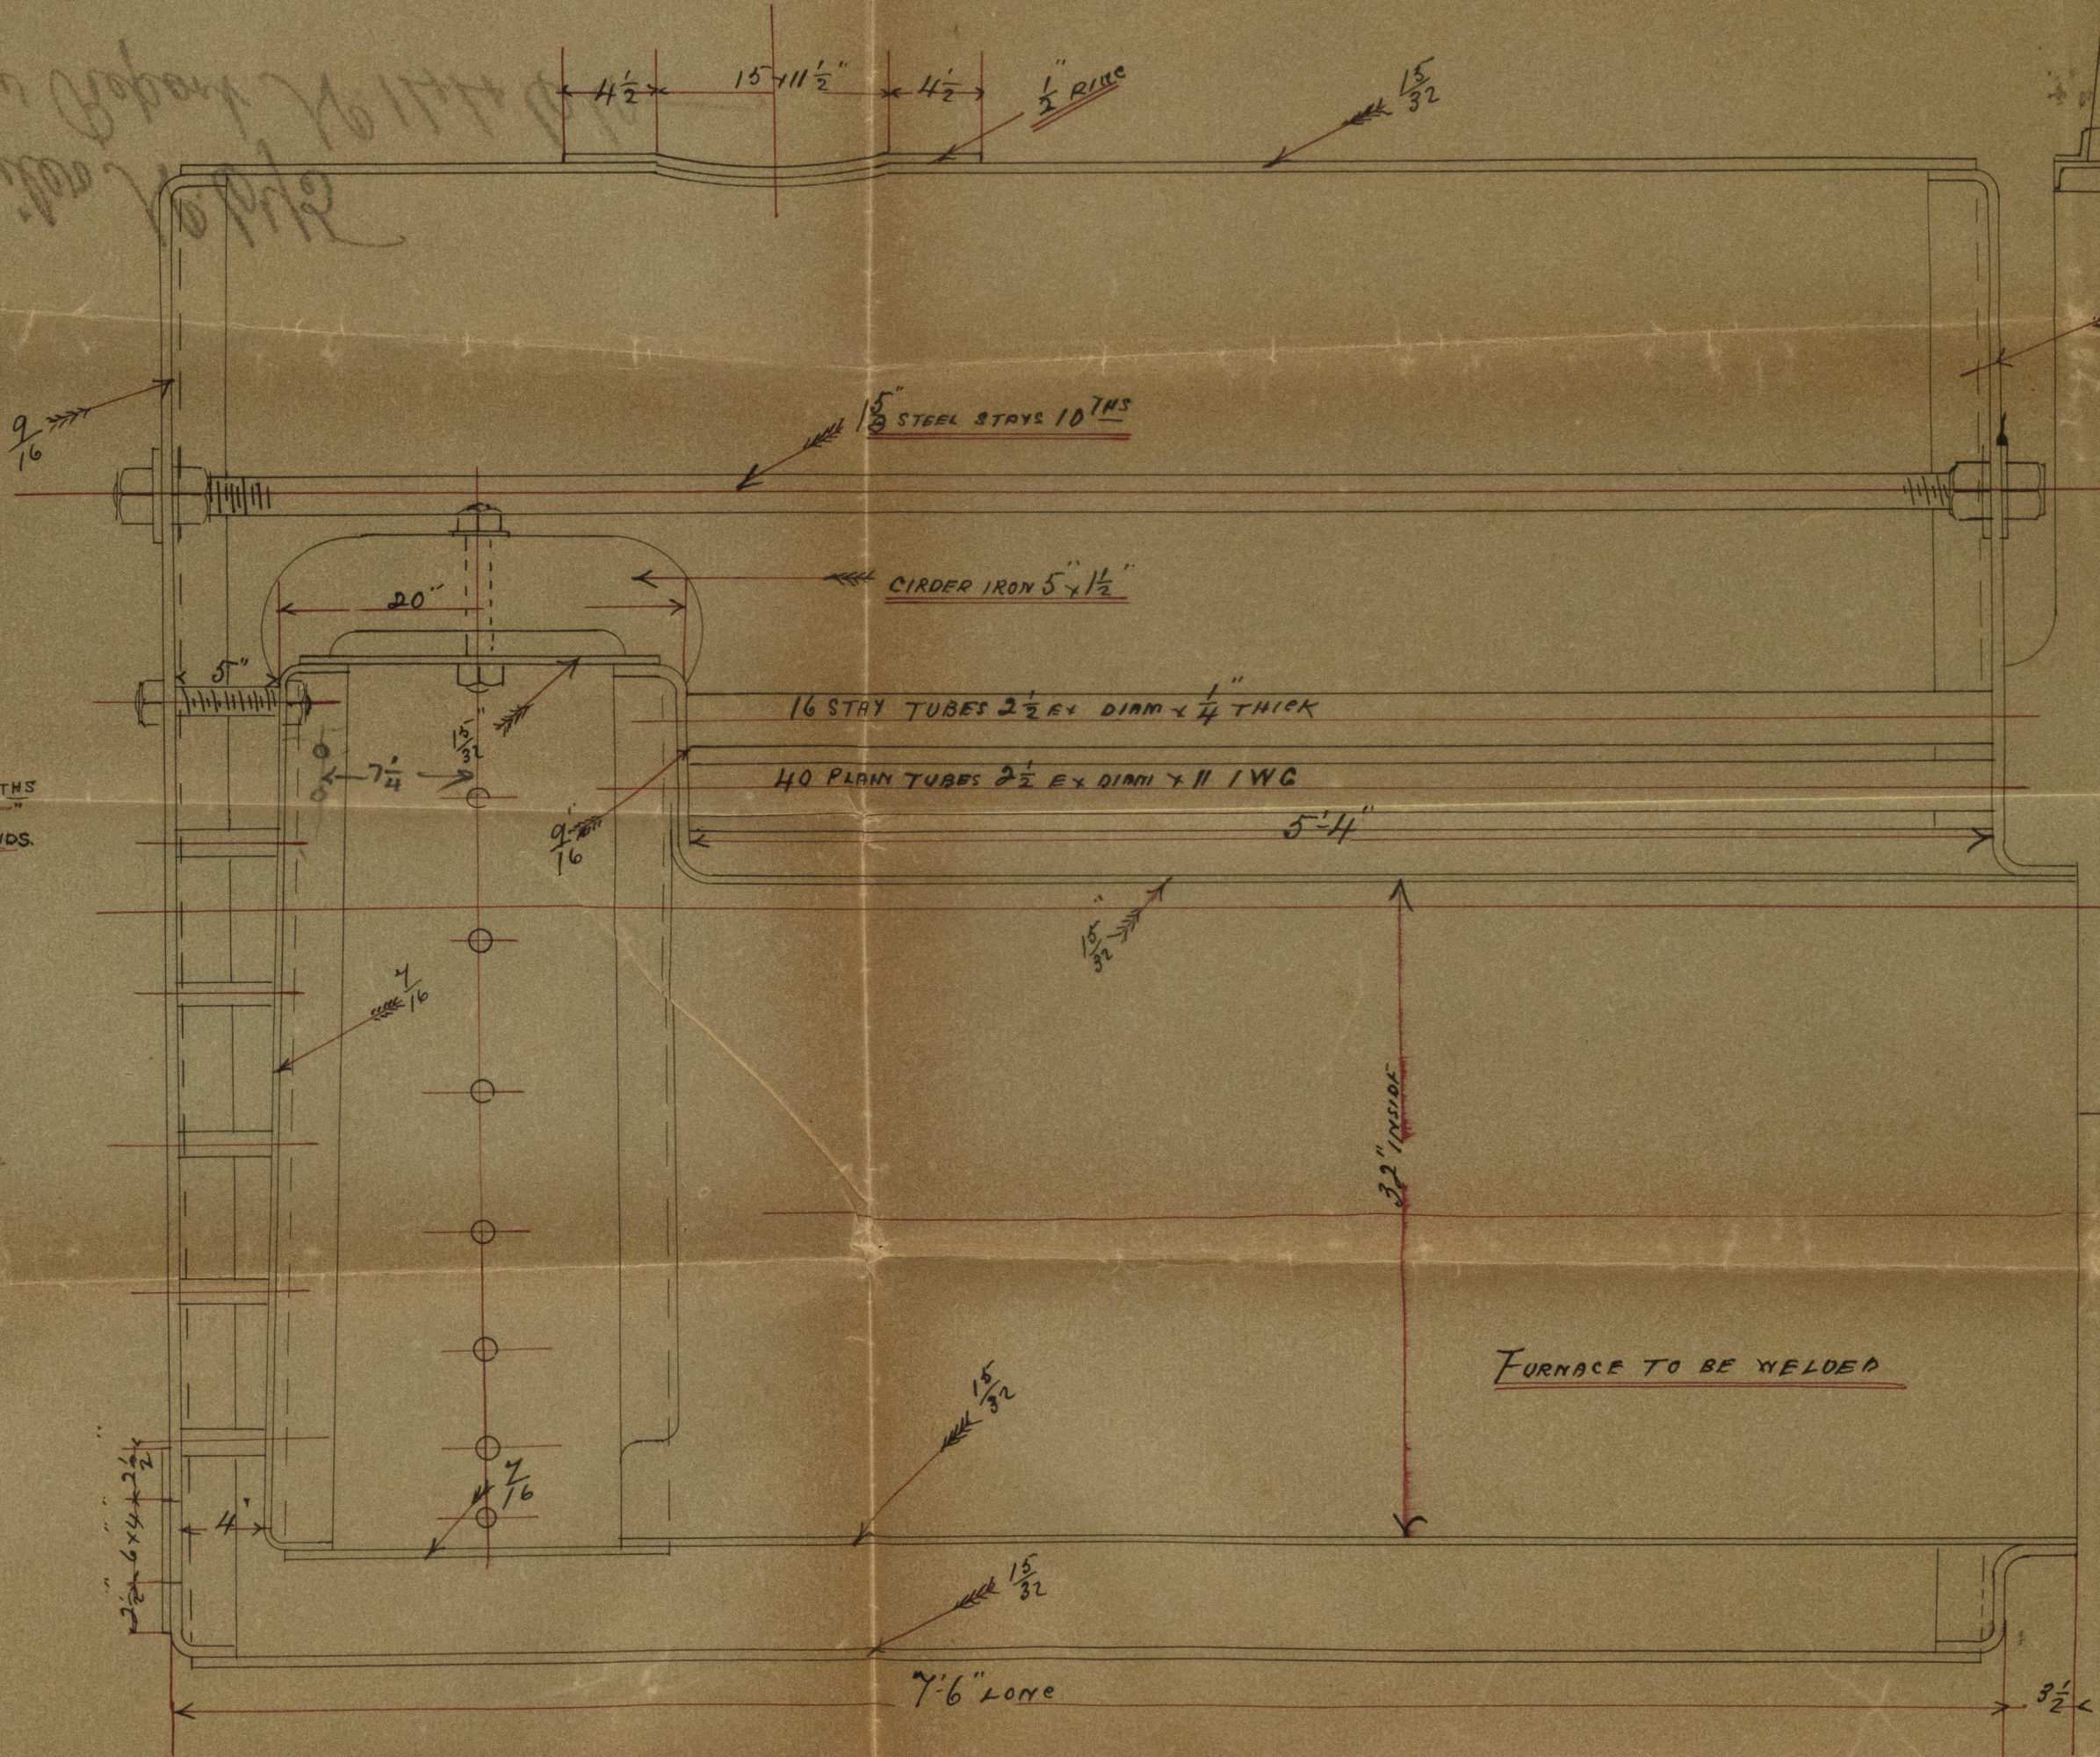
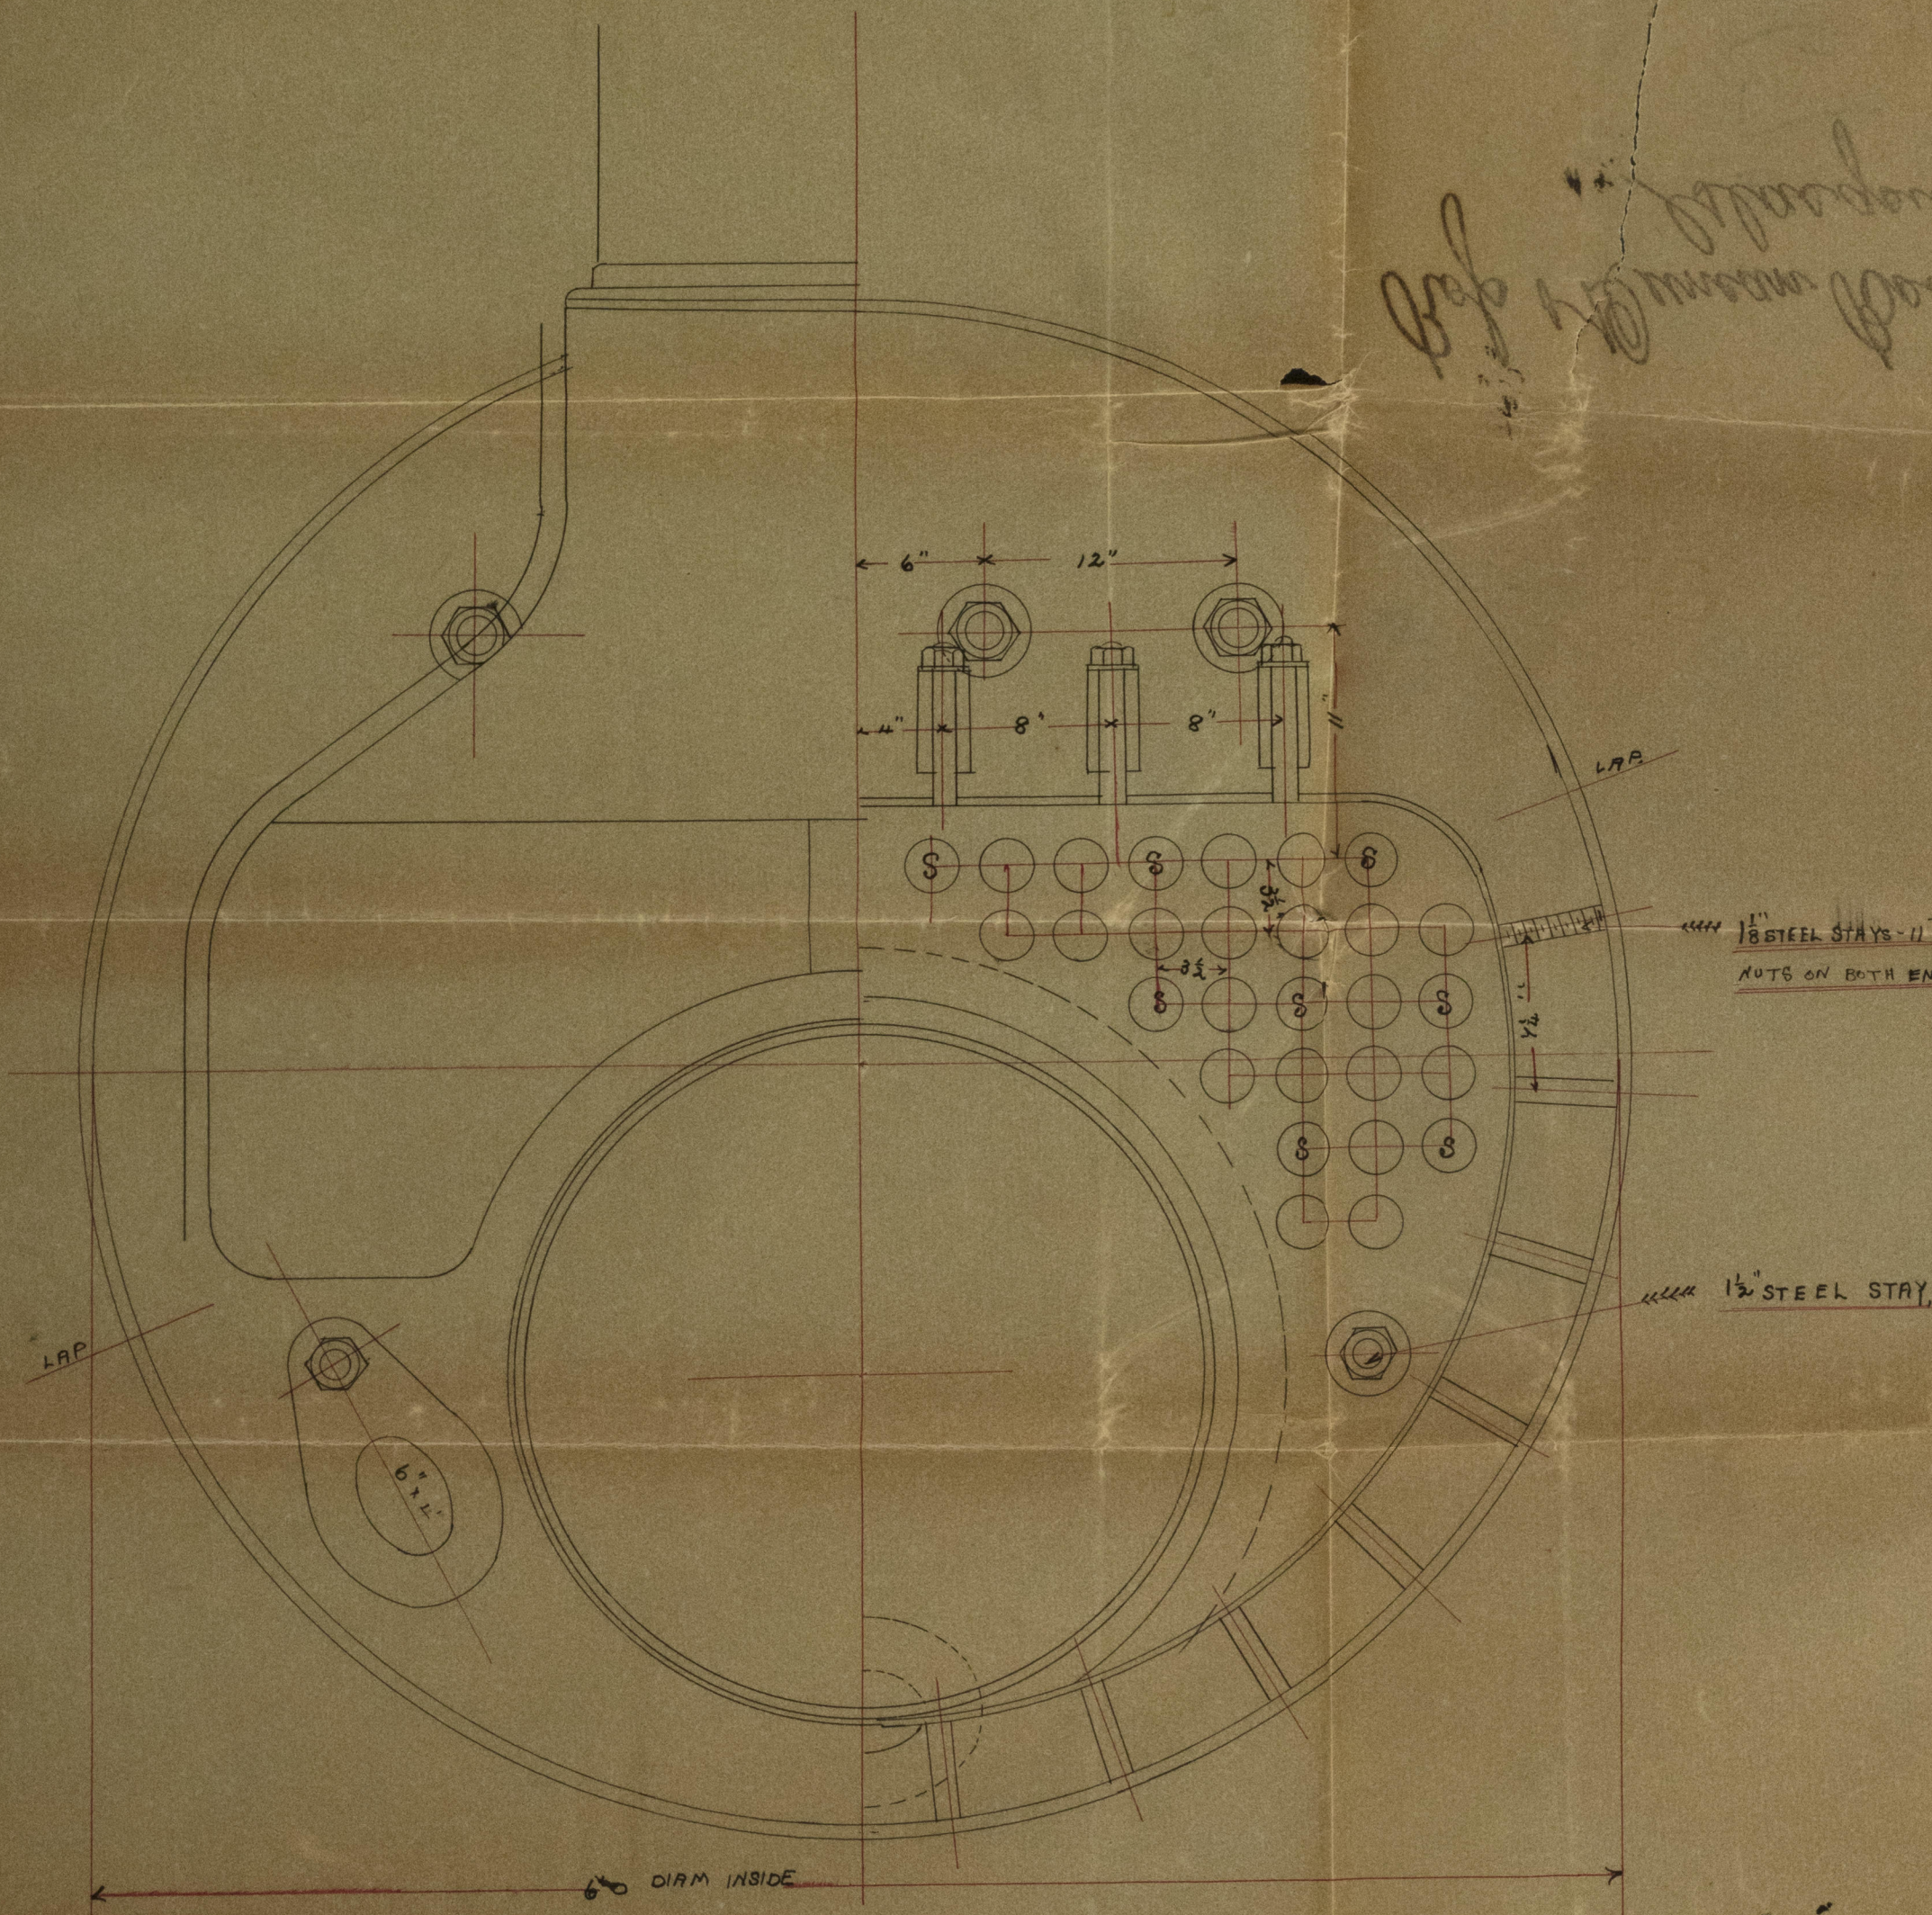


Copy of print
ap. 2 days later 14.8.95
for No. 652
M. Rep 14.04.96

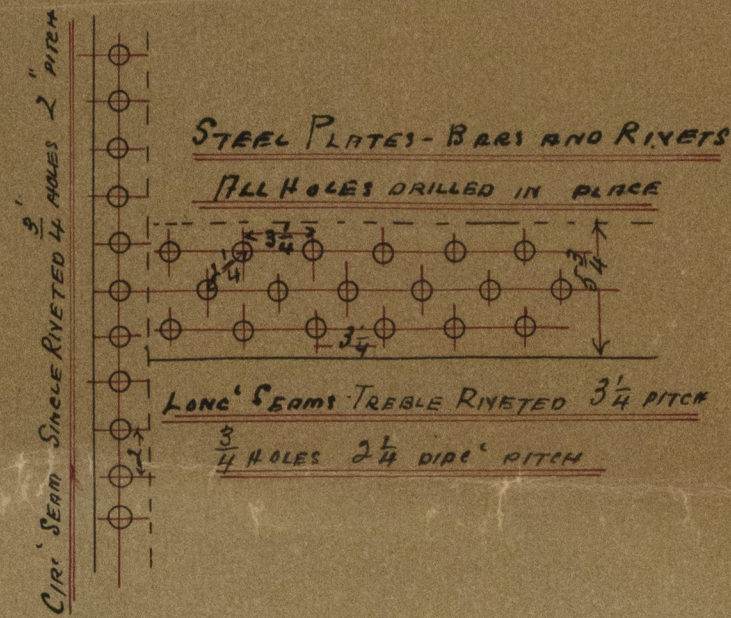



BOILER N° 675

WORKING PRESSURE = 100 LBS PER SQ IN

SCALE 1 1/2 INS = 1 FOOT

TO HAVE LLOYDS CERTIFICATE

Fire grate Area 11.3 sq ft
Heating surface 233 sq ft

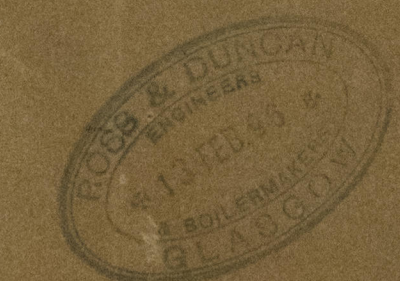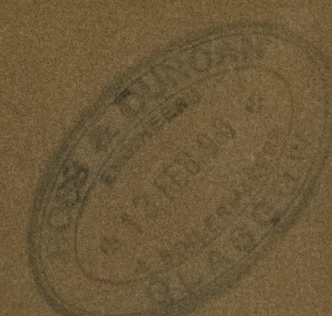

GLS255-0001



© 2021
Lloyd's Register
Foundation

Rep of Duncan Boiler N^o. 645
Glasgow Report N^o. 1446

17

GLS255-0001



© 2021

Lloyd's Register
Foundation