

Lloyd's Register of British and Foreign Shipping.

(Report on Vessel No. 14407 Port Glasgow)

"Countess"

No. 5159 SHIP FORGINGS OR CASTINGS

The words FORGINGS or CASTINGS, IRON or STEEL, should be struck out as may be required.

I have to report that the undermentioned Iron or Steel Forgings or Castings, manufactured by The Irvine Forge Coy of Irvine for the Vessel No. 107, being built by Messrs Macchie & Thomson of Glasgow have been inspected by me as set forth below, and found to be, so far as can be seen, Sound & efficient

Mark on Forgings.

Lloyd's


No. 5159

W H

William Hamilton
Glasgow

	STERN FRAME.	RUDDER FRAME.	STEM.
Material*	<u>Scrap iron</u>		<u>Scrap iron</u>
How made	<u>Forged</u>		<u>Forged</u>
Dimensions	<u>6 1/2 + 3 3/4</u>		<u>6 1/2 x 1 7/8</u>
Progress on Inspection	<u>Forging & smithing</u>		<u>Forging</u>
Date when Inspected	<u>6 to 27/12/95</u>		<u>6/1/96</u>

SKETCHES OF FRAMES SHOWING POSITION AND DESCRIPTION OF WELDS OF FORGINGS, OR PARTICULARS OF TESTS APPLIED TO CASTINGS.

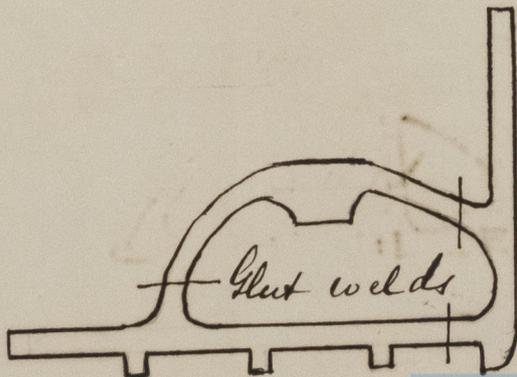

Fee (if any chargeable) £ : :

To be paid at _____

* If of Iron, state whether scrap or puddled Iron.



No 107

Stemframe
& Steer

[Faint handwritten notes]



2112

[Vertical handwritten notes]

[Vertical handwritten notes]

[Vertical handwritten notes]

[Vertical handwritten notes]

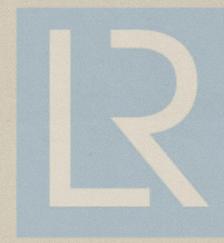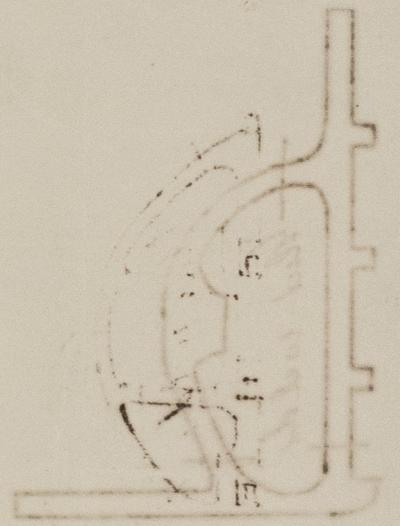

© 2021
Lloyd's Register
Foundation